



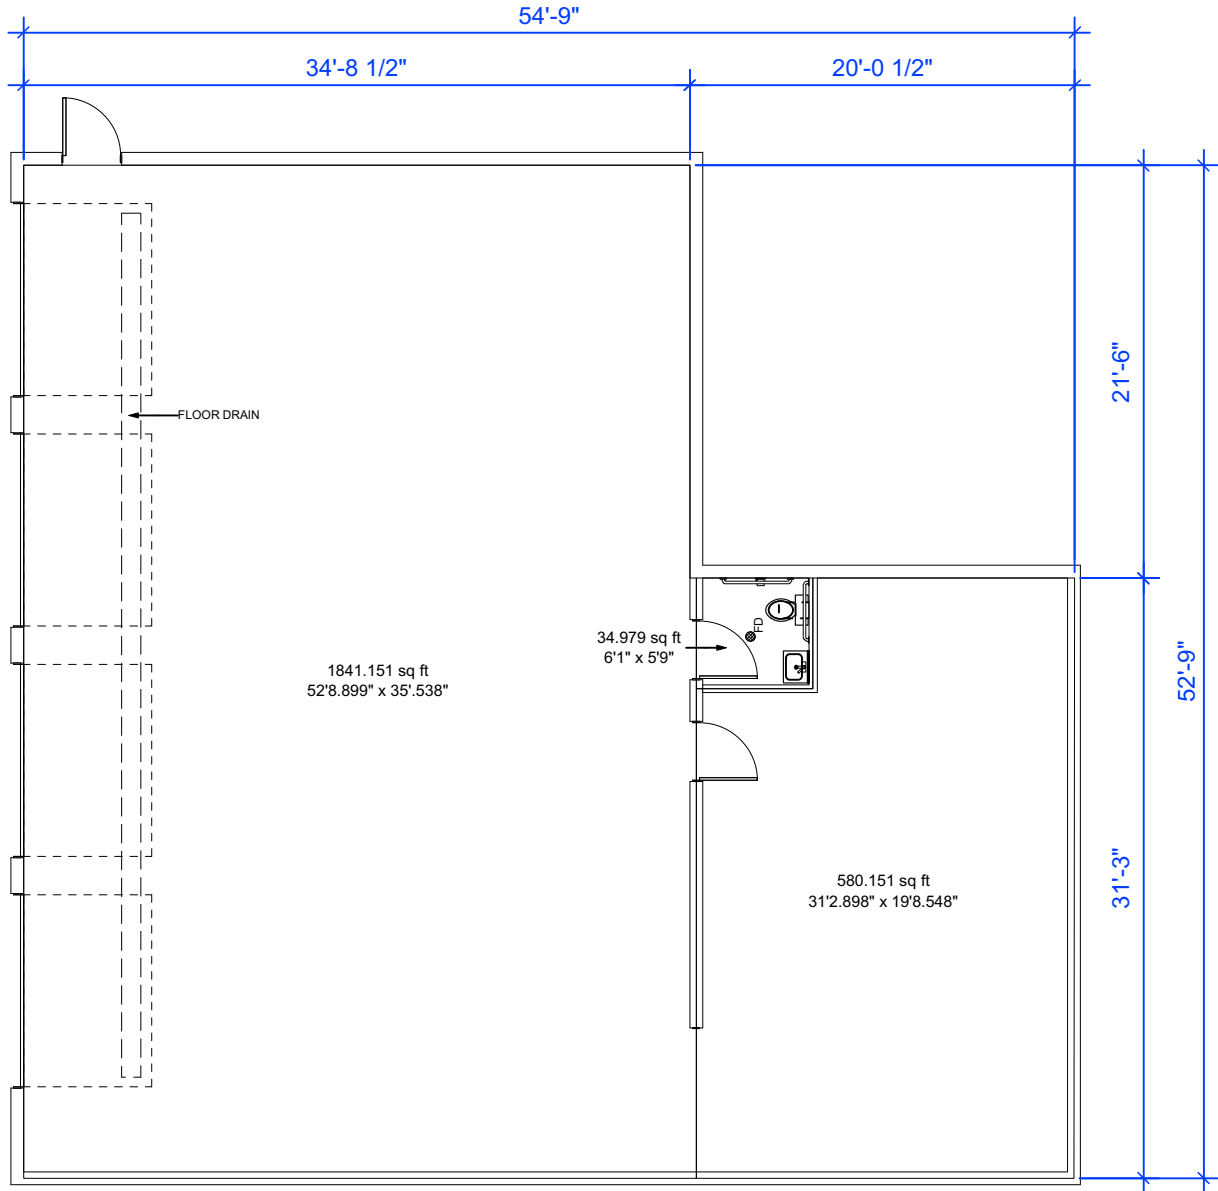

PARKWAY PLAZA

2001 EVANGELINE THRUWAY, LAFAYETTE, LA
TOTAL CENTER: 136,707.06 SQ. FT.

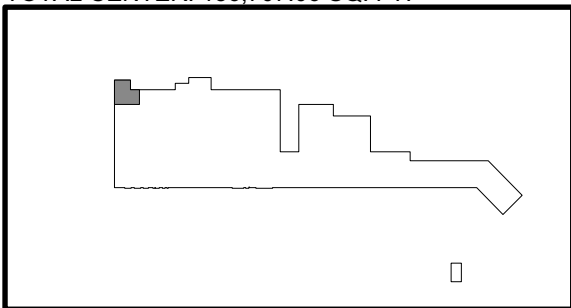

KEY PLAN

SUITE - 2

SCALE: 1" = 10'
DATE: 1/11/2018

FRONT AREA 1,841.151 SQ.FT.
BACK AREA 615.13 SQ.FT.

TOTAL AREA 2,456.281 SQ.FT.

Vermilion Architects, LLC

101 Hamilton Place, Lafayette, LA 70501

phone: (337) 234-4166

fax: (337) 234-7411

Angelique@VermilionArchitects.com

David@VermilionArchitects.com