


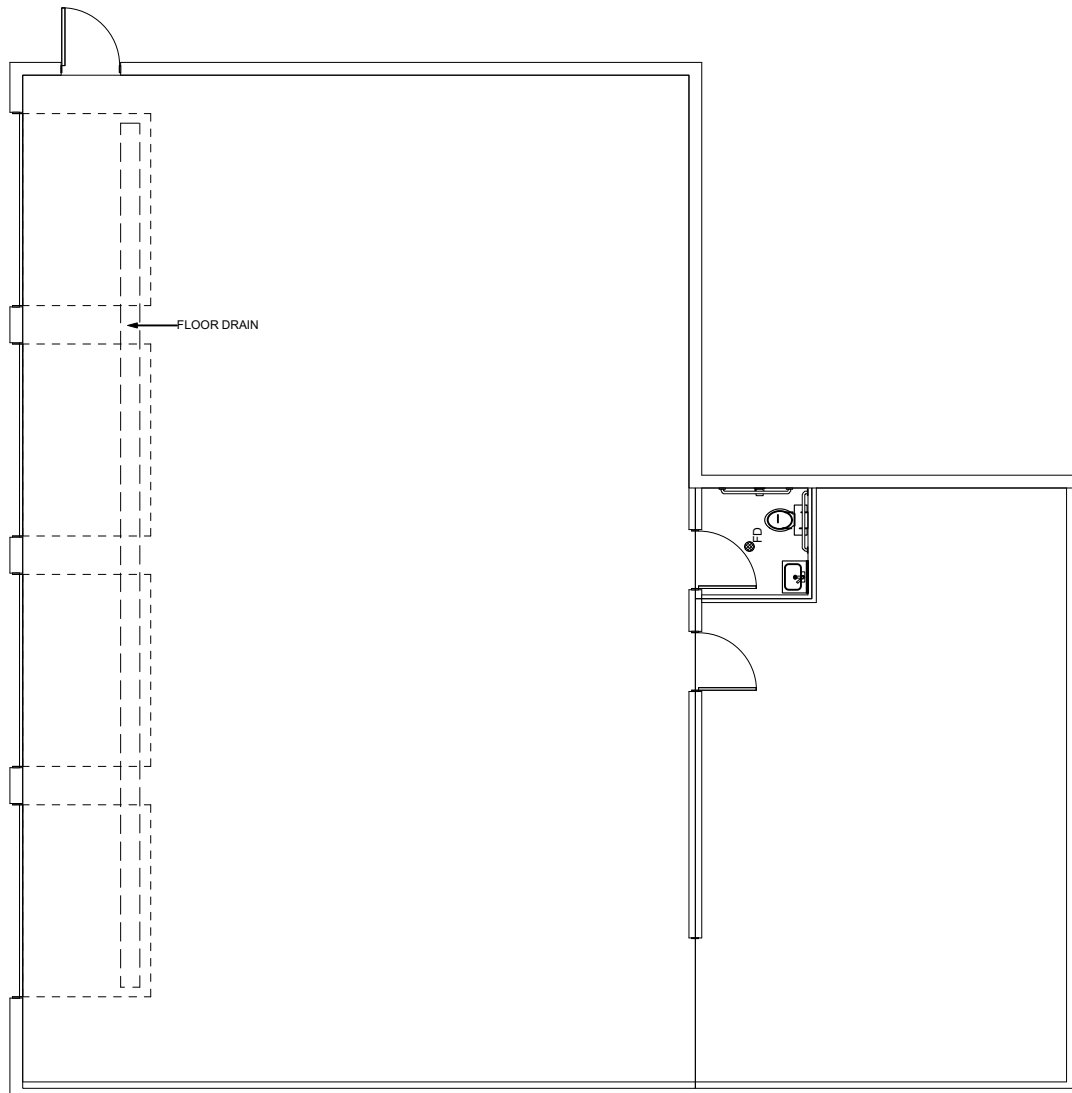


PARKWAY PLAZA

2001 EVANGELINE THRUWAY, LAFAYETTE, LA
TOTAL CENTER: 136,707.06 SQ. FT.

SUITE - 20016

SCALE: 1" = 10'

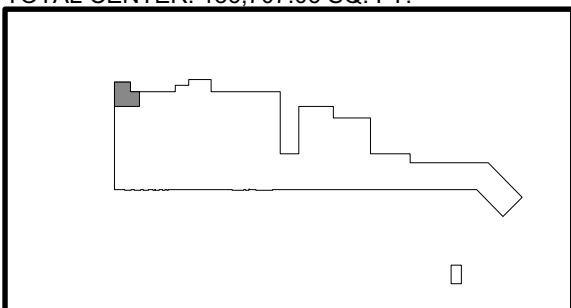

KEY PLAN

FRONT AREA	1,880 SQ.FT.
BACK AREA	619 SQ.FT.
TOTAL AREA	2,500 SQ.FT.