


SQUARE FOOTAGE

TOTAL TENANT SPACE: 2,394 SF

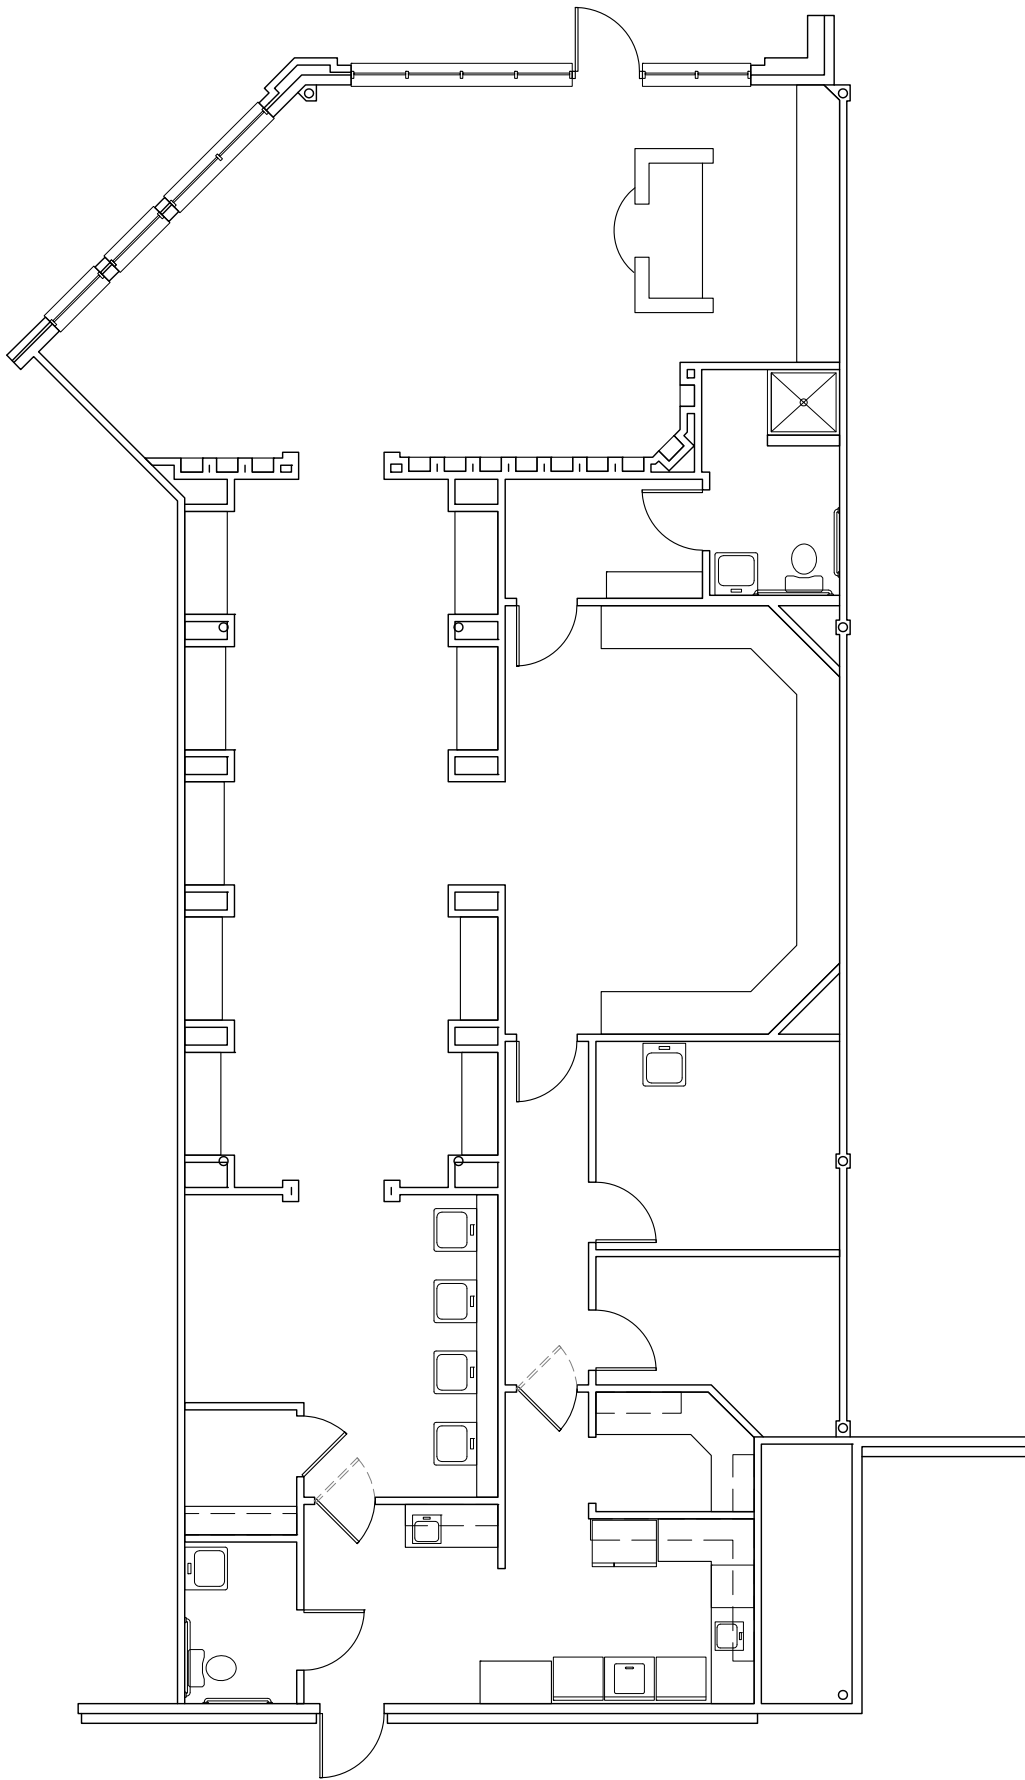

1 FLOOR PLAN

NOT TO SCALE

Date: 06/17/2013	02 of 02	Drawing Number: A-2	Sheet Title: SUITE 139C	Notes:	SERÉ CONSULTING	Kally M. Seré (337) 216-9184 410 Hanover Square ~ Lafayette, LA 70508 kallymser@yashoo.com	As-built drawings for Dwight Andrus Real Estate The Park 3809 Ambassador Caffery Pkwy, ~ Lafayette, LA 70508	13-11	Project Number:
		As-Built Documents							