



E:\2023\2023 TENANTS\2309 315 S COLLEGE RD\Drawings\ARCH\REVIT\2309 - 315 S COLLEGE RD\01.dwg

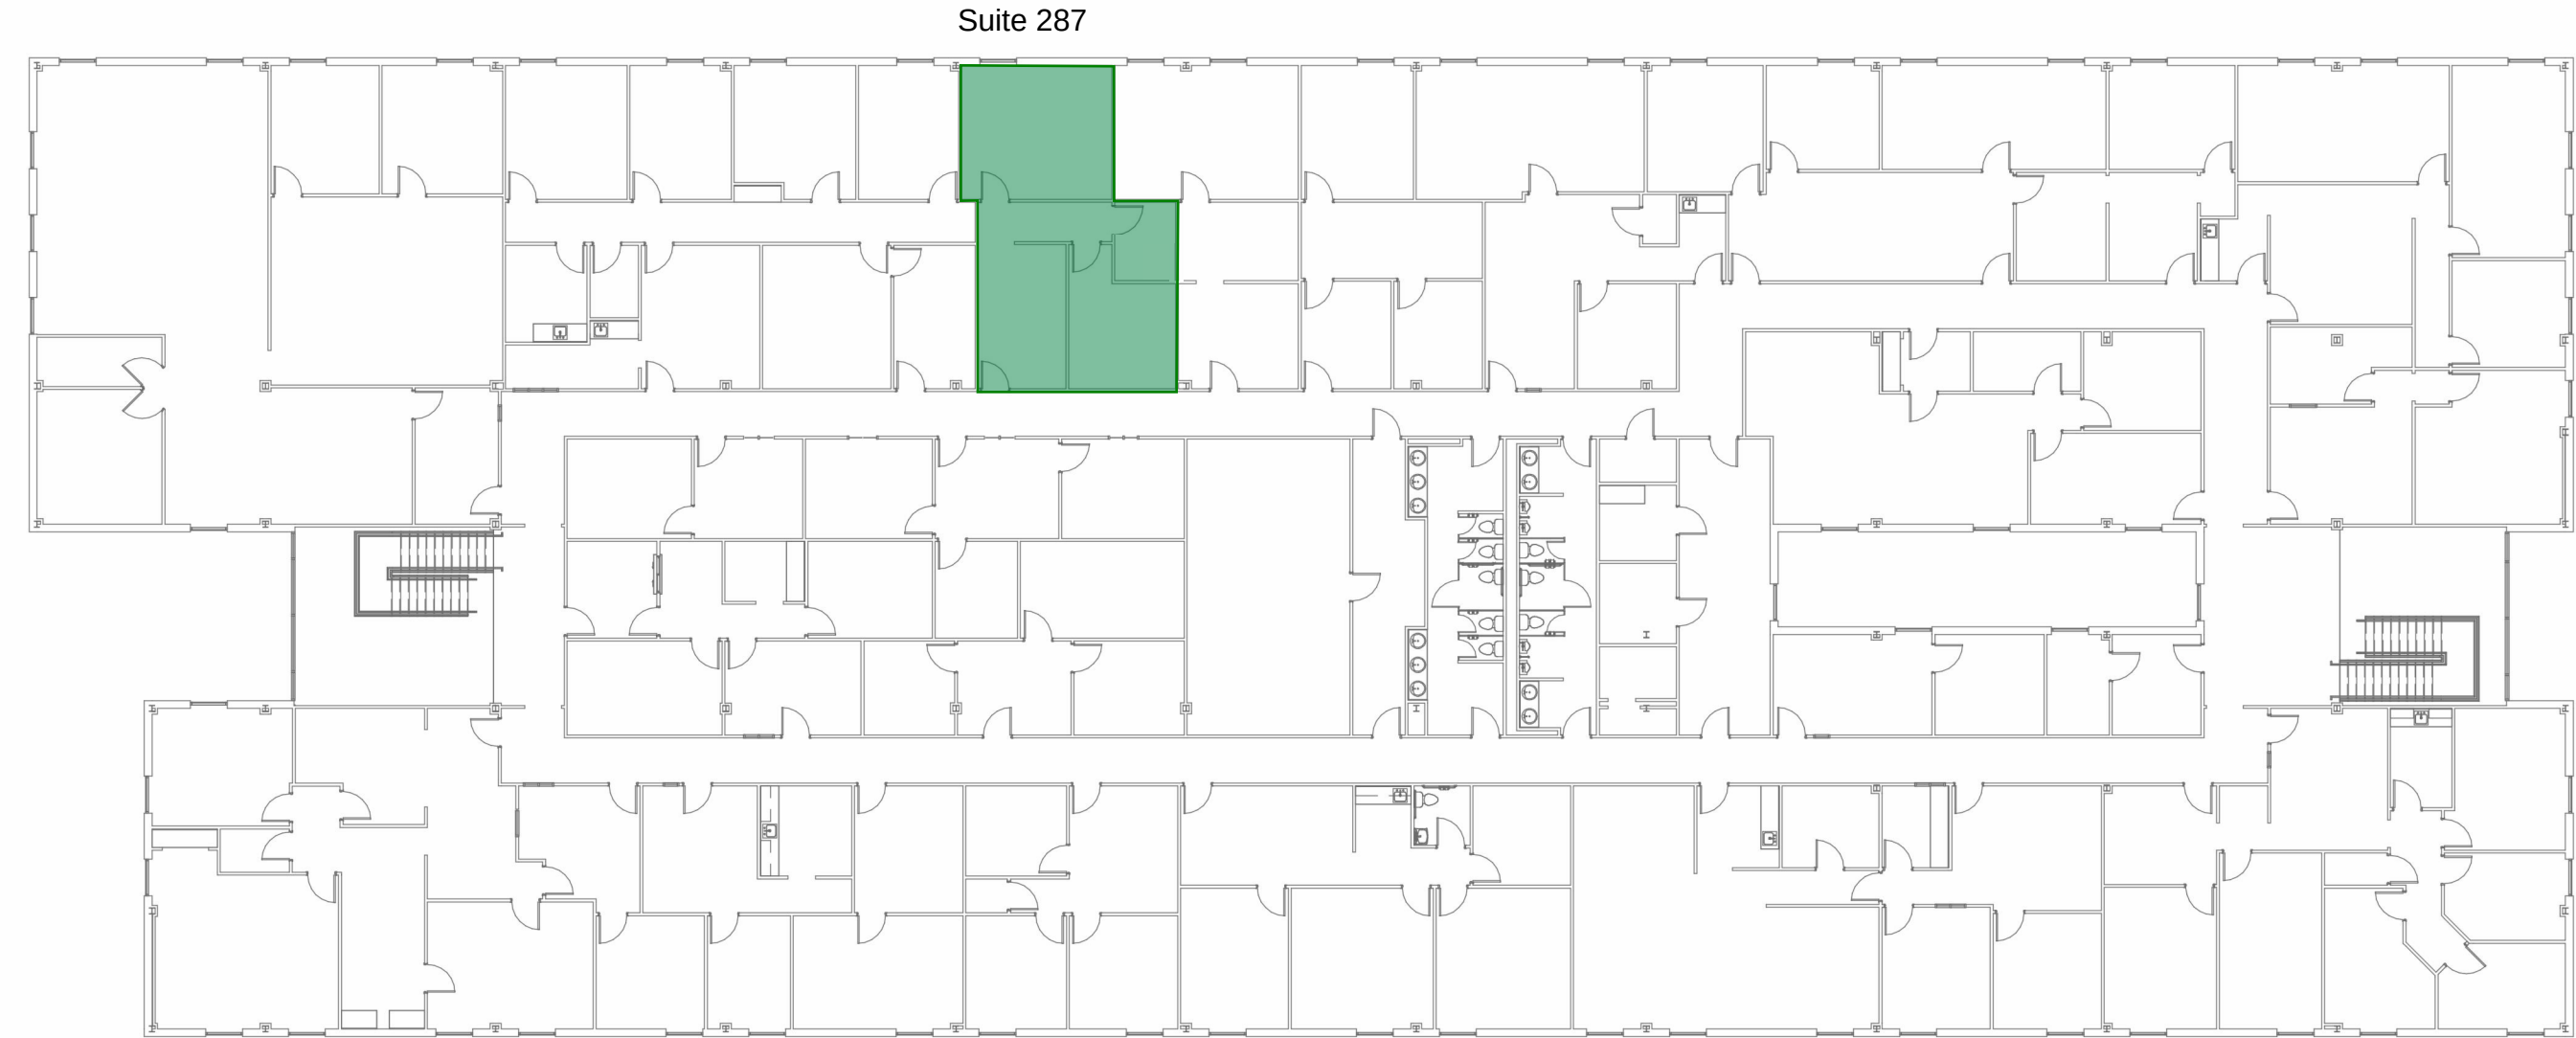

1 SECOND FLOOR PLAN
SCALE: 1" = 20'-0"

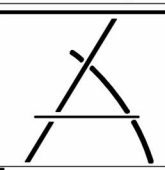

ZILER
ARCHITECTS
A PROFESSIONAL
ARCHITECTURAL
CORPORATION

JAMES O. ZILER, ARCHITECT
SEAN R. PRIMEAUX, ARCHITECT

101 Calco Boulevard
Lafayette, Louisiana 70503
Ph: 337-269-6326


10610 Florida Boulevard
Walker, Louisiana 70785
Ph: 225-424-6990
www.zilerarchitects.net

DOCUMENTS PREPARED BY ZILER ARCHITECTS ARE INSTRUMENTS OF THE ARCHITECT'S SERVICE FOR USE SOLELY WITH RESPECT TO THIS PROJECT. THE ARCHITECT SHALL RETAIN ALL COMMON LAW, STATUTORY AND OTHER RESERVED RIGHTS, INCLUDING THE COPYRIGHT. THEY ARE NOT TO BE USED BY THE CONTRACTOR OR ANY SUBCONTRACTOR, MATERIAL OR EQUIPMENT SUPPLIERS OR ANYONE FOR OTHER PROJECTS OR FOR ADDITIONS TO THIS PROJECT OUTSIDE THE SCOPE OF THE WORK WITHOUT THE SPECIFIC WRITTEN CONSENT OF ZILER ARCHITECTS.

RECORD DRAWINGS FOR:
315 SOUTH COLLEGE BUILDING
315 SOUTH COLLEGE ROAD
LAFAYETTE, LOUISIANA 70503

NOT FOR
CONSTRUCTION

DATE ISSUED	05/12/23
REVISED	-
PLOT DATE	06/29/23 4:00:32 PM
DRAWN BY	SRP
CHECKED BY	JOZ
PROJECT NO.	2309
SHEET NO.	A0.2
OF	0

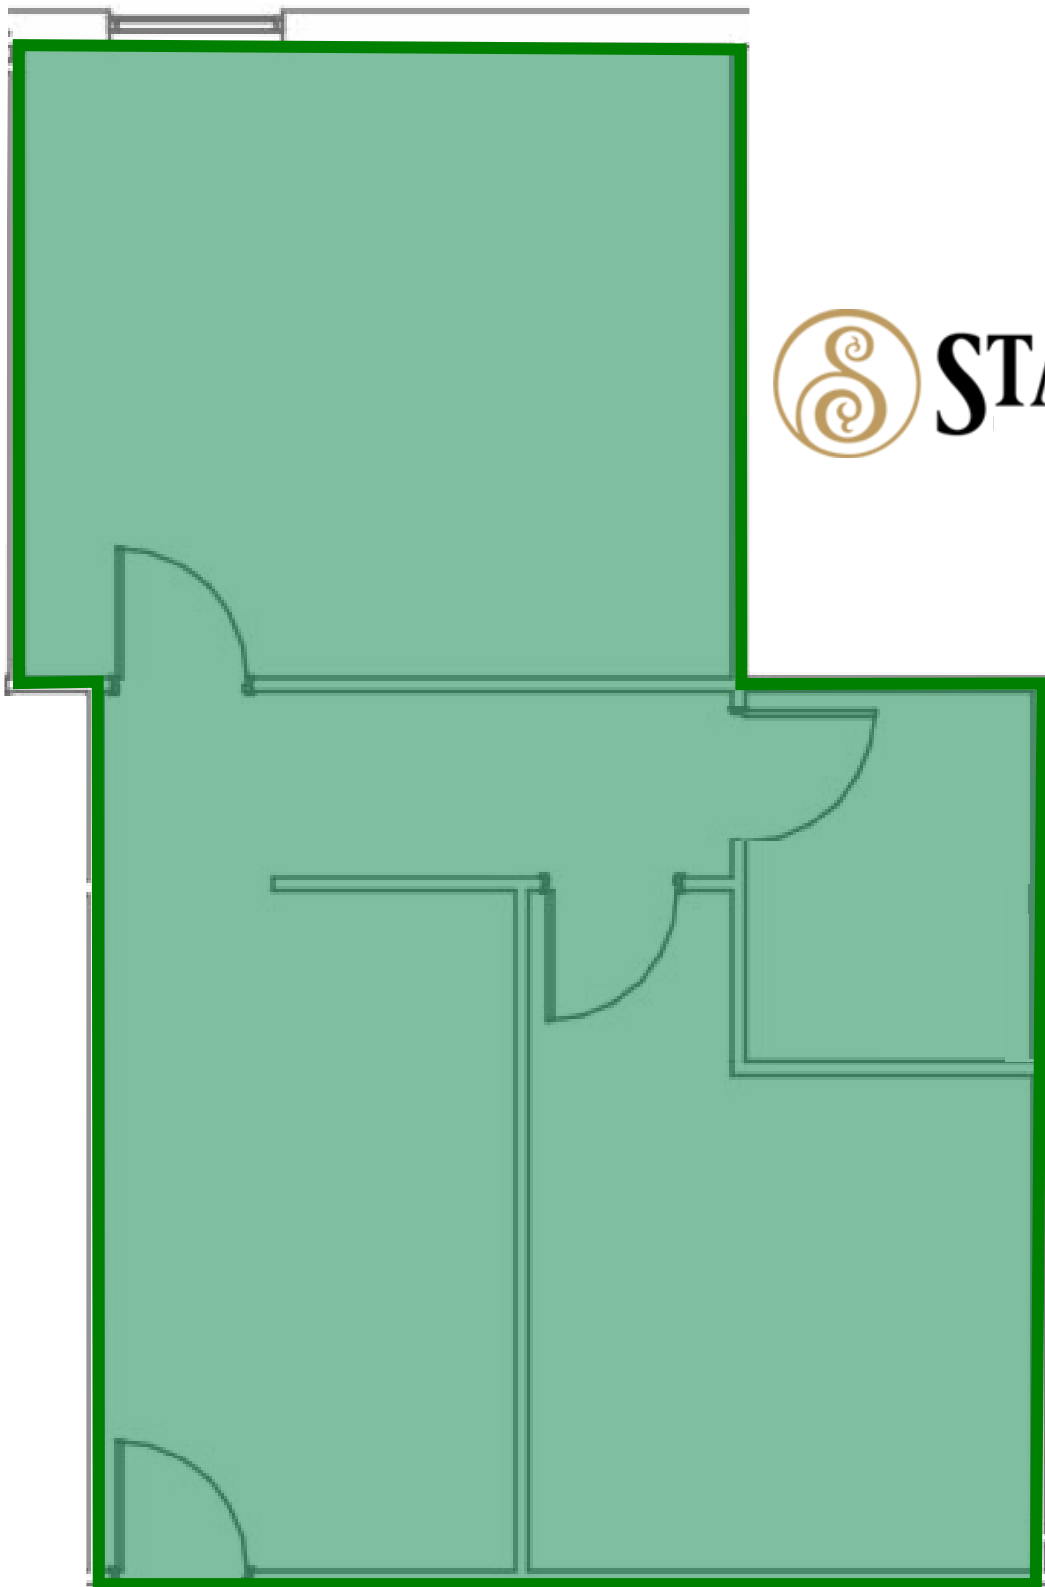

Suite 287
Rentable Sqft - 875 sqft