


121 Kansas City Avenue, Shreveport, LA

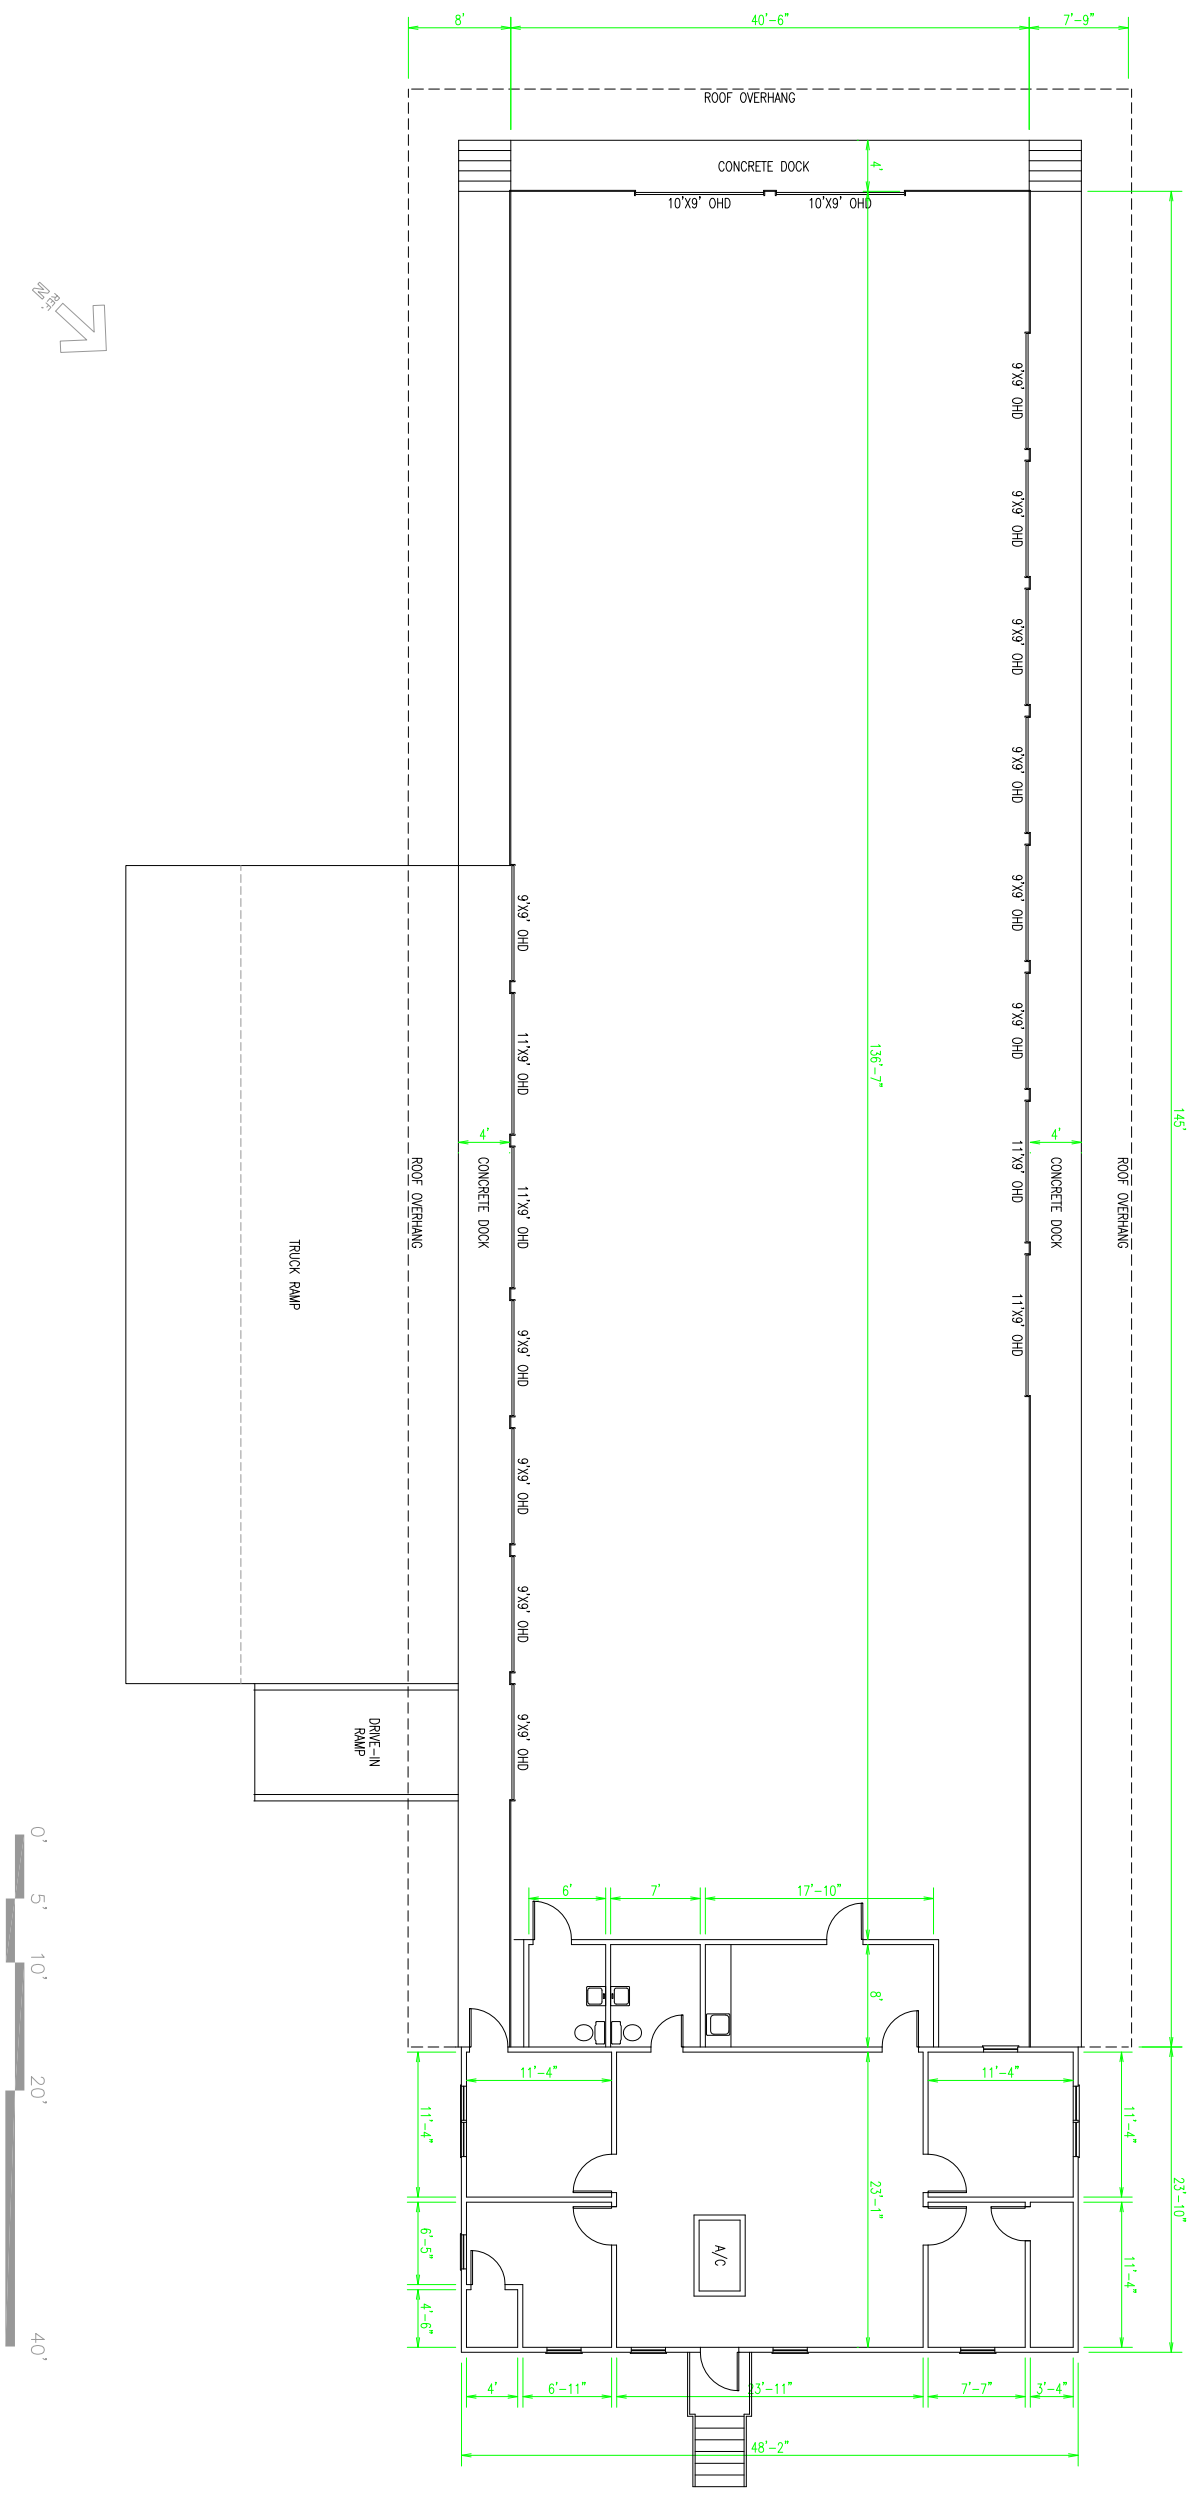

THIS PLAN IS INTENDED FOR REPRESENTATIONAL PURPOSES ONLY. ALL INFORMATION IS SUBJECT TO CHANGE.