


NAME	USABLE	COMMON (16%)	RENTABLE SF
Suite 300 (3A)	1,787 SF	286 SF	2,073 SF
Suite 302 (3B)	3,316 SF	531 SF	3,847 SF
Suite 304 (3C)	1,621 SF	259 SF	1,880 SF
Suite 310 (3D)	2,236 SF	358 SF	2,593 SF

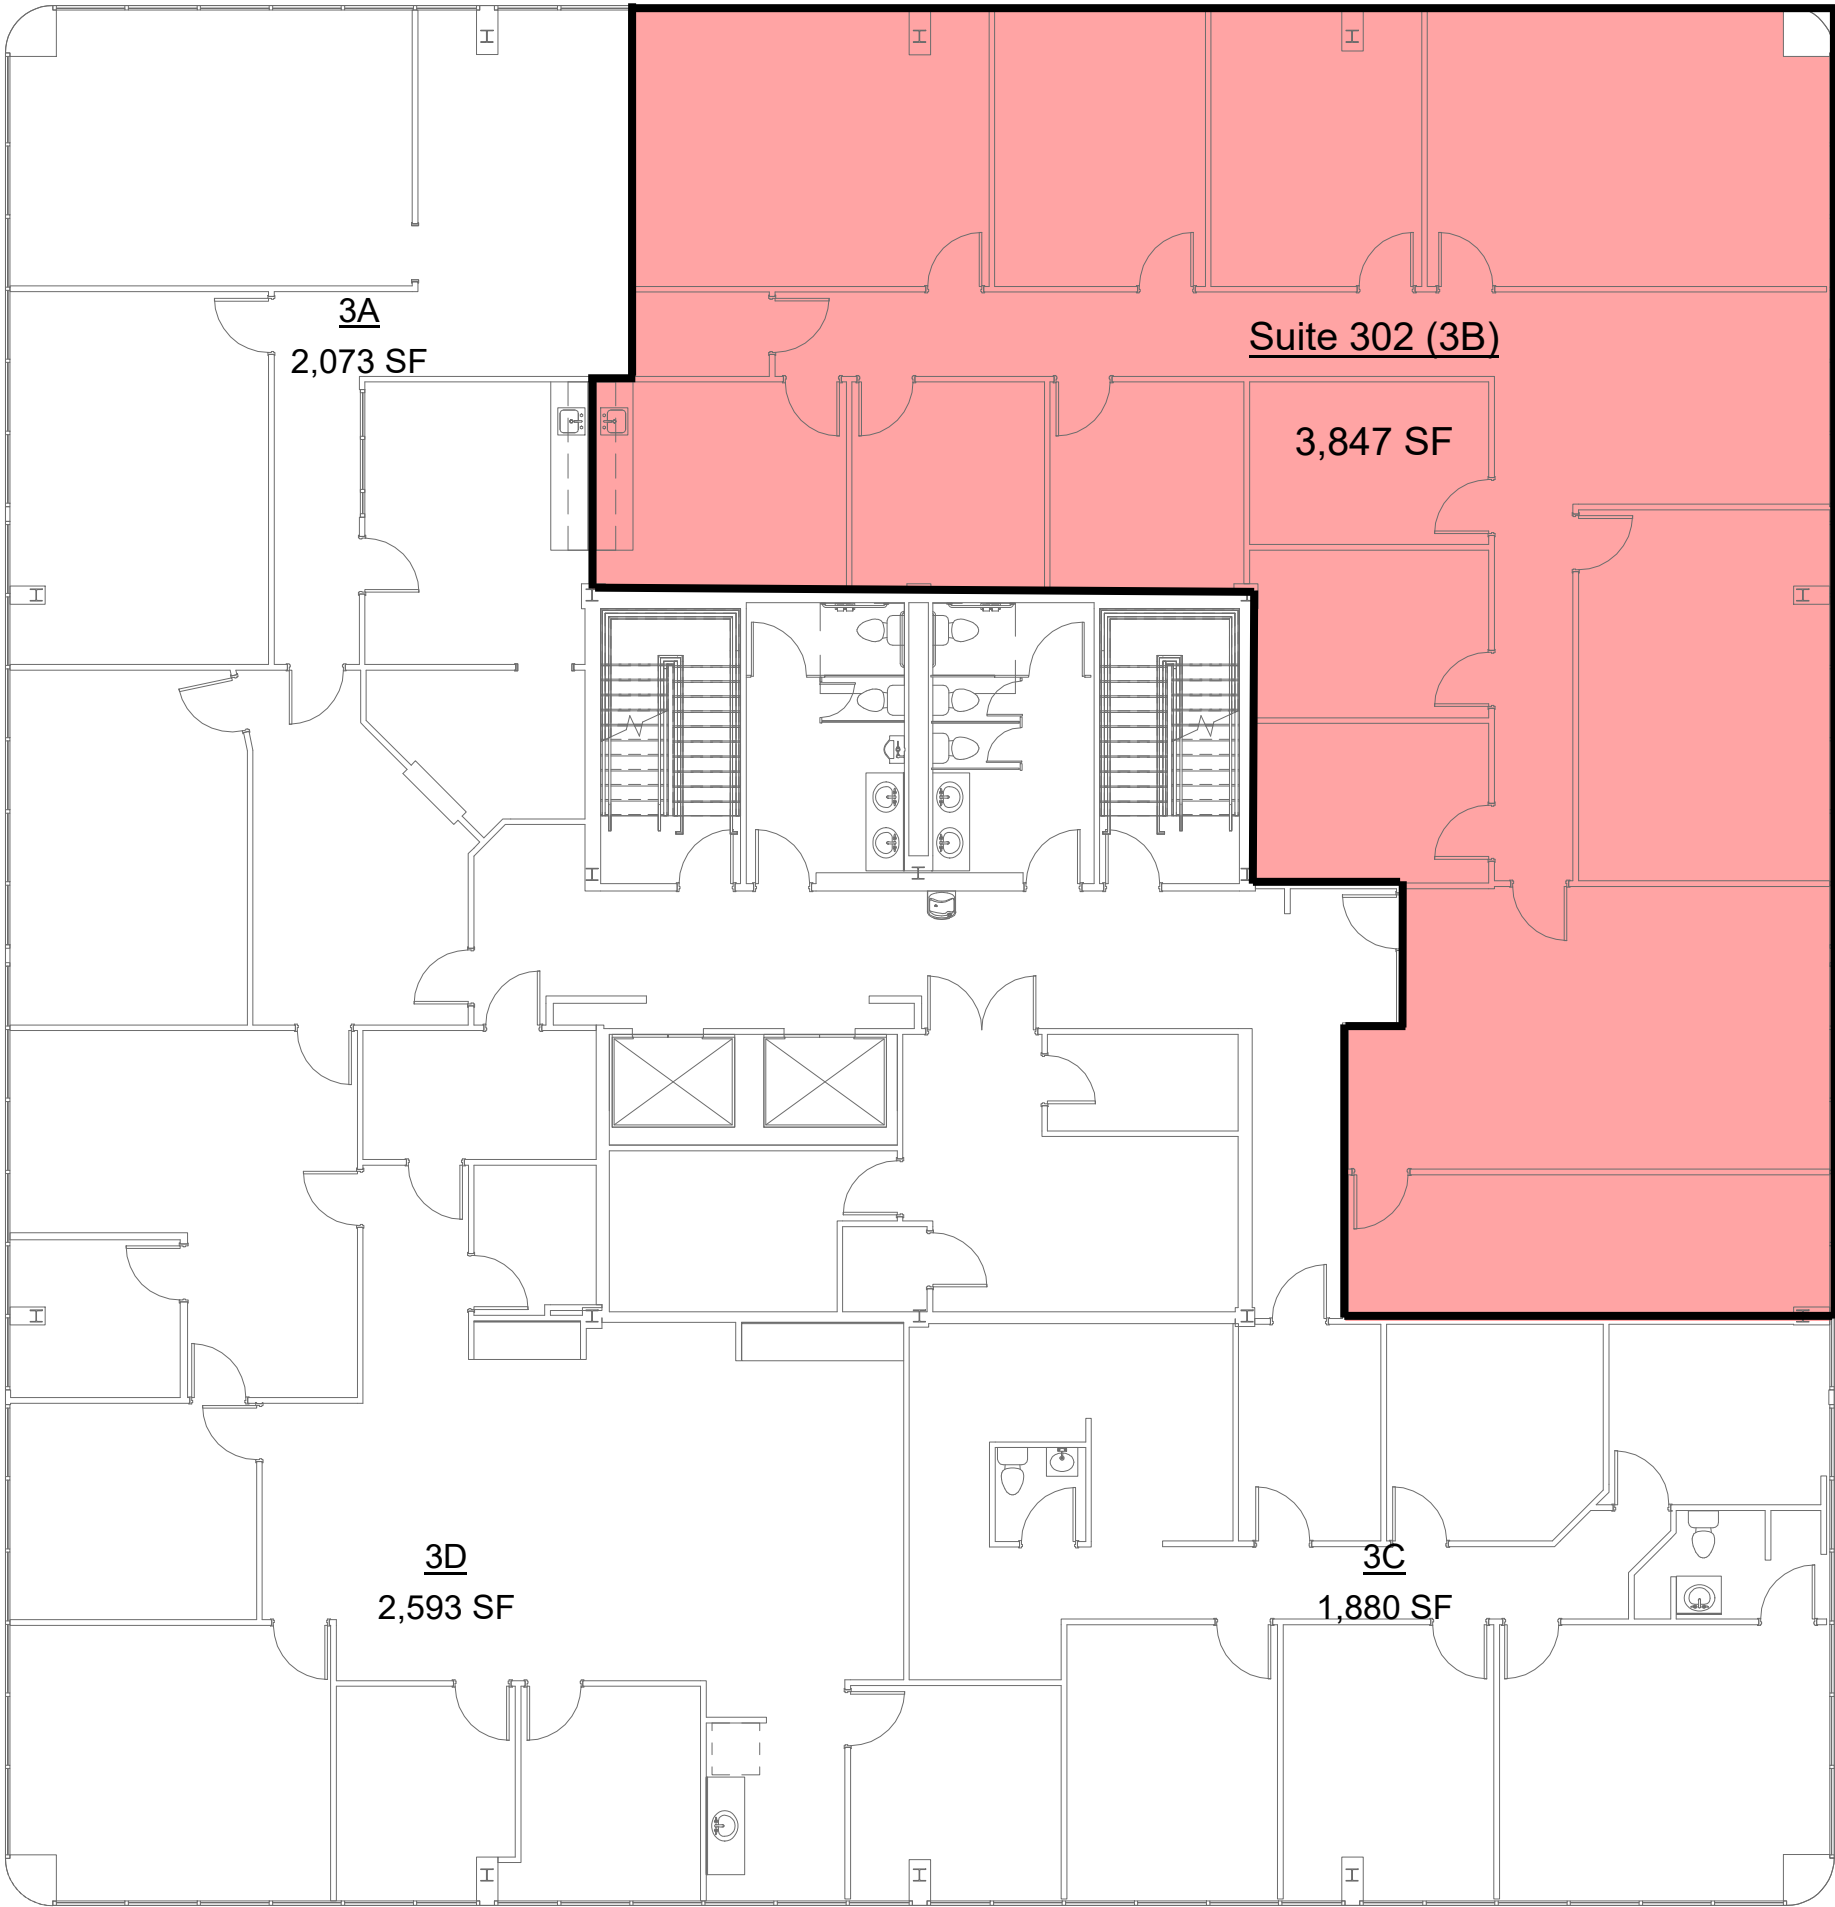

1 THIRD FLOOR

SCALE: 3/32" = 1'-0"

ZILER ARCHITECTS
A PROFESSIONAL ARCHITECTURAL CORPORATION
101 CALCO BLVD
LAFAYETTE, LOUISIANA 70503
337 269 6326 FAX 269 6380

DOCUMENTS PREPARED BY ZILER ARCHITECTS ARE INSTRUMENTS OF THE ARCHITECTS SERVICE FOR USE SOLELY WITH RESPECT TO THIS PROJECT. THE ARCHITECT SHALL RETAIN ALL COMMON LAW, STATUTORY AND OTHER RESERVED RIGHTS, INCLUDING THE COPYRIGHT. THEY ARE NOT TO BE USED BY THE CONTRACTOR OR ANY SUBCONTRACTOR, MATERIAL OR EQUIPMENT SUPPLIERS OR ANYONE FOR OTHER PROJECTS OR FOR ADDITIONS TO THIS PROJECT OUTSIDE THE SCOPE OF THE WORK WITHOUT THE SPECIFIC WRITTEN CONSENT OF ZILER ARCHITECTS.

RECORD DRAWINGS FOR:

LAHAYE CENTER

201 RUE IBERVILLE
LAFAYETTE, LOUISIANA 70508

NOT FOR CONSTRUCTION

DATE ISSUED	08/16/21
REVISED	-
PLOT DATE	08/18/21 4:13:39 PM
DRAWN BY	KEM
CHECKED BY	SRP
PROJECT NO.	2106
SHEET NO.	AC0.3
OF	—