

**JOHN C WILLIAMS
ARCHITECTS LLC**

824 BARONNE STREET
NEW ORLEANS, LA
70113
504.566.0888 PHONE
504.566.0897 FAX

These drawings and specifications have been prepared by me or under my close personal supervision and to the best of my personal knowledge and belief they comply with all applicable codes and requirements. I am not providing construction administrative services on this project.

Copyright © 2013
John C Williams Architects, LLC

Cotton Press Building

1770 Tchoupitoulas

New Orleans, Louisiana

- REVISIONS -		
No.	Date	Scope
4	10/29/12	CD Set Update
3	10/29/12	CD Set Update


DRAWING TITLE:
**Kitchen
Floor Plan**

SCALE:
JOB NO.: 501037.00
DATE: 29 AUGUST 2011

DRAWING NO.:

Foodservice Design By:
Moran Consulting, LLC
Foodservice Facility Design & Planning
101 Kenner Ct. Metairie, Louisiana 70001
504.885.9719
504.885.9721
www.moranconsulting.com

UPDATED 09/2017 -
"AS BUILT" PLANS

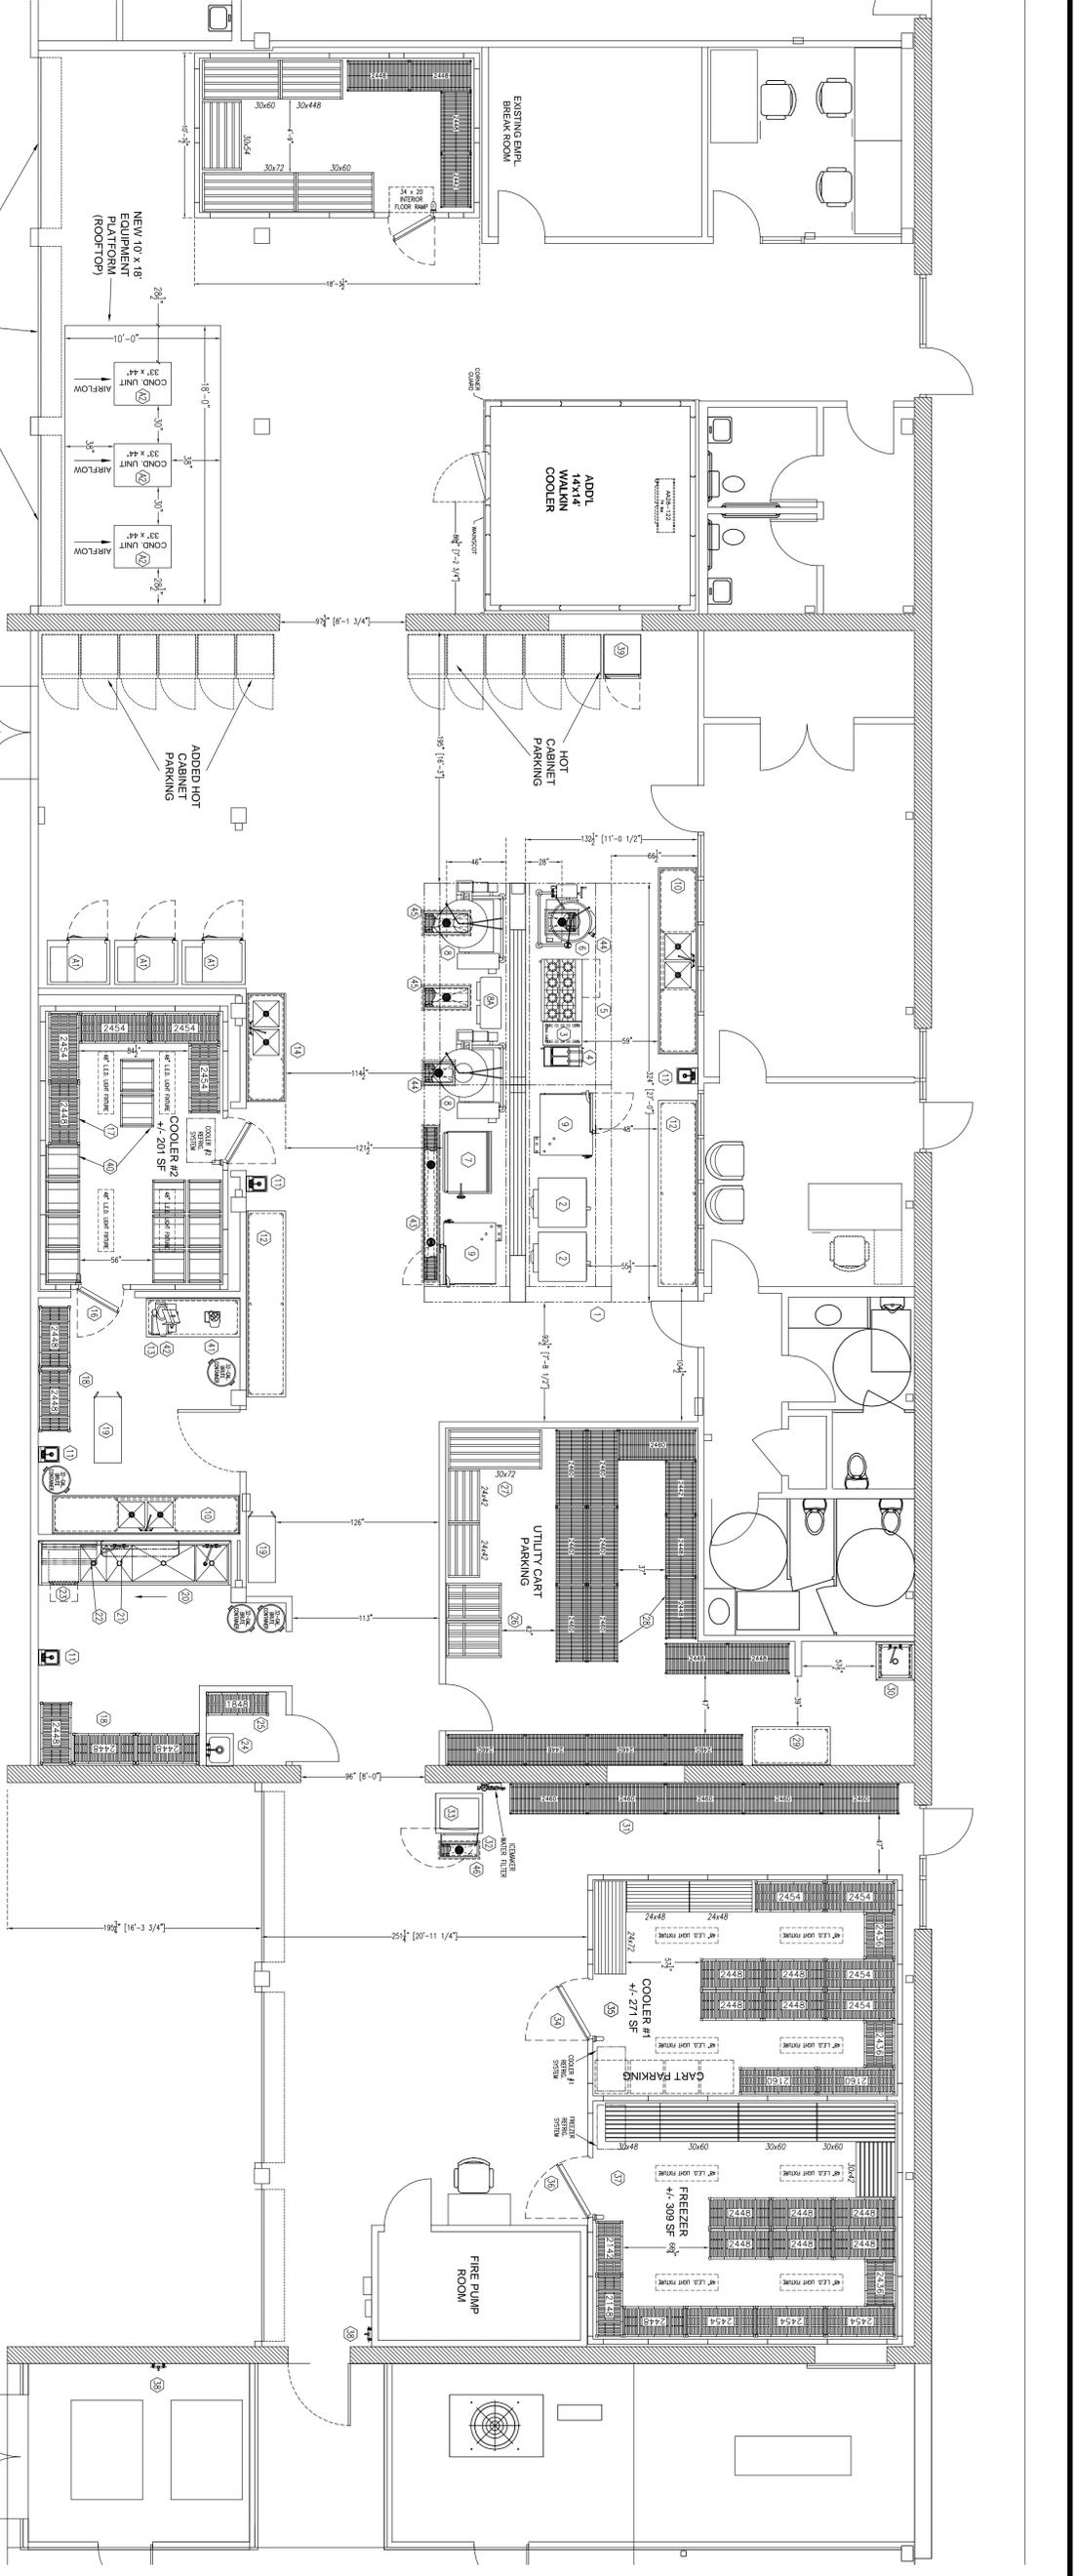

EQUIPMENT SCHEDULE

Item No.	Equipment Description	Manufacturer	Model Number	Equipment Schedule
1	Head/Unit System	Comline Air	Custom	
2	Oven, Convection, Gas	Brought Oven	070200 Double	
3	18" x 30" Slicer/Tender	Equip Group/Meat Matters	U70387TB	
4	48" Buffet/Hot Dish	Equip Group/Meat Matters	86-40-08	
5	48" Buffet/Hot Dish	Equip Group/Meat Matters	86-40-08	
NEW/ADDITIONAL EQUIPMENT SCHEDULE (2/27/15)

Item No.	Equipment Description	Manufacturer	Model Number	Equipment Schedule
1	Head/Unit System	Comline Air	Custom	
2	Oven, Convection, Gas	Brought Oven	070200 Double	
3	18" x 30" Slicer/Tender	Equip Group/Meat Matters	U70387TB	
4	48" Buffet/Hot Dish	Equip Group/Meat Matters	86-40-08	
5	48" Buffet/Hot Dish	Equip Group/Meat Matters	86-40-08	
RECONFIGURED HOT LINE EQUIPMENT SCHEDULE (5/13/15)

Item No.	Equipment Description	Manufacturer	Model Number	Equipment Schedule
1	Head/Unit System	Comline Air	Custom	
2	Oven, Convection, Gas	Brought Oven	070200 Double	
3	18" x 30" Slicer/Tender	Equip Group/Meat Matters	U70387TB	
4	48" Buffet/Hot Dish	Equip Group/Meat Matters	86-40-08	
5	48" Buffet/Hot Dish	Equip Group/Meat Matters	86-40-08	
