


Legend
 TESLA EV Charger

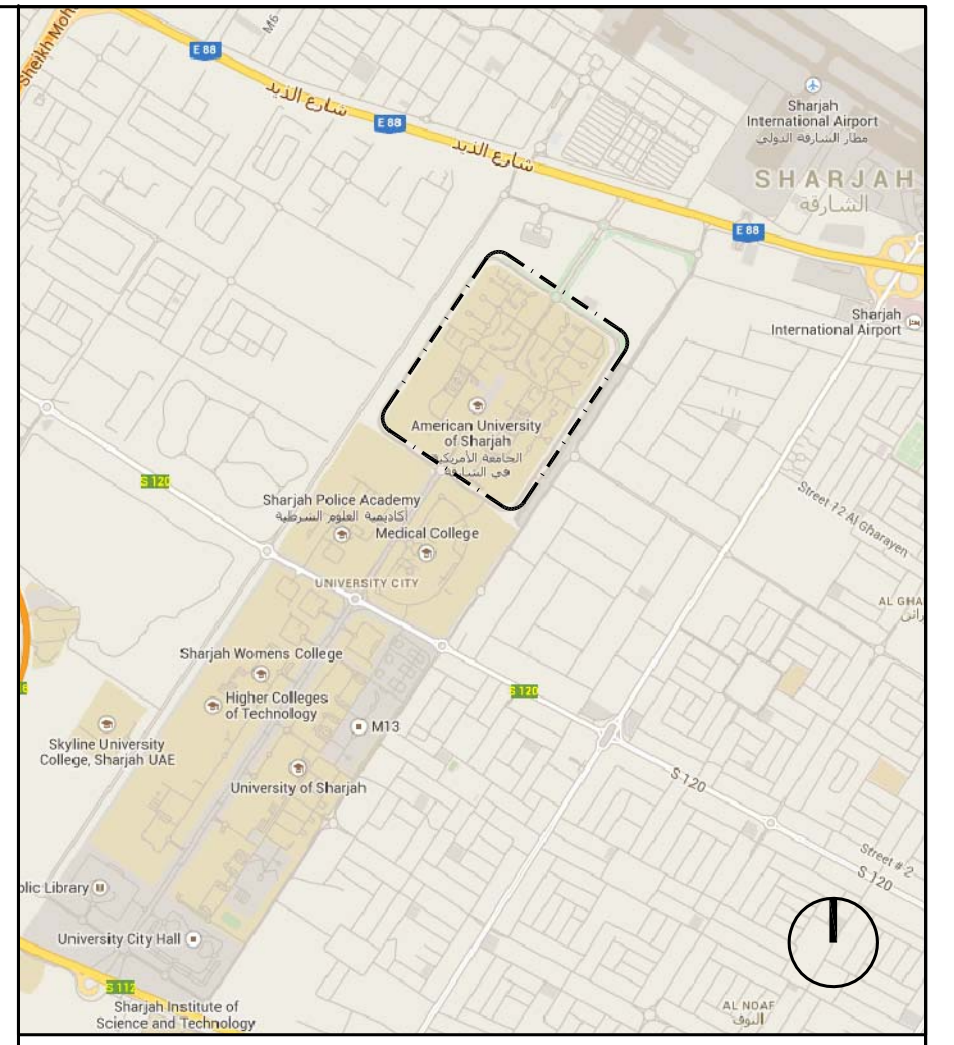

RV	DESCRIPTION	DATE	DR	APVD

- LEGEND**
- ① Main Building, Auditorium
 - ② Library
 - ③ College of Engineering (EB2)
 - ④ College of Engineering (EB1)
 - ⑤ Mosque
 - ⑥ Student Center
 - ⑦ Food Court
 - ⑧ College of Architecture, Art & Design (AD1)
 - ⑨ College of Architecture, Art & Design (AD2)
 - ⑩ College of Arts and Sciences: Languages & Health Center (CAS)
 - ⑪ College of Arts and Sciences: Physics (CAS)
 - ⑫ College of Arts and Sciences: Chemistry (CAS)
 - ⑬ New Academic Building (NAB)
 - ⑭ Arts Building
 - ⑮ Women's Welcome Center
 - ⑯ Women's Residential Halls
 - ⑰ Service Block
 - ⑱ School of Business Administration (SBA)
 - ⑲ SBA Service Yard
 - ⑳ Faculty/Staff Housing (East)
 - ㉑ Epicenter
 - ㉒ Men's Residential Halls (East)
 - ㉓ Men's Residential Halls (West)
 - ㉔ Wellness Center
 - ㉕ Leisure Center
 - ㉖ Day Care Center
 - ㉗ Faculty/Staff Housing (West)
 - ㉘ Sports Complex
 - ㉙ New Service Block
 - ㉚ Campus Service Center
 - ㉛ Outdoor Courts
 - ㉜ Sports Pavilion
 - ㉝ Sports Fields
 - ㉞ Entrance Security Guard House
 - ㉟ Etisalat Tower
 - ④① DU Tower
 - ⓑ Bus Stop
 - Ⓒ Car Park
 - Ⓢ Service Block
 - ▒ Existing Buildings
 - ▓ Under Construction/Approved
 - ⊠ Future Expansion

AUS | الجامعة الأمريكية في الشارقة
 American University of Sharjah
CAMPUS DEVELOPMENT

PROJECT
 AS-BUILT INFORMATION

BUILDING
 CAMPUS MASTER PLAN

DRAWING
 SITE PLAN

DES: HA	DRW: HA	DATE: 12-11-2015
CHK: CW	CHK: CW	SCALE: 1:5000@A3

DRAWING NO.	REVISION
0552-A003	-

1 SITE PLAN
 SCALE 1:5000 @ A3

AS-BUILT