



LEGEND:

- SEPTIC TANK
- SEWER CLEAN OUT
- ⊙ RAIN WATER COLLECTION
- TELE LINE
- ⊠ Power Meter
- Power
- Fence
- Gate
- Water Hose Bib
- Water Stand Pipe
- Water Well
- Tree
- Tree Line

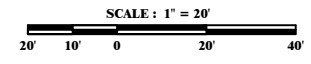

CARVER ENGINEERING
 Consulting Engineers
 1995 Third Avenue East
 Kalispell, Montana 59901
 (406) 257-6202

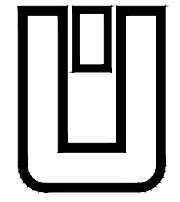

Revision(s)	
Drawn by	TLM
Checked by	AJH
Date	FEBRUARY 15, 2010
Project Number	59900.00

NEVAS PROPERTY
 AS-BUILTS

Project Title
 Sheet Title