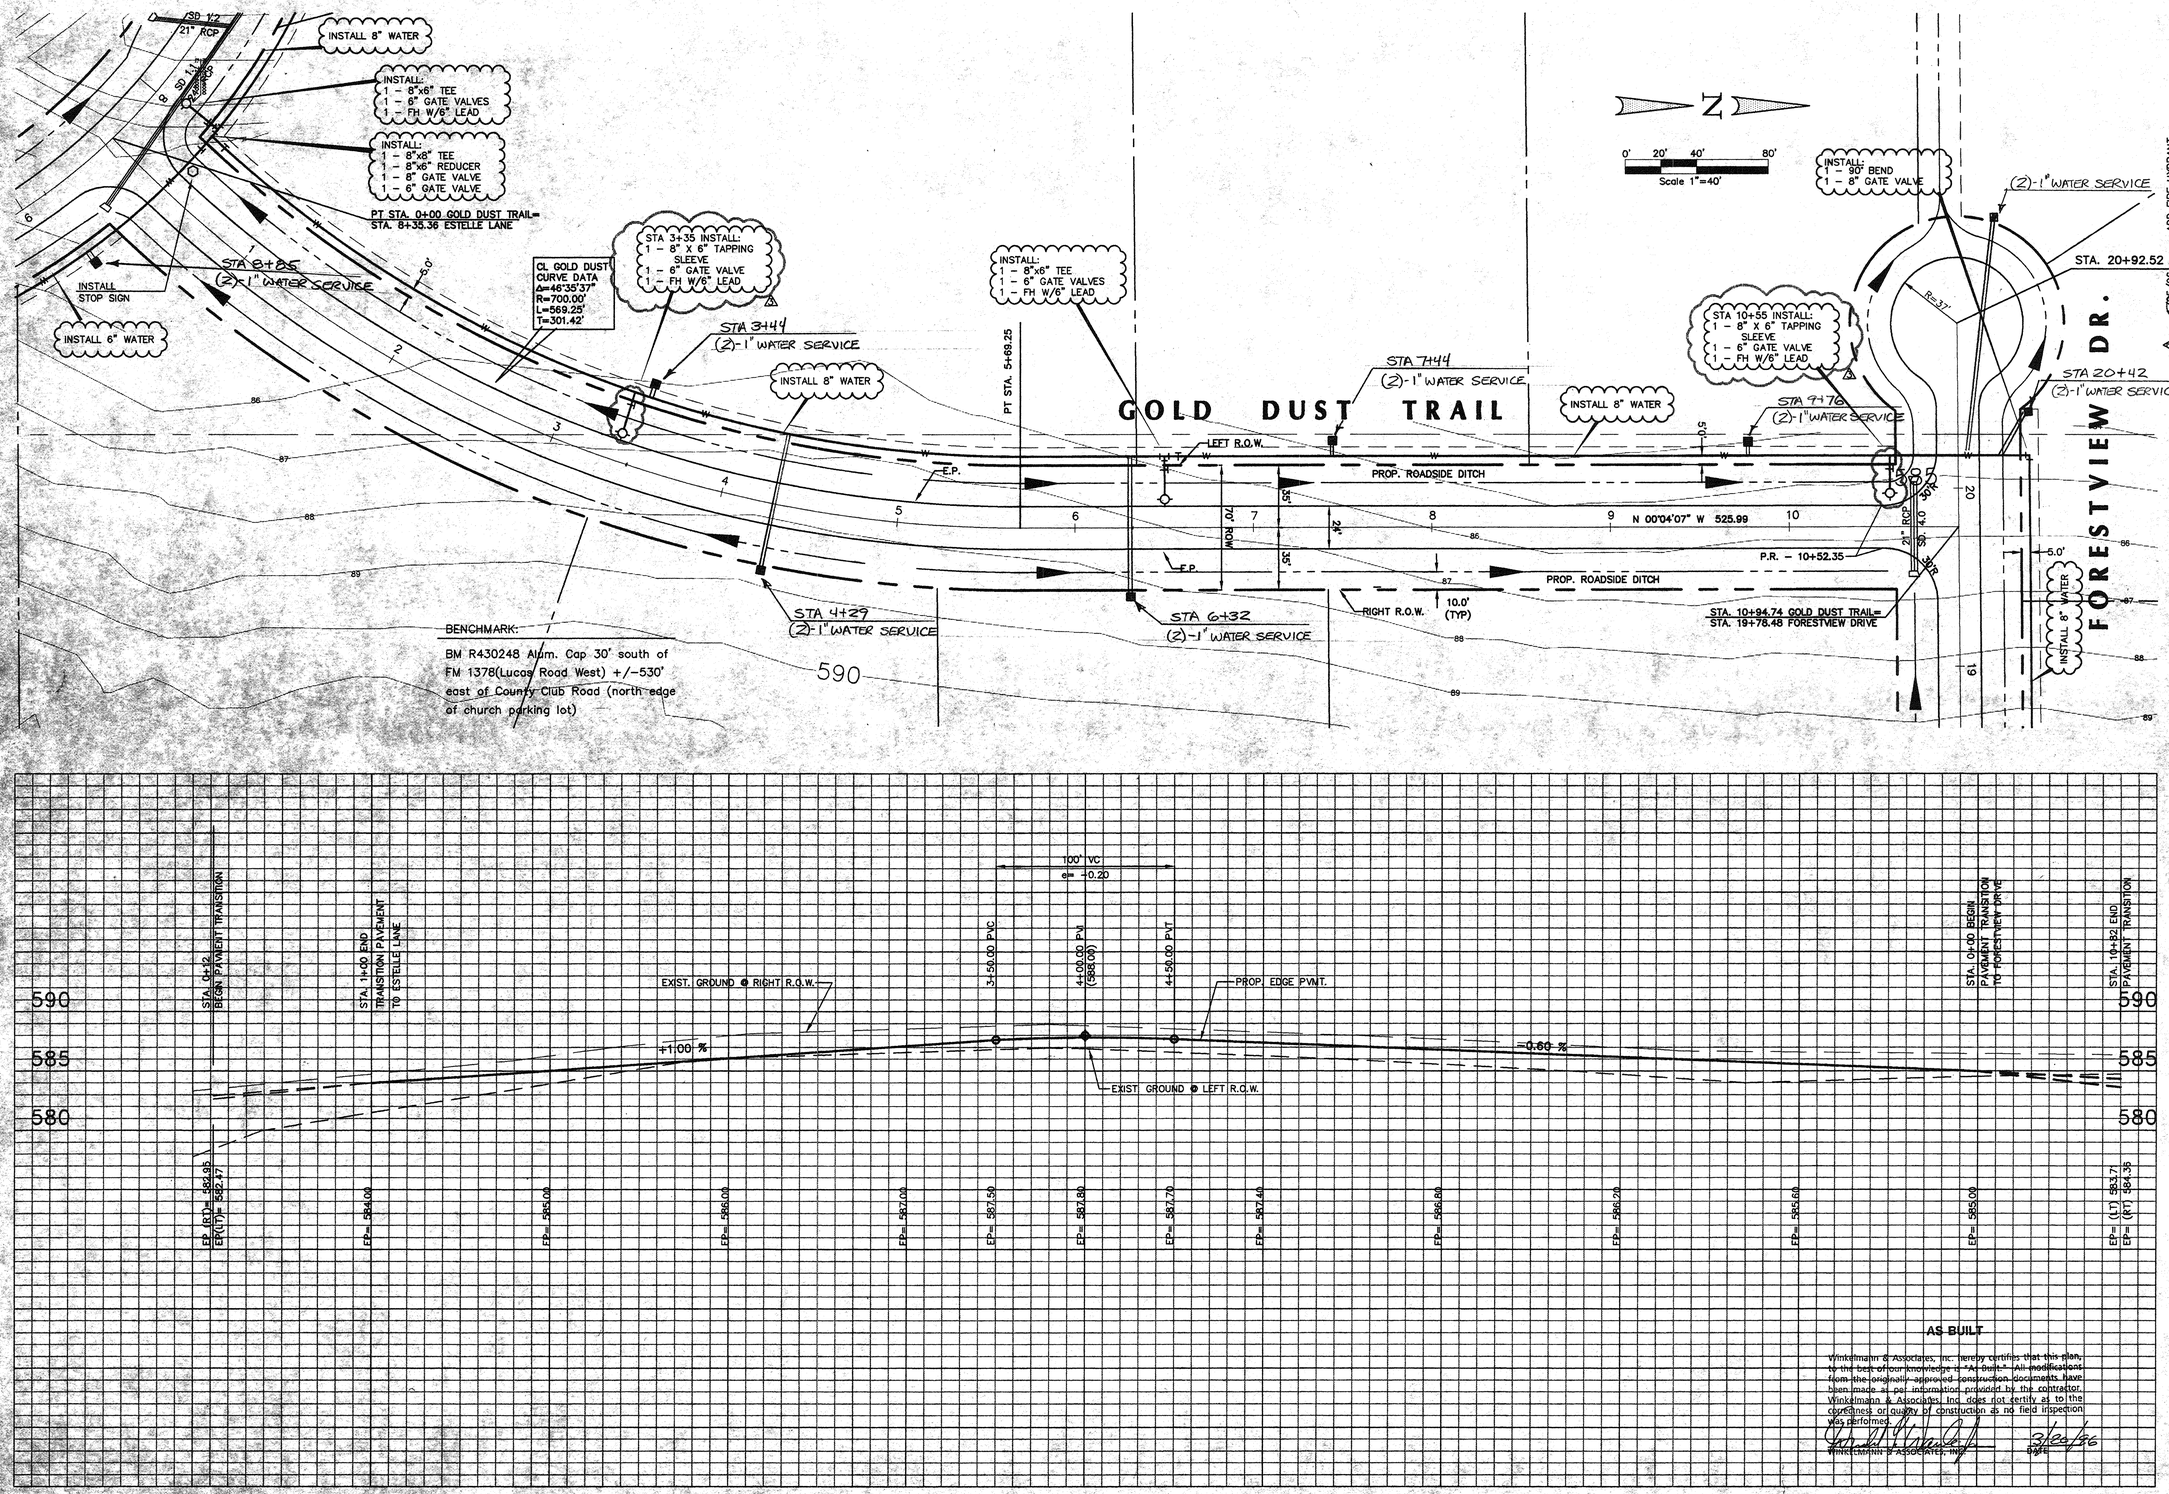

AS BUILT

Winkelmann & Associates, Inc. hereby certifies that this plan, to the best of our knowledge is "As-Built." All modifications from the originally approved construction documents have been made as per information provided by the contractor. Winkelmann & Associates, Inc. does not certify as to the correctness or quality of construction as no field inspection was performed.

WINKELMANN & ASSOCIATES, INC. — DATE 3/20/96

Winkelmann & Associates, Inc.
CONSULTING CIVIL ENGINEERS ■ SURVEYORS
12000 WILLCREST ROAD, SUITE 200 (214) 690-7080
DALLAS, TEXAS 75230 (214) 690-7085 FAX

STATE OF TEXAS — DONALD W. WINKELMANN JR. 56671 — REGISTERED PROFESSIONAL ENGINEER

1-29-96

P.F. LUCAS SURVEY, ABSTRACT NO. 537
BENJAMIN SPARKS SURVEY, ABASTRACT NO. 813
COLLIN COUNTY, TEXAS

UNITED STANDARD REALTY MORTGAGE CORPORATION
718 WEST ARAPAHO, STE. 100
RICHARDSON, TEXAS 75080
(214) 783-8888

PAVING, WATER & DRAINAGE PLAN
GOLD DUST TRAIL
HUNTWICK ADDITION - CITY OF LUCAS, TEXAS

Scale : H: 1"=40' V: 1"=8'	Date : 1/29/96
Designed By : DFW	
Drawn By : DFW	
Checked By : DFW	
File : 16801PP8.DWG	
Project No. : 16801.01	

SHEET C-13

n:\16801\16801PP8 Sat Jan 27 13:30:04 1996 PLOTED BY MAT