

CITY OF LUCAS, TEXAS
STINSON ROAD PAVING & DRAINAGE IMPROVEMENTS
Bid 012-18

ADDENDUM NO. 1

Plans and specifications for the Stinson Road Paving & Drainage Improvements project, for the City of Lucas, Texas, on which bids are to be received until **2:00 p.m. on Thursday, March 8, 2018**, are hereby modified as follows:

1. Refer to the **PROPOSAL & BID SCHEDULE:**

Strike pages PBS-7 through PBS-13 and replace with pages PBS-7A through PBS-14A attached marked Addendum No. 1 in the lower right corner.

2. Refer to the **SPECIAL CONDITIONS:**

A. Strike the body of SC.06 Time and Order of Completion and replace with the following:

“The contractor shall include the amount of calendar days necessary to complete the base bid and the amount of calendar days necessary to complete the additive alternate on the proposal and bid schedule. Time shall commence on the tenth (10th) day after the issuance of the work order. The work order shall consist of a written request by the Owner to the Contractor to proceed with construction of the project.

No work may begin within TxDOT right-of-way until authorization is provided by the City or their representative. Plans have been submitted to TxDOT and the City is waiting on approval of the driveway permit.”

B. Add the following special condition:

“SC. 53 Traffic Control

The Contractor shall submit a traffic control and phasing plan for Stinson Road to the City for review prior to construction activities. The right turn movement from eastbound FM 1378 (W. Lucas Road) to southbound Stinson Road must be maintained and accessible throughout all phases of construction.”

3. Refer to the **CONSTRUCTION PLANS:**

Add construction plan sheets 33 through 38 attached marked Addendum No. 1 in the lower left corner. These plan sheets cover the scope of work associated with Additive Alternate No. 1.

4. Bidders shall acknowledge receipt of Addendum No. 1 in the space provided in the Proposal, on the outer envelope of their bid, and by faxing back the "Transmittal of Addendum Acknowledgment Sheet" to Birkhoff, Hendricks & Carter, L.L.P. at (214) 461-8390, or email to Office@bhcllp.com.


Signature

Date: 3/1/18



BIRKHOFF, HENDRICKS & CARTER, L.L.P.
PROFESSIONAL ENGINEERS
11910 GREENVILLE AVE., SUITE 600
DALLAS, TEXAS 75243

TBPE Firm No. 526
TBPLS Firm No. 100318-00

**COUNTRY CLUB ROAD & W. LUCAS ROAD INTERSECTIONS IMPROVEMENTS
ADDITIVE ALTERNATE NO. 1**

BID SCHEDULE

Item No.	Estimated Quantity	Unit	Description and Price in Words	Price in Figures	Extended Amount
201	1	L.S.	Prepare Right-of-Way, Insurance, Bonds & Mobilization complete in place, the sum of _____ _____ Dollars and _____ Cents per Lump Sum		
202	200	C.Y.	Unclassified Excavation complete in place, the sum of _____ _____ Dollars and _____ Cents per Cubic Yard		
203	230	S.Y.	Remove & Dispose of Asphalt Pavement complete in place, the sum of _____ _____ Dollars and _____ Cents per Square Yard		
204	369	L.F.	Remove & Dispose of Metal Beam Guard Fence complete in place, the sum of _____ _____ Dollars and _____ Cents per Linear Foot		
205	61	L.F.	Remove & Dispose of 2-24" Corrugated Metal Culvert Pipe complete in place, the sum of _____ _____ Dollars and _____ Cents per Linear Foot		

Item No.	Estimated Quantity	Unit	Description and Price in Words	Price in Figures	Extended Amount
206	20	L.F.	Remove & Dispose of 2-24" Reinforced Concrete Culvert Pipe and Concrete Headwalls complete in place, the sum of _____ _____ Dollars and _____ Cents per Linear Foot		
207	1	Ea.	Remove & Replace Road Sign Assembly complete in place, the sum of _____ _____ Dollars and _____ Cents per Each		
208	1	Ea.	Remove & Dispose of Road Sign Assembly complete in place, the sum of _____ _____ Dollars and _____ Cents per Each		
209	2	Ea.	Remove & Dispose of 36-inch Safety End Treatment complete in place, the sum of _____ _____ Dollars and _____ Cents per Each		
210	1	Ea.	Remove & Dispose of 24-inch Culvert Headwall complete in place, the sum of _____ _____ Dollars and _____ Cents per Each		
211	1	L.S.	Remove, Stockpile & Re-Install Concrete Riprap complete in place, the sum of _____ _____ Dollars and _____ Cents per Lump Sum		

Item No.	Estimated Quantity	Unit	Description and Price in Words	Price in Figures	Extended Amount
212	50	Tons	Furnish & Install Type 'B' HMAC complete in place, the sum of _____ _____ Dollars and _____ Cents per Ton		
213	70	Tons	Furnish & Install Type 'D' HMAC complete in place, the sum of _____ _____ Dollars and _____ Cents per Ton		
214	125	Tons	Furnish & Install 8-Inch Flex Base complete in place, the sum of _____ _____ Dollars and _____ Cents per Ton		
215	5	L.F.	Furnish & Install 18-Inch Reinforced Concrete Pipe complete in place, the sum of _____ _____ Dollars and _____ Cents per Linear Foot		
216	53	L.F.	Furnish & Install 24-Inch Reinforced Concrete Pipe complete in place, the sum of _____ _____ Dollars and _____ Cents per Linear Foot		
217	82	L.F.	Furnish & Install 36-Inch Reinforced Concrete Pipe complete in place, the sum of _____ _____ Dollars and _____ Cents per Linear Foot		

Item No.	Estimated Quantity	Unit	Description and Price in Words	Price in Figures	Extended Amount
218	1	Ea.	Connect to Existing 24-Inch RCP with a Concrete Collar complete in place, the sum of _____ _____ Dollars and _____ Cents per Each		
219	3	Ea.	Connect to Existing 36-Inch RCP with a Concrete Collar complete in place, the sum of _____ _____ Dollars and _____ Cents per Each		
220	1	Ea.	Furnish & Install 18-Inch TxDOT CH-FW-0 Headwall complete in place, the sum of _____ _____ Dollars and _____ Cents per Each		
221	1	Ea.	Furnish & Install 24-Inch TxDOT CH-FW-0 Headwall complete in place, the sum of _____ _____ Dollars and _____ Cents per Each		
222	1	Ea.	Furnish & Install 24-Inch Safety End Treatment complete in place, the sum of _____ _____ Dollars and _____ Cents per Each		
223	1	Ea.	Furnish & Install 36-Inch Safety End Treatment complete in place, the sum of _____ _____ Dollars and _____ Cents per Each		

Item No.	Estimated Quantity	Unit	Description and Price in Words	Price in Figures	Extended Amount
224	200	L.F.	Furnish & Install Double 4-Inch Yellow Thermoplastic Stripe with Buttons complete in place, the sum of _____ _____ Dollars and _____ Cents per Linear Foot		
225	50	L.F.	Furnish & Install 4-Inch Solid White Thermoplastic Stripe complete in place, the sum of _____ _____ Dollars and _____ Cents per Linear Foot		
226	12	L.F.	Furnish & Install 24-Inch Solid White Thermoplastic Stripe complete in place, the sum of _____ _____ Dollars and _____ Cents per Linear Foot		
227	1	L.S.	Remove Existing Striping and Buttons from Proposed Left Turn Lane on F.M. 1378 complete in place, the sum of _____ _____ Dollars and _____ Cents per Lump Sum		
228	1,000	S.Y.	Furnish, Install & Maintain Solid Block Sod complete in place, the sum of _____ _____ Dollars and _____ Cents per Square Yard		
229	1	L.S.	Furnish Stormwater Pollution Prevention Plan complete in place, the sum of _____ _____ Dollars and _____ Cents per Lump Sum		

Item No.	Estimated Quantity	Unit	Description and Price in Words	Price in Figures	Extended Amount
230	1	L.S.	Furnish, Install, Maintain & Remove Erosion Control Devices complete in place, the sum of _____		
			_____ Dollars		
			and _____		
			Cents per Lump Sum		
231	1	L.S.	Furinsh, Install, Maintin & Remove Traffic Control Devices complete in place, the sum of _____		
			_____ Dollars		
			and _____		
			Cents per Lump Sum		
AMOUNT OF BID: ADDITIVE ALTERNATE NO. 1 (Items 201 Through 231)					

CITY OF LUCAS, TEXAS
Stinson Road Paving & Drainage Improvements

SUMMARY OF BIDS

AMOUNT OF BASE BID (Items 101 Through 125) \$ -

AMOUNT OF BID: ADDITIVE ALTERNATE NO. 1 (Items 201 Through 231) \$ -

TOTAL AMOUNT OF BID (Base Bid + Additive Alternate No. 1)	\$ <u>-</u>
--	--------------------

TOTAL CALENDAR DAYS FOR BASE BID calendar days

TOTAL CALENDAR DAYS FOR ADDITIVE ALTERNATE NO. 1 calendar days

TOTAL AMOUNT OF CALENDAR DAYS (Base Bid + Additive Alternate No. 1)	<u> </u> calendar days
--	--

In the event of the award of a contract to the undersigned, the undersigned will furnish a Performance Bond and a Payment Bond for the full amount of the contract, to secure compliance with the terms and provisions of the Contract Documents.

The work proposed to be done shall be accepted when fully completed and finished in accordance with the plans and specifications.

The undersigned certifies that the bid prices contained in this proposal have been carefully checked and are submitted as correct and final.

NOTE: Unit and lump sum prices must be shown in words and figures for each item listed in the proposal and in the event of discrepancy the words shall control.

Receipt is hereby acknowledged for the following addenda to the contract documents:

Addendum No. 1 dated	_____	Received	_____
Addendum No. 2 dated	_____	Received	_____
Addendum No. 3 dated	_____	Received	_____
Addendum No. 4 dated	_____	Received	_____
Addendum No. 5 dated	_____	Received	_____

Seal and Authorization
(If a Corporation)

Contractor

By: _____
(please print name)

Signature: _____

Title: _____

Address

City, County, State and Zip

Telephone

Fax No.

E-Mail Address: _____

CITY OF LUCAS, TEXAS

CONSTRUCTION PLANS FOR:

STINSON ROAD PAVING AND DRAINAGE IMPROVEMENTS

DESIGN SPEED: 35 M.P.H.

CITY COUNCIL

JIM OLK, MAYOR
KATHLEEN PEELE, MAYOR PRO-TEM
WAYNE MILLSAP
TIM BANEY
STEVE DUKE
PHILIP LAWRENCE
DEBBIE FISHER

CITY MANAGER

JONI CLARKE

PUBLIC WORKS DIRECTOR/CITY ENGINEER

STANTON FOERSTER, P.E.




PREPARED BY

BIRKHOFF, HENDRICKS & CARTER, L.L.P.
PROFESSIONAL ENGINEERS
TBPE Firm No. 526; TBPLS Firm No. 10031800
11910 Greenville Ave., Suite 600
Dallas, Texas 75243 (214) 361-7900

February 2018

These plans and related specifications were prepared for construction of this specific project only. Reuse of these documents is not permitted without written authorization of Birkhoff, Hendricks & Carter, L.L.P. If this drawing is converted to an electronic file, if any discrepancy occurs between the electronic file and the Birkhoff, Hendricks & Carter, L.L.P. original document, the original document will govern in all cases.

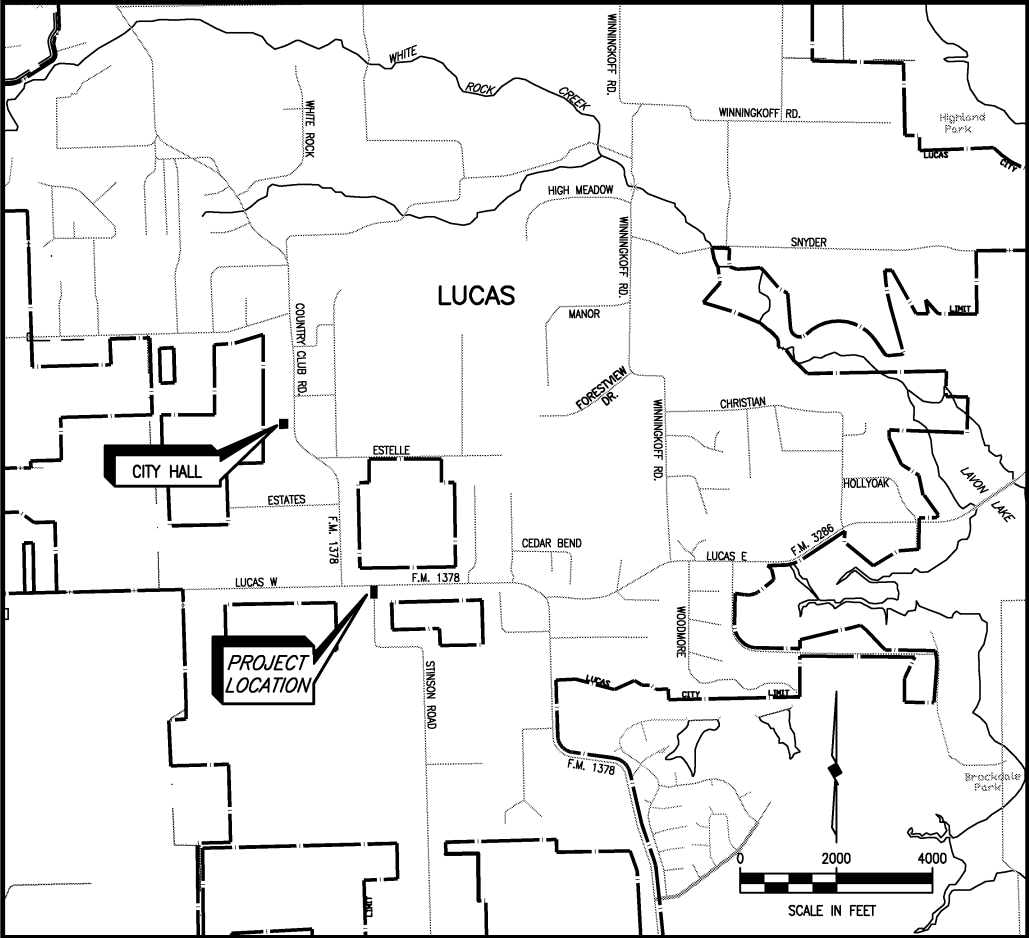

LOCATION MAP


SHEET INDEX

1	COVER SHEET, LOCATION MAP AND SHEET INDEX
2	GENERAL NOTES
3	TYPICAL SECTIONS
4	REMOVAL SHEET/SURVEY CONTROL POINTS
5	STINSON ROAD PAVING PLAN PROFILE
6-10	STINSON ROAD CROSS SECTIONS
11	PERMANENT MARKING AND SIGNAGE PLAN
12	DRAINAGE AREA MAP W/ CALCULATION TABLE
13	STINSON ROAD CULVERT REPLACEMENT PLAN PROFILE
14	CONSTRUCTION DETAILS
15-17	CULVERTS & SAFETY END TREATMENT DETAILS
18-32	TRAFFIC CONTROL & BARRICADE DETAILS
33	DEMOLITION AT INTERSECTION OF LUCAS RD. & COUNTRY CLUB RD.
34	PROPOSED DRIVEWAY PLAN-PROFILE
35	PROPOSED DRIVEWAY CULVERT PLAN-PROFILE
36	EXISTING DRIVEWAY LOCATIONS
37	CULVERT IMPROVEMENTS
38	PAVEMENT MARKINGS

ADDENDUM NO.1 {



Signature
2/26/18

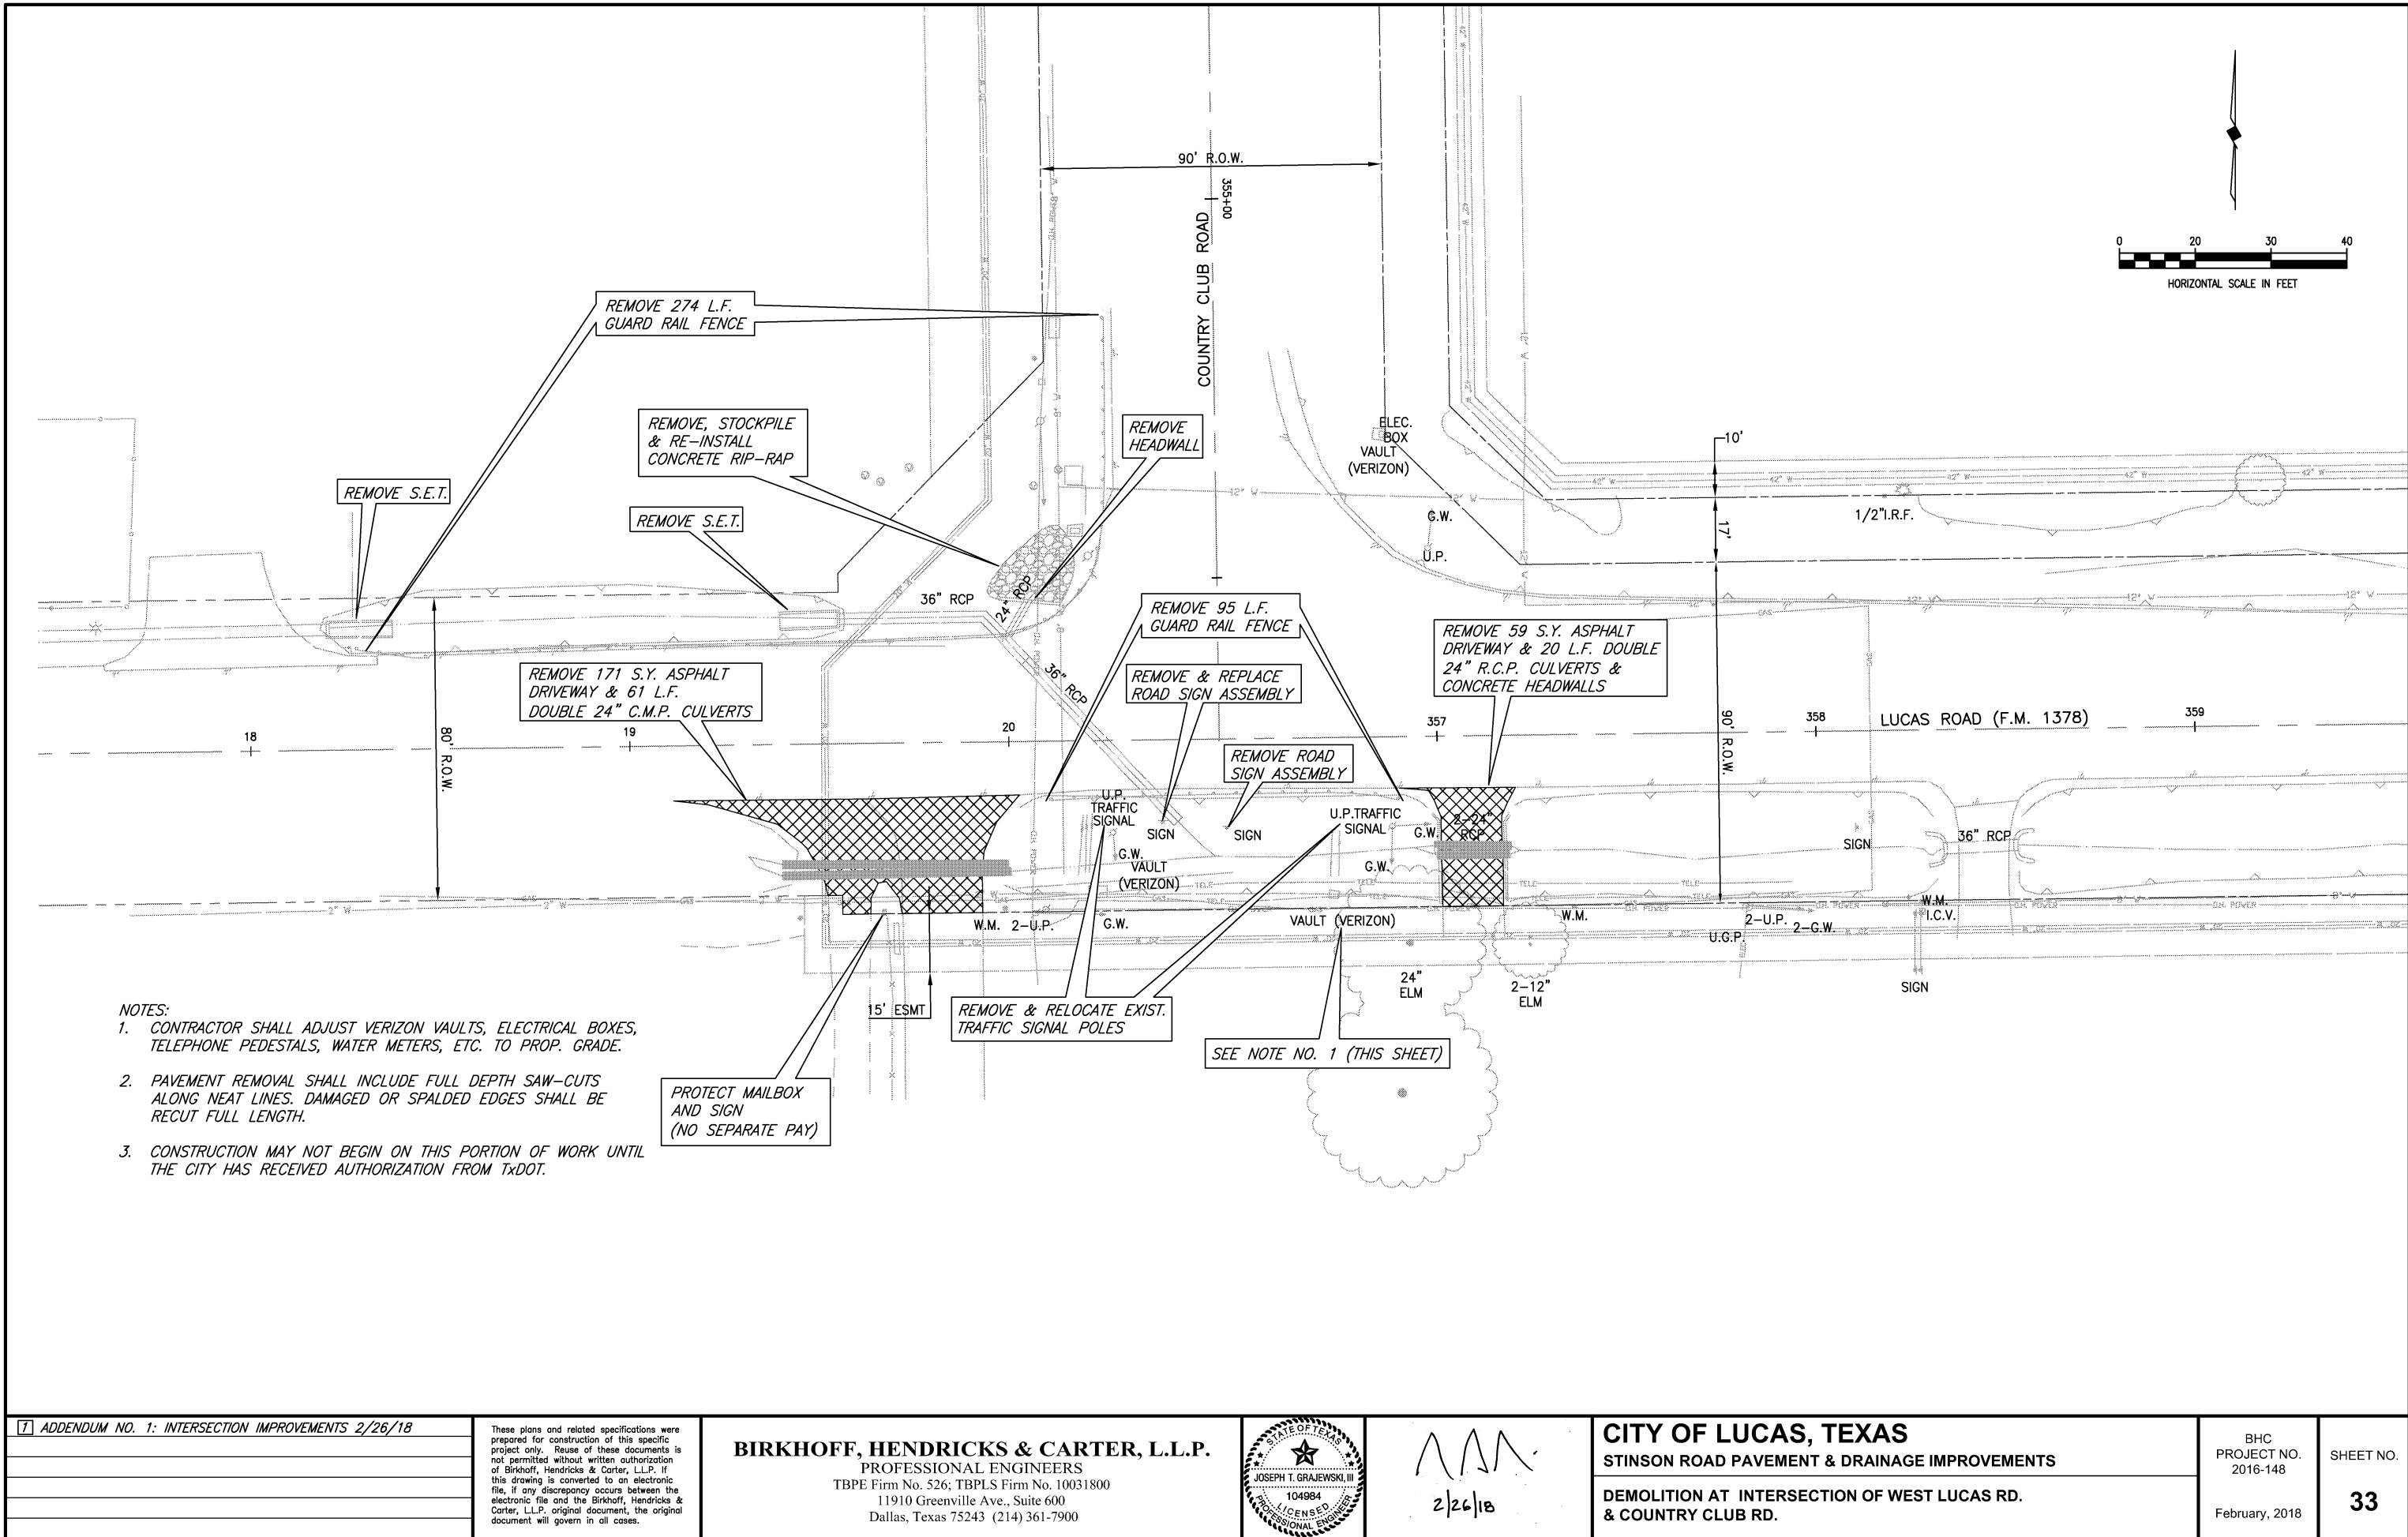


- NOTES:
1. CONTRACTOR SHALL ADJUST VERIZON VAULTS, ELECTRICAL BOXES, TELEPHONE PEDESTALS, WATER METERS, ETC. TO PROP. GRADE.
 2. PAVEMENT REMOVAL SHALL INCLUDE FULL DEPTH SAW-CUTS ALONG NEAT LINES. DAMAGED OR SPALDED EDGES SHALL BE RECUT FULL LENGTH.
 3. CONSTRUCTION MAY NOT BEGIN ON THIS PORTION OF WORK UNTIL THE CITY HAS RECEIVED AUTHORIZATION FROM TxDOT.

7	ADDENDUM NO. 1: INTERSECTION IMPROVEMENTS 2/26/18

These plans and related specifications were prepared for construction of this specific project only. Reuse of these documents is not permitted without written authorization of Birkhoff, Hendricks & Carter, L.L.P. If this drawing is converted to an electronic file, if any discrepancy occurs between the electronic file and the Birkhoff, Hendricks & Carter, L.L.P. original document, the original document will govern in all cases.

BIRKHOFF, HENDRICKS & CARTER, L.L.P.
PROFESSIONAL ENGINEERS
TBPE Firm No. 526; TBPLS Firm No. 10031800
11910 Greenville Ave., Suite 600
Dallas, Texas 75243 (214) 361-7900

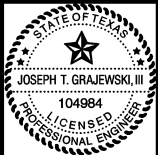






Signature
2/26/18


CITY OF LUCAS, TEXAS
STINSON ROAD PAVEMENT & DRAINAGE IMPROVEMENTS
DEMOLITION AT INTERSECTION OF WEST LUCAS RD. & COUNTRY CLUB RD.

BHC
PROJECT NO.
2016-148
February, 2018

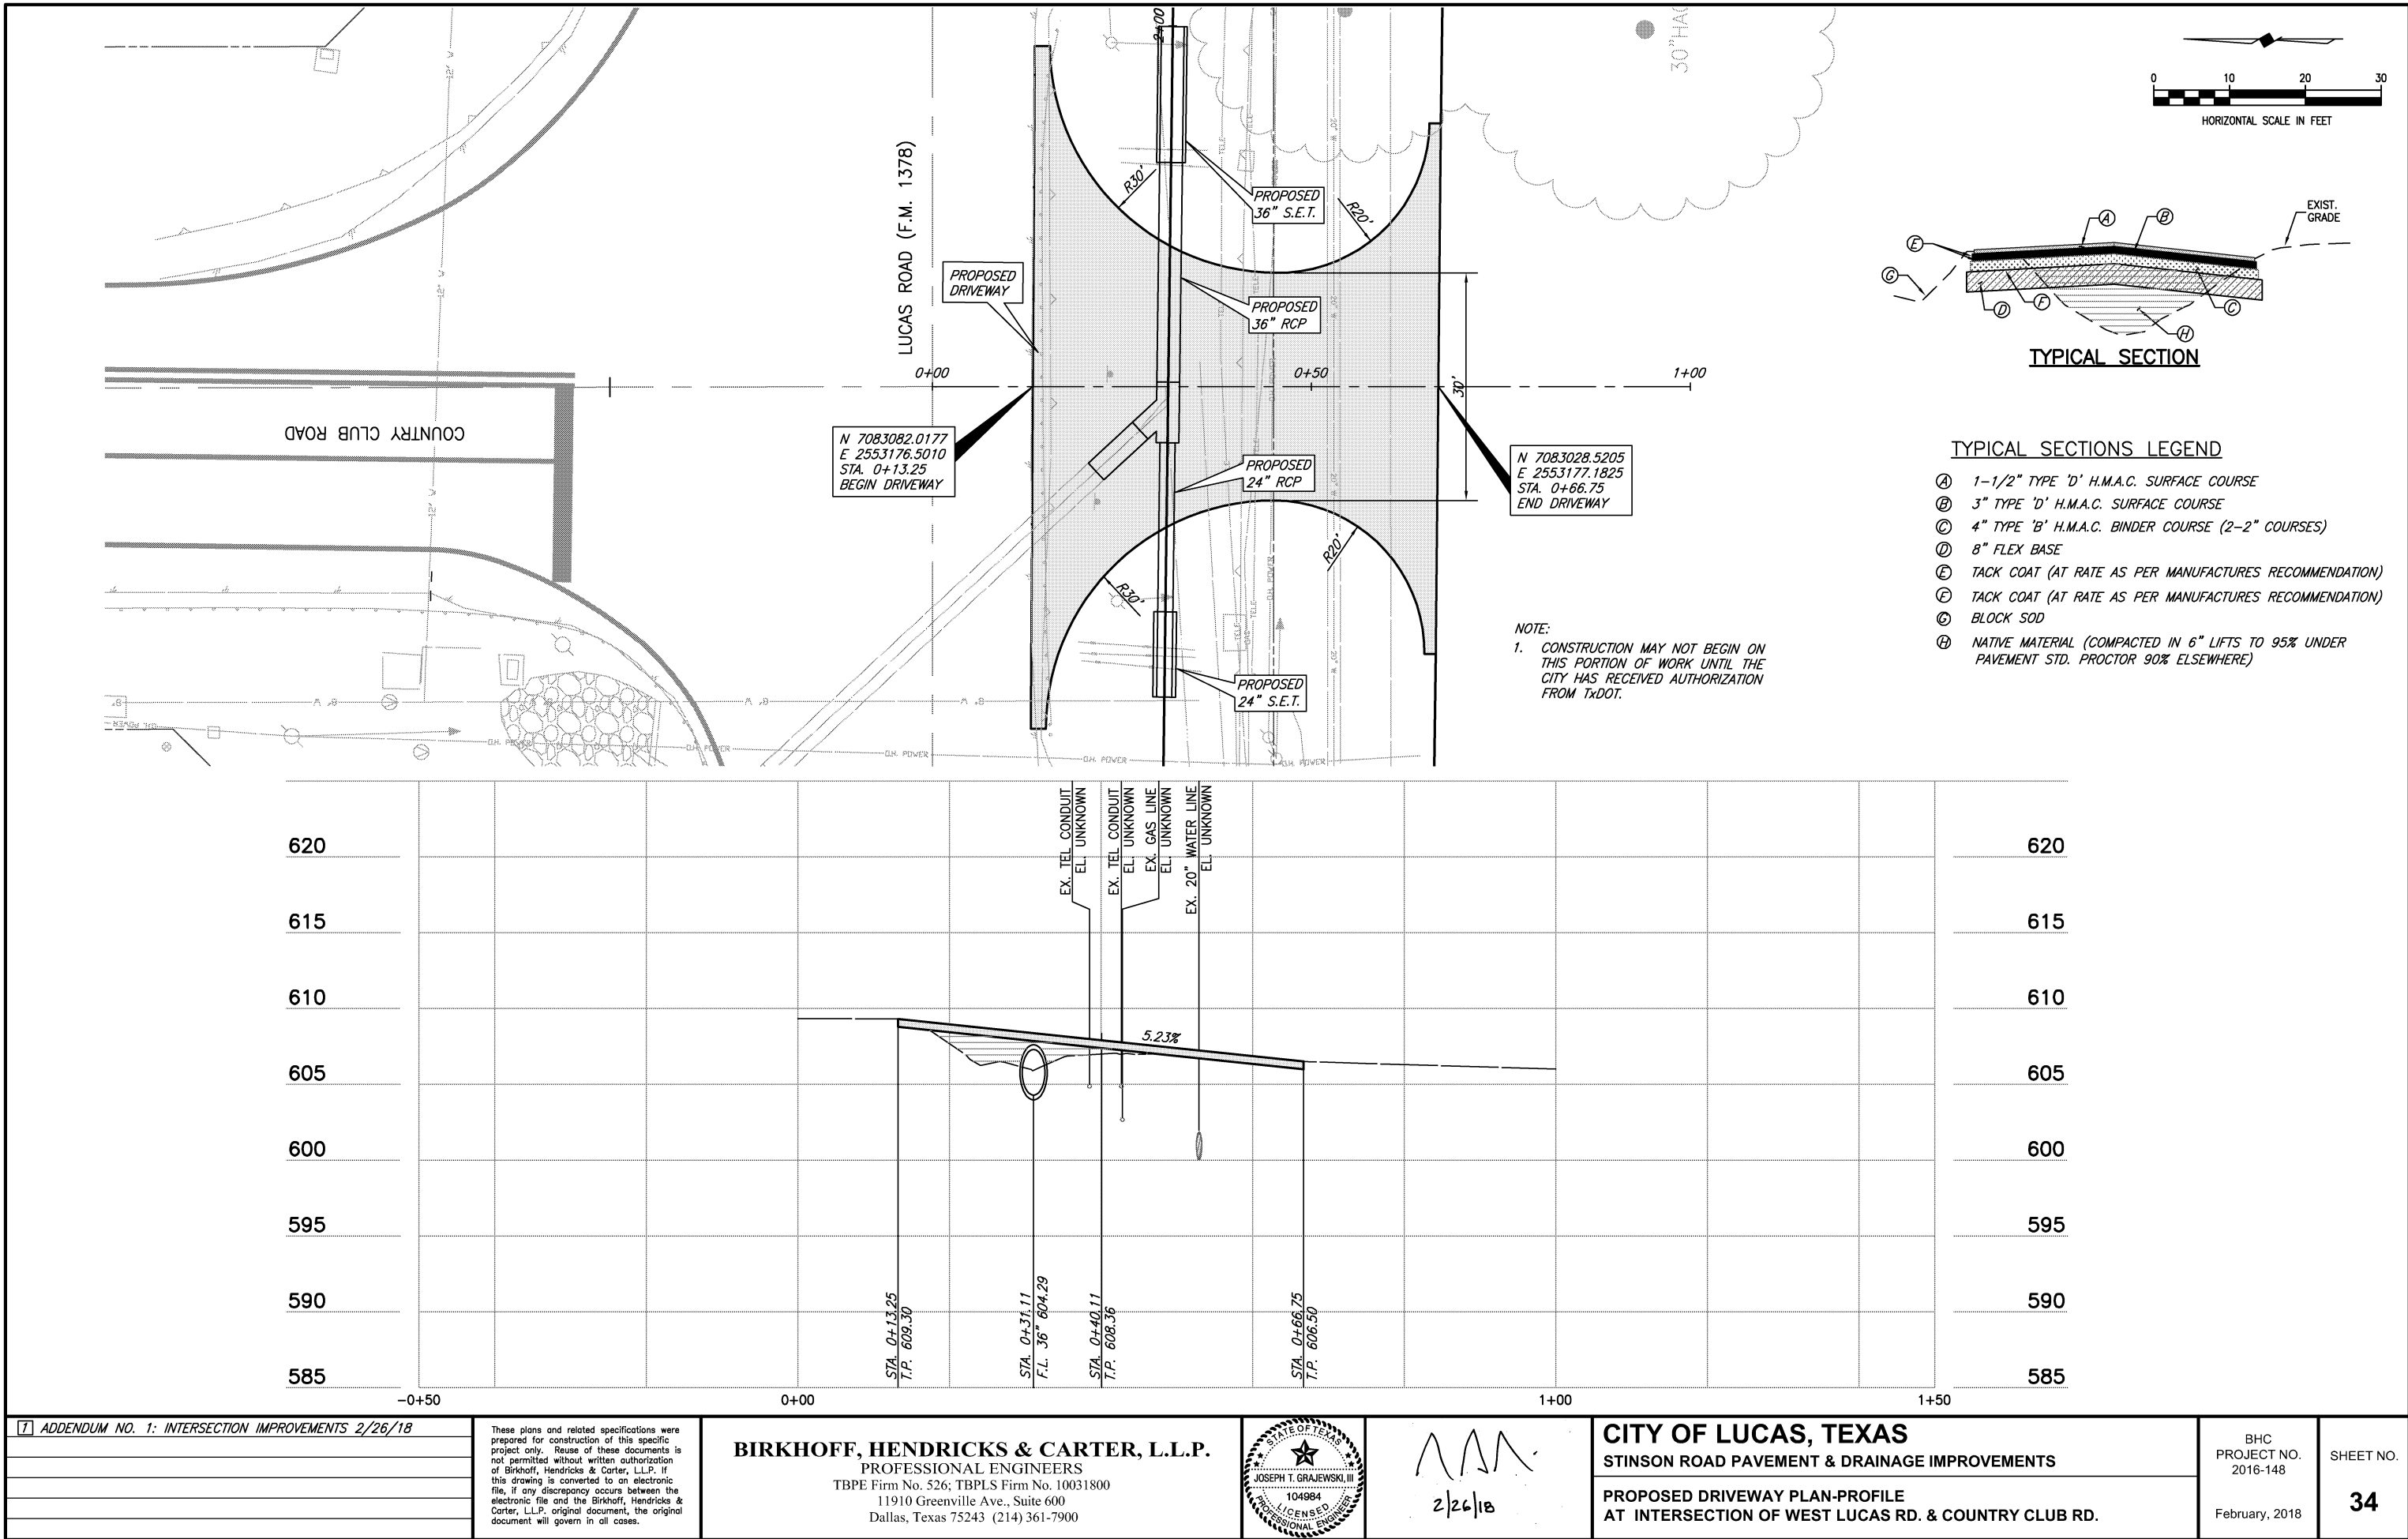

SHEET NO.
33

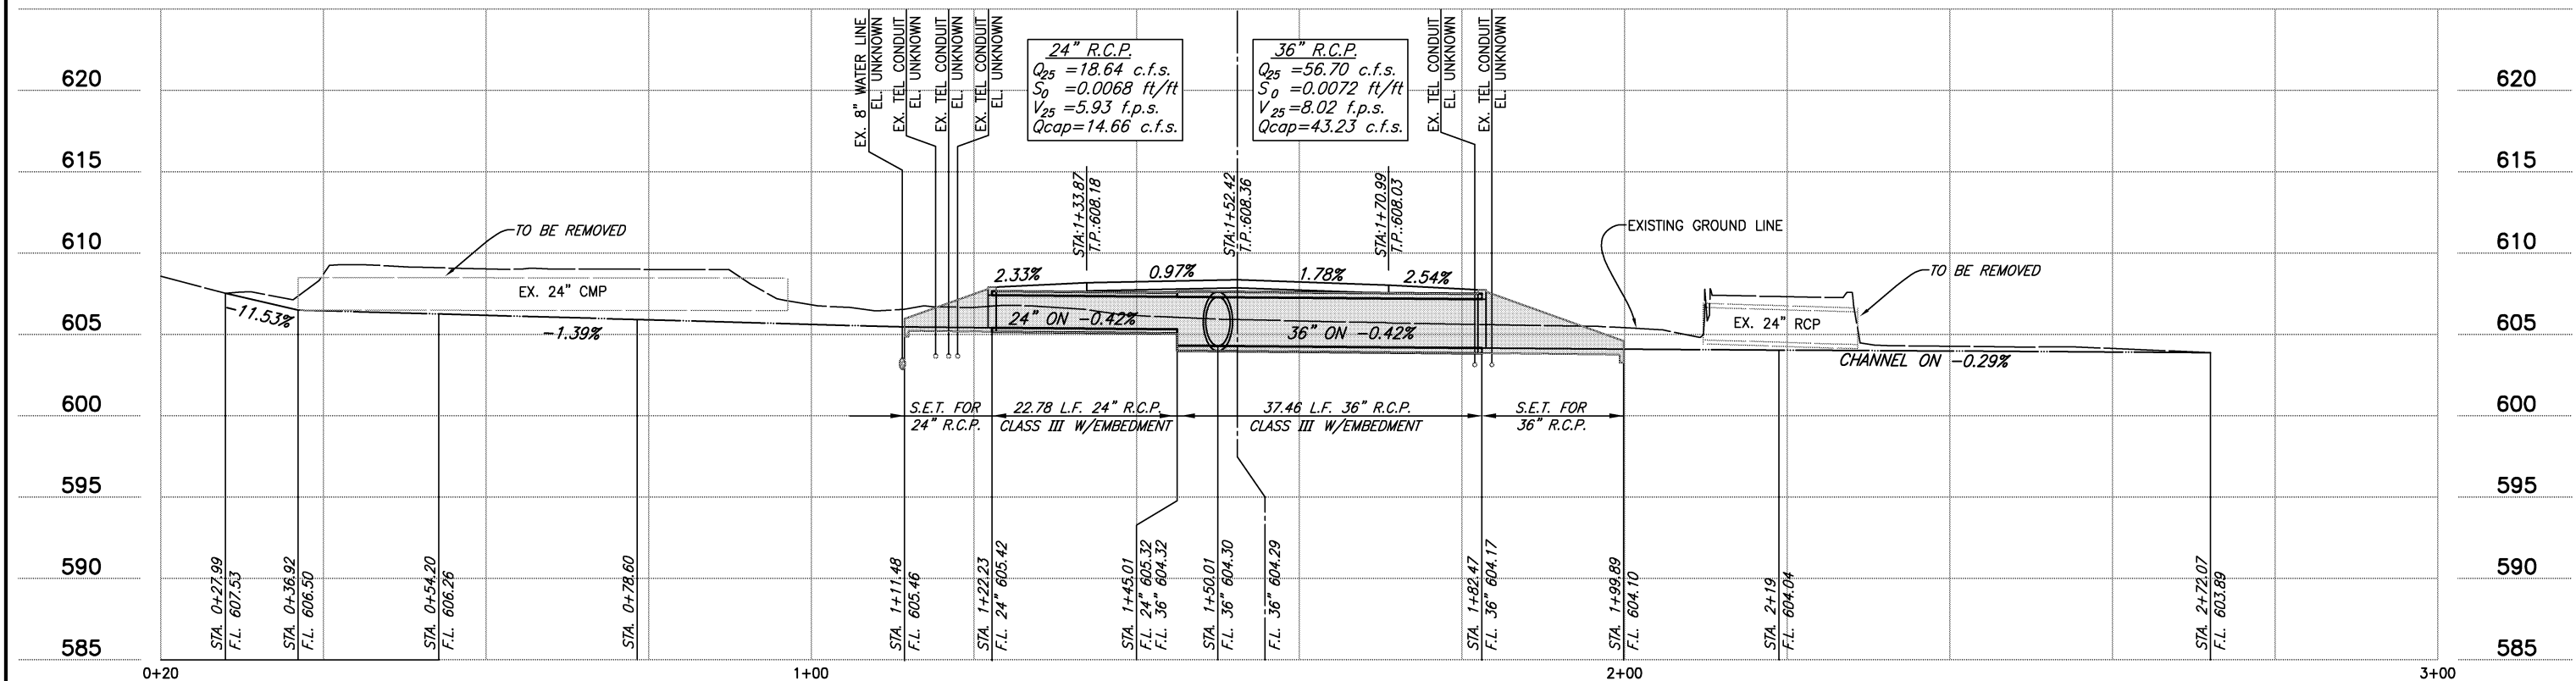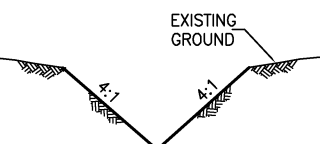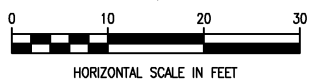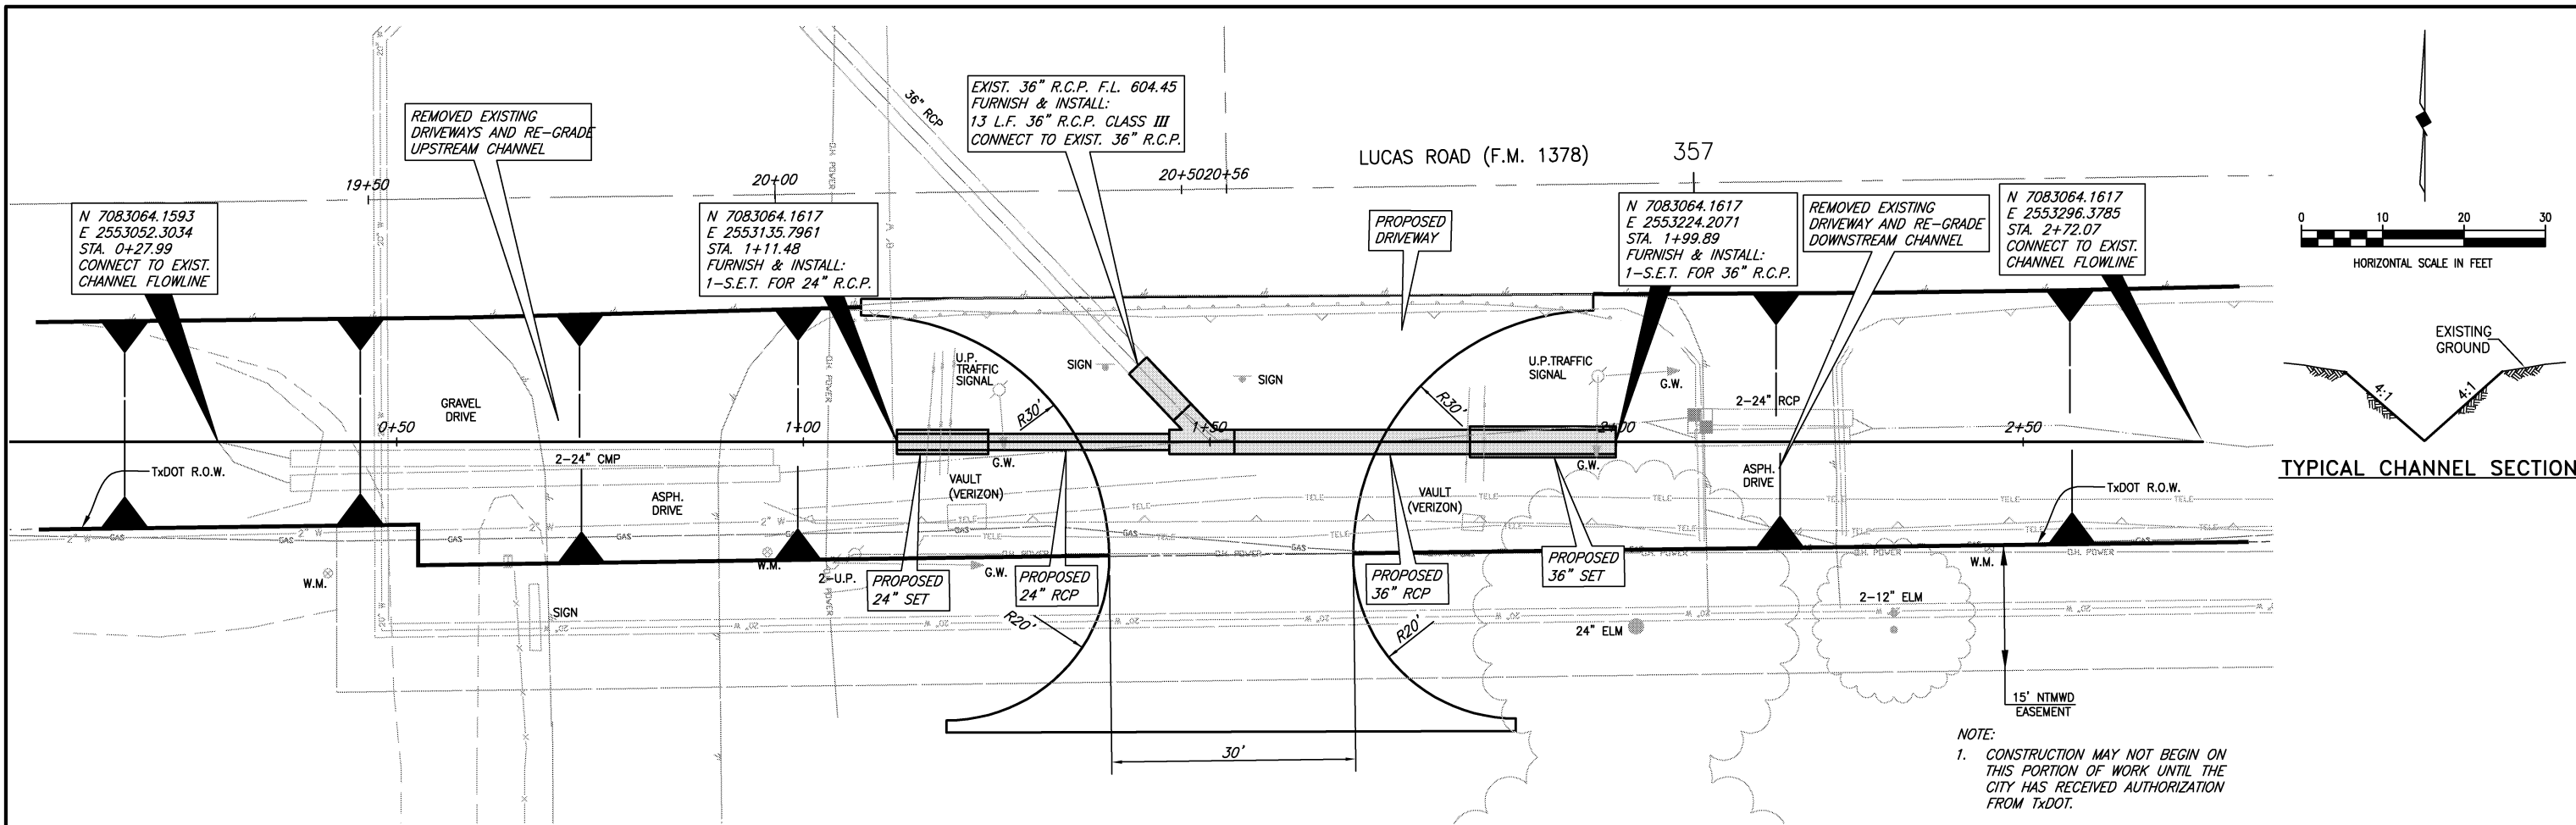


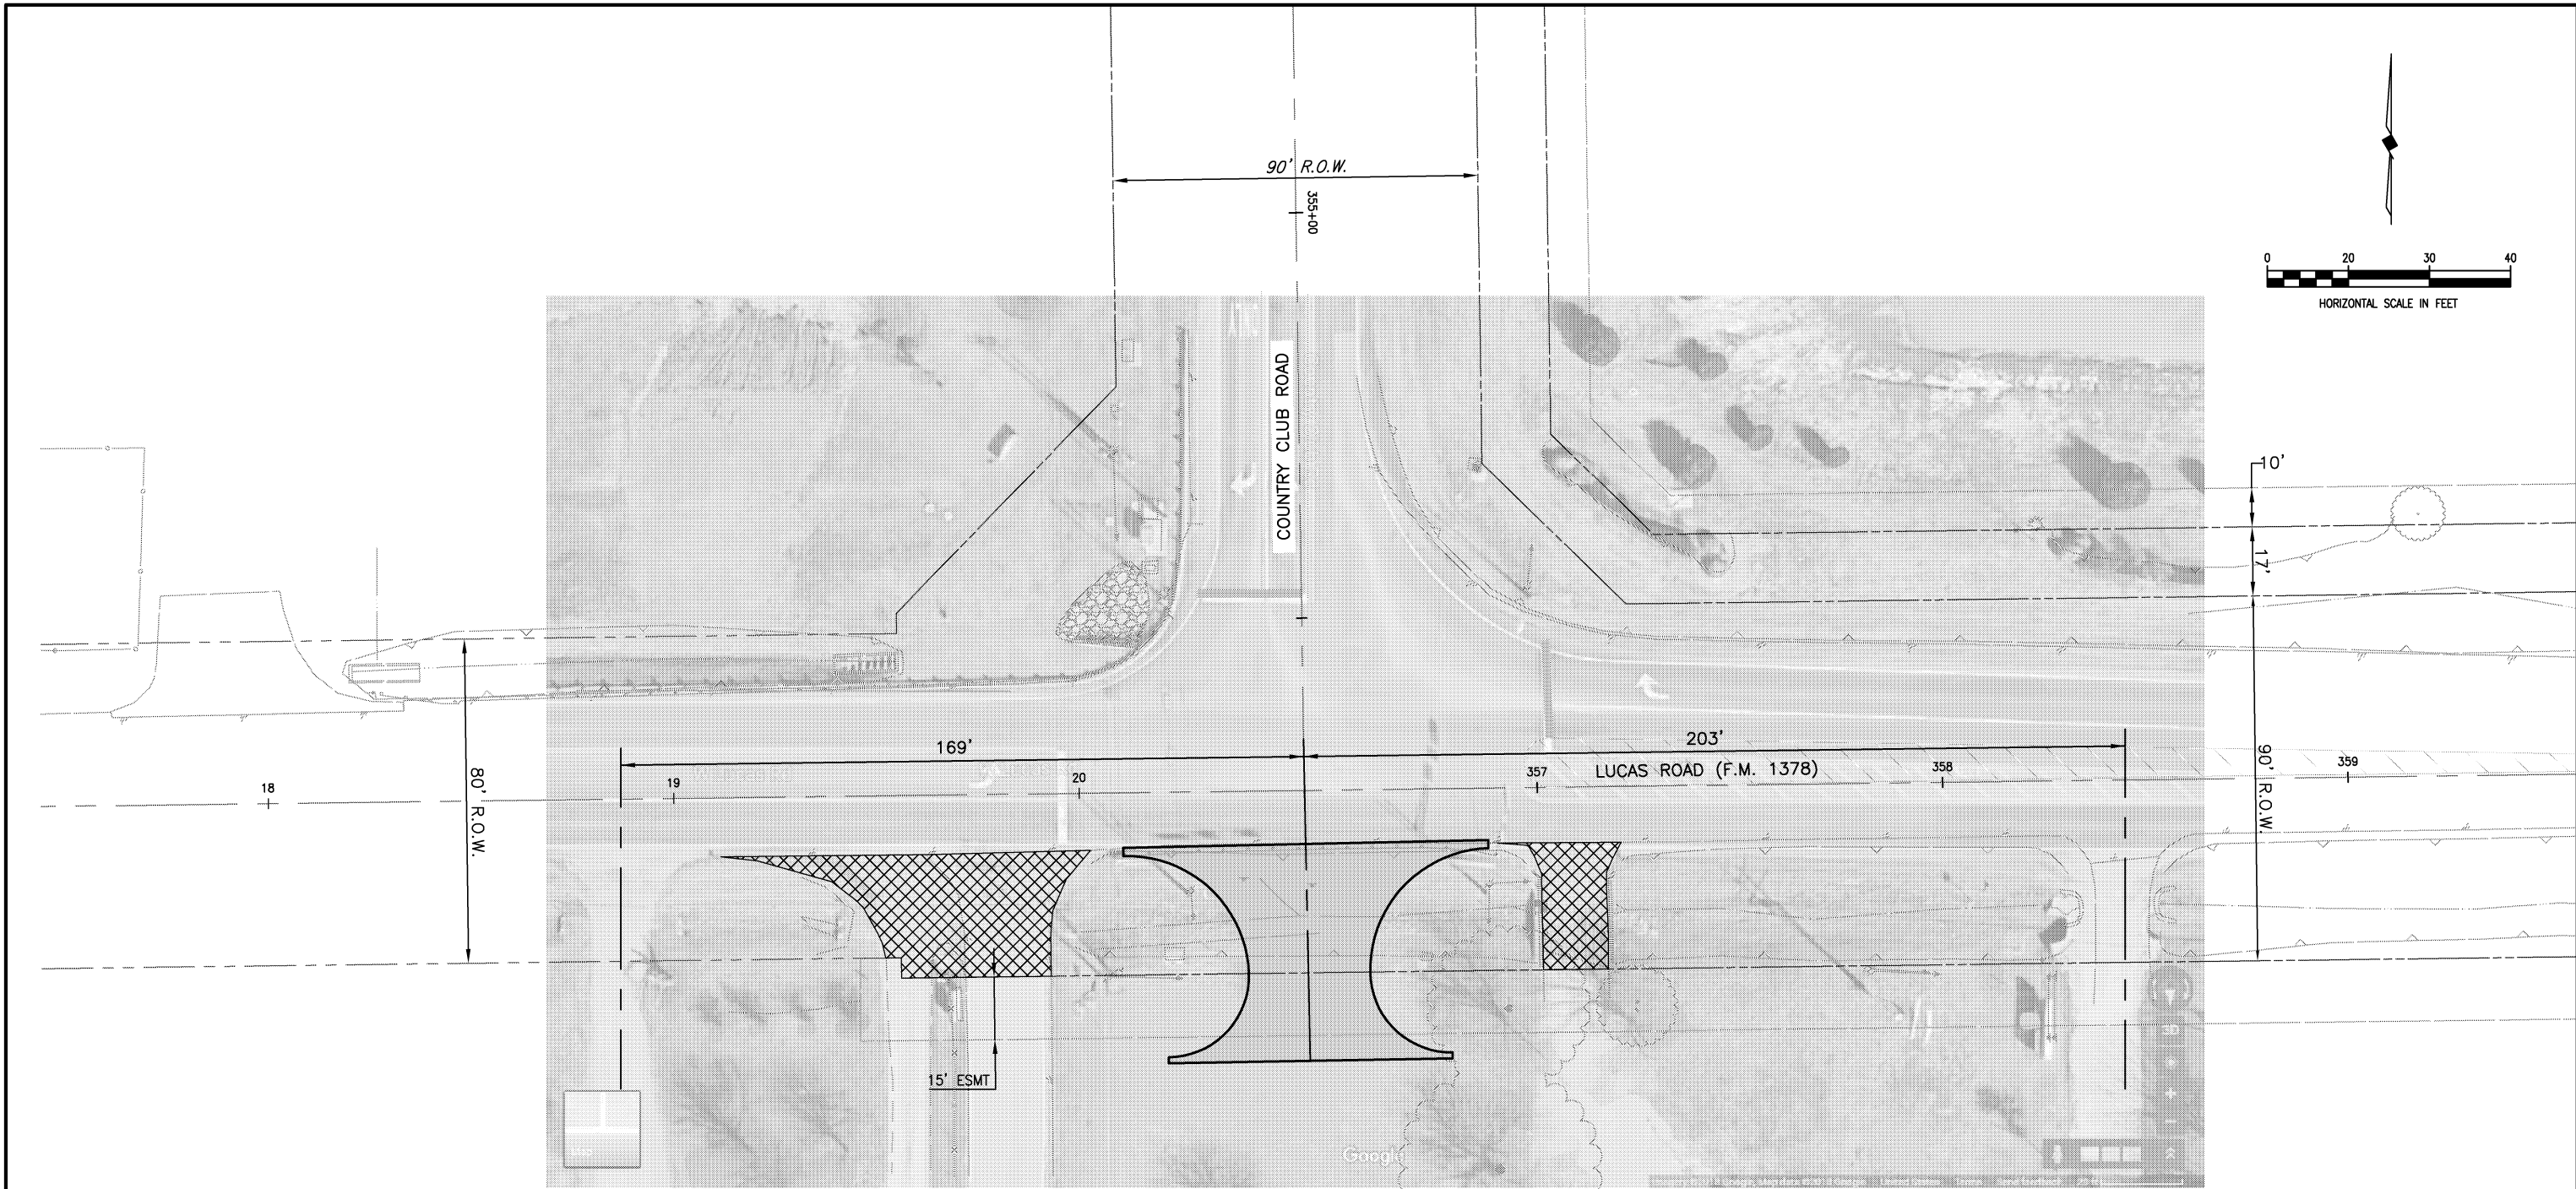
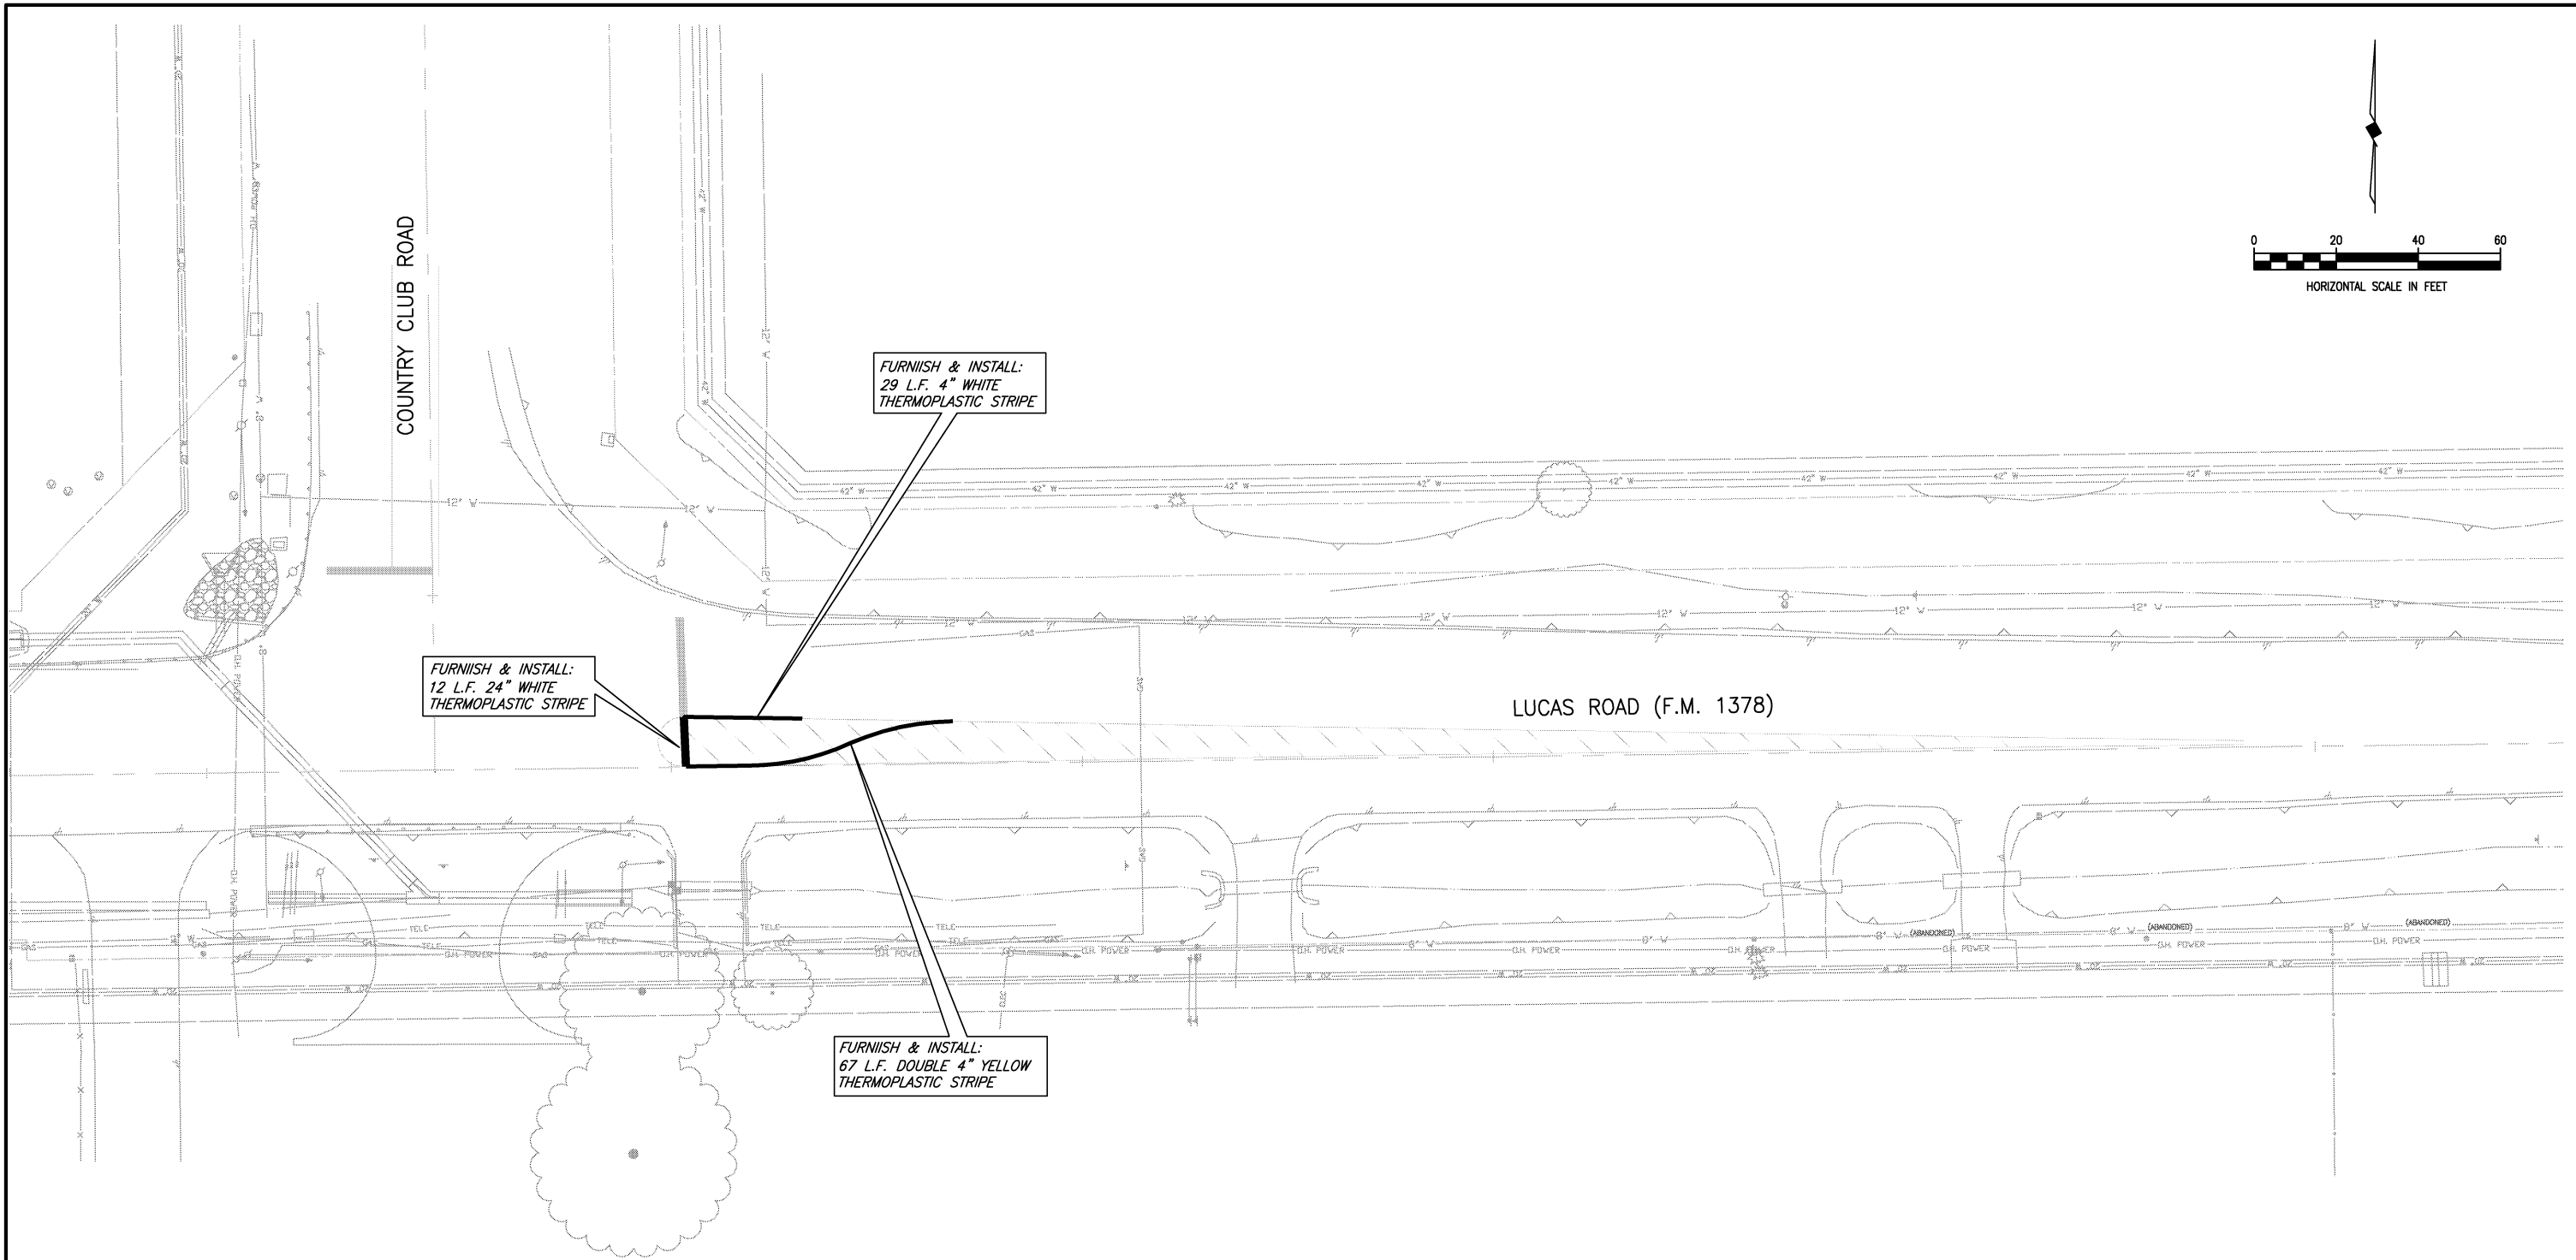




LEGEND

-  PROPOSED PAVEMENT
-  EXIST. PAVEMENT (TO BE REMOVED)
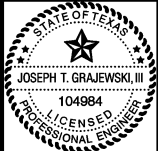
<div><div>7</div><div>ADDENDUM NO. 1: INTERSECTION IMPROVEMENTS 2/26/18</div></div> <div></div> <div></div> <div></div> <div></div>	<p>These plans and related specifications were prepared for construction of this specific project only. Reuse of these documents is not permitted without written authorization of Birkhoff, Hendricks & Carter, L.L.P. If this drawing is converted to an electronic file, if any discrepancy occurs between the electronic file and the Birkhoff, Hendricks & Carter, L.L.P. original document, the original document will govern in all cases.</p>	<p>BIRKHOFF, HENDRICKS & CARTER, L.L.P. PROFESSIONAL ENGINEERS TBPE Firm No. 526; TBPLS Firm No. 10031800 11910 Greenville Ave., Suite 600 Dallas, Texas 75243 (214) 361-7900</p>		 2/26/18	<p>CITY OF LUCAS, TEXAS STINSON ROAD PAVEMENT & DRAINAGE IMPROVEMENTS</p> <p>EXISTING DRIVEWAY LOCATION EXHIBIT</p>	<p>BHC PROJECT NO. 2016-148 February, 2018</p>	<p>SHEET NO. 36</p>
---	---	--	---	--	--	---	-------------------------------------



- NOTES:**
1. CONTRACTOR SHALL REMOVE EXISTING STRIPING WITHIN PROPOSED LEFT TURN LANE.
 2. ALL PAVEMENT MARKINGS SHALL BE IN CONFORMANCE WITH TXDOT DETAIL PM(3)-12.

<div><div>7</div><div>ADDENDUM NO. 1: INTERSECTION IMPROVEMENTS 2/26/18</div></div>	<div>These plans and related specifications were prepared for construction of this specific project only. Reuse of these documents is not permitted without written authorization of Birkhoff, Hendricks & Carter, L.L.P. If this drawing is converted to an electronic file, if any discrepancy occurs between the electronic file and the Birkhoff, Hendricks & Carter, L.L.P. original document, the original document will govern in all cases.</div>	<div><div>BIRKHOFF, HENDRICKS & CARTER, L.L.P.</div><div>PROFESSIONAL ENGINEERS</div><div>TBPE Firm No. 526; TBPLS Firm No. 10031800</div><div>11910 Greenville Ave., Suite 600</div><div>Dallas, Texas 75243 (214) 361-7900</div></div>	<div><div>STATE OF TEXAS</div><div>JOSEPH T. GRAJEWSKI, III</div><div>104984</div><div>PROFESSIONAL ENGINEER</div></div>	<div><div>2/26/18</div></div>	<div><div>CITY OF LUCAS, TEXAS</div><div>STINSON ROAD PAVEMENT & DRAINAGE IMPROVEMENTS</div><div>PROPOSED PAVEMENT MARKINGS</div><div>WESTBOUND F.M. 1378</div></div>	<div><div>BHC</div><div>PROJECT NO.</div><div>2016-148</div><div>February, 2018</div></div>	<div><div>SHEET NO.</div><div>38</div></div>
---	---	--	--	-------------------------------	---	---	--