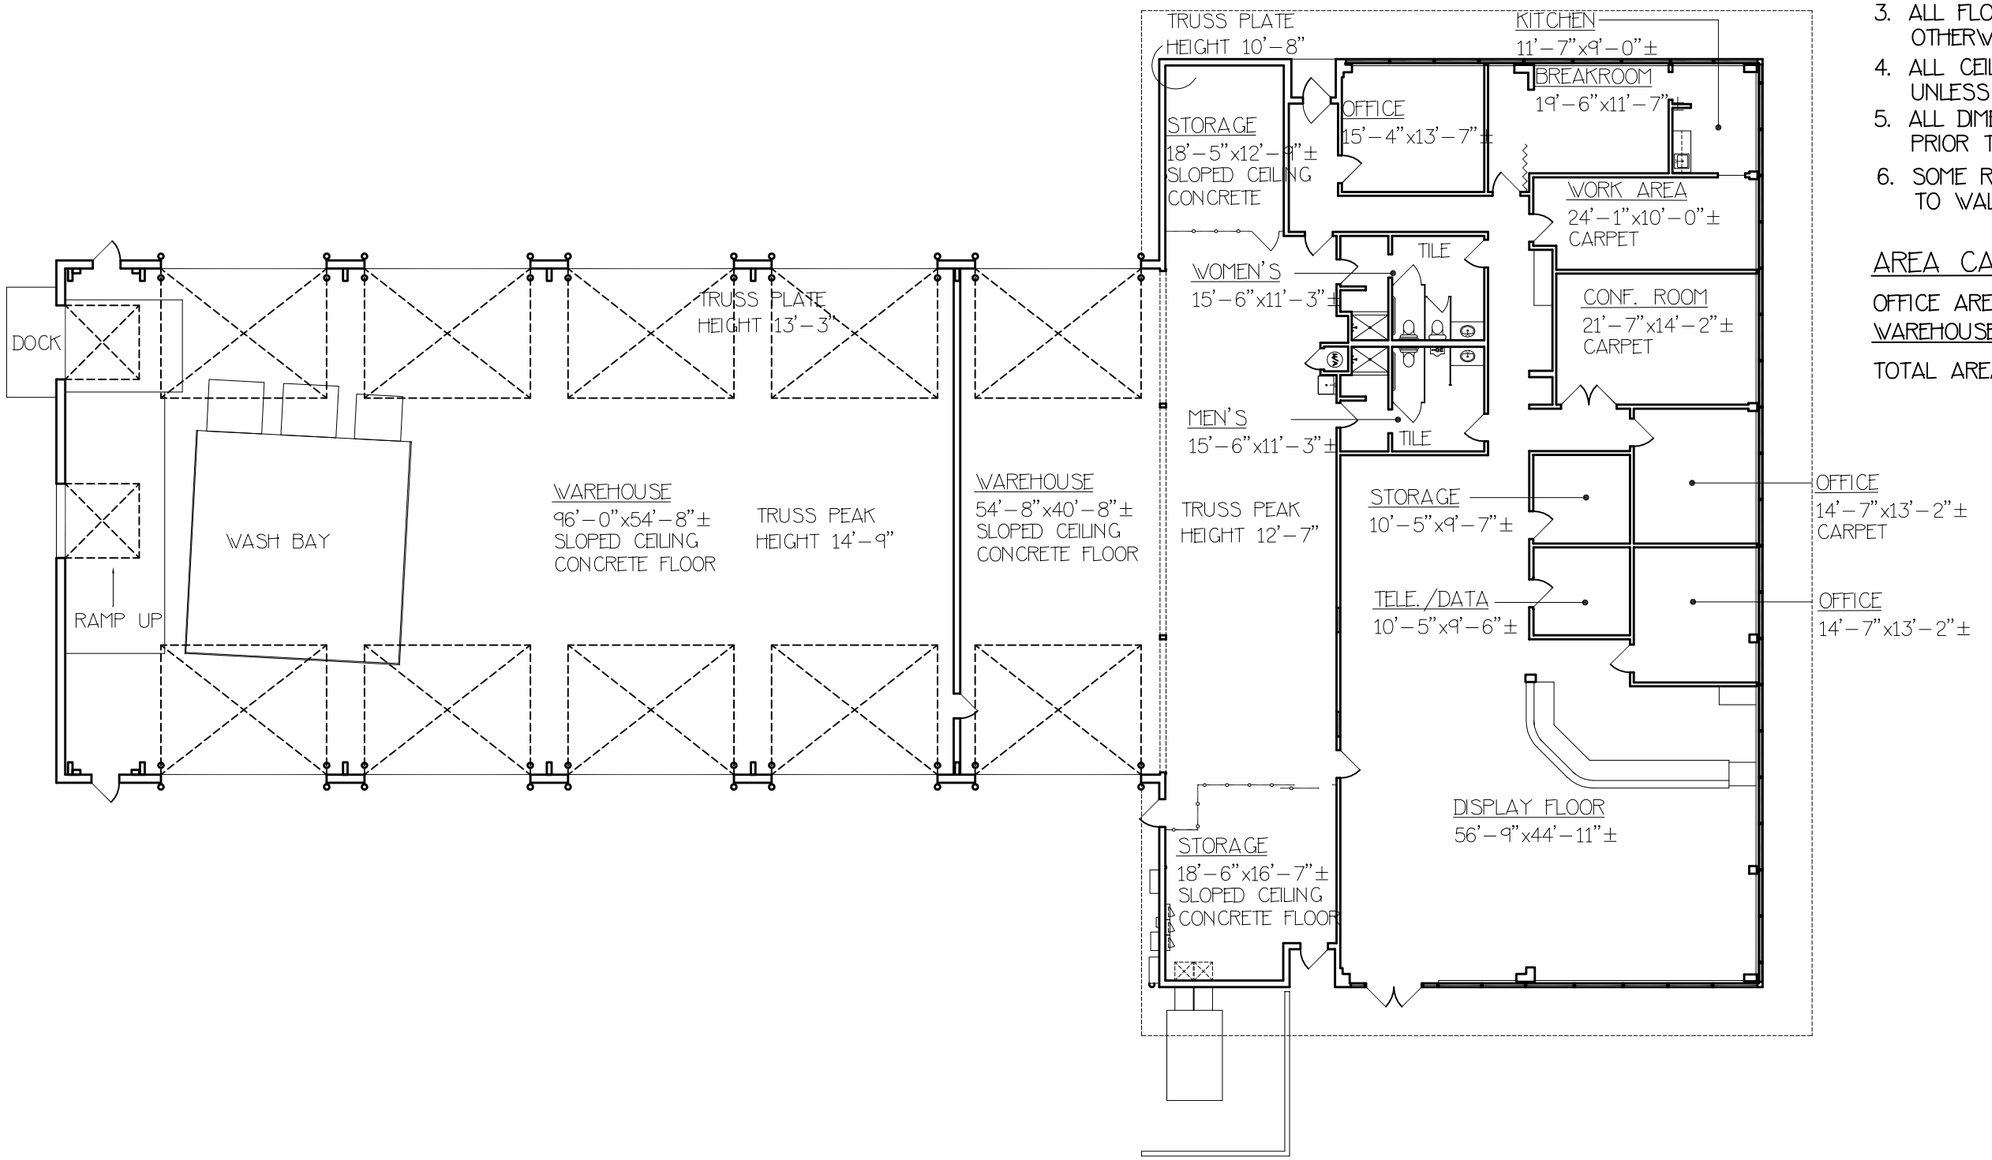


NOTES

1. ALL CALCULATIONS INDICATE "GROSS" AREA AS PER "BOMA" STANDARDS.
2. ALL FIXTURES INDICATED ARE BUILT-IN.
3. ALL FLOORS ARE VINYL UNLESS OTHERWISE INDICATED.
4. ALL CEILING HEIGHTS ARE 9'-0" UNLESS OTHERWISE NOTED.
5. ALL DIMENSIONS TO BE FIELD VERIFIED PRIOR TO ANY CONSTRUCTION.
6. SOME ROOM DIMENSIONS WILL VARY DUE TO WALLS BEING OUT OF PLUMB.

AREA CALCULATIONS:

OFFICE AREA	4673.40 SQ. FT.
WAREHOUSE AREA	8546.87 SQ. FT.
TOTAL AREA	13220.27 SQ. FT.

PROJECT:
2516
CAMINO ENTRADA
SANTA FE
NEW MEXICO

DESCRIPTION:
AS-BUILT
DRAWING

CLIENT:
PHASE ONE
REALTY

SHEET # 01 OF 01

ORIENTATION	MEASURED BY	P.M.	REFERENCE # 1603
	DESIGNED BY	N.A.	
	DRAFTED BY	P.M.	
	CHECKED BY	M.G.	
	REVISED:		
SCALE 1/16"=1'-0"	DATE 10/17/14		

YCD DESIGNS
505-899-1199