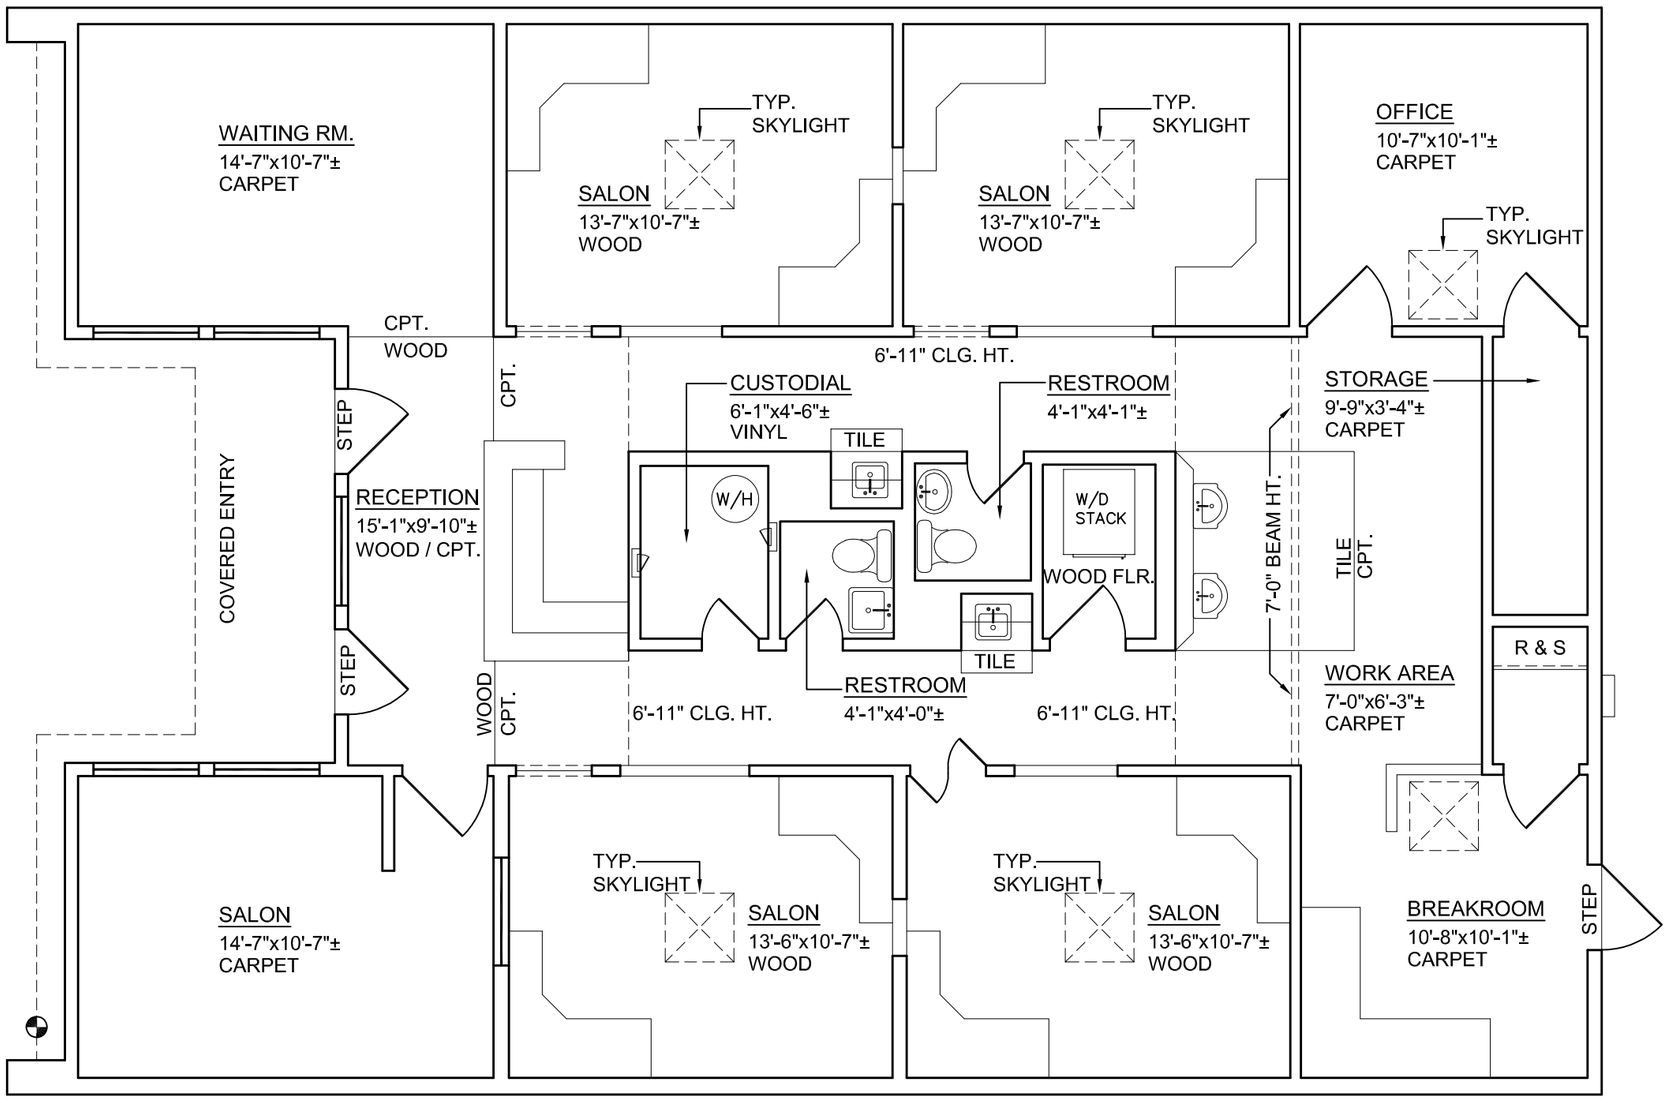



4008 CARLISLE BLVD. NE

## NOTES

1. ALL CALCULATIONS INDICATE "GROSS" AREA AS PER "BOMA" STANDARDS.
2. ALL FIXTURES INDICATED ARE BUILT-IN.
3. ALL FLOORS ARE TILE UNLESS OTHERWISE INDICATED.
4. ALL CEILING HEIGHTS ARE 8'-0" UNLESS OTHERWISE NOTED.
5. ALL DIMENSIONS TO BE FIELD VERIFIED PRIOR TO ANY CONSTRUCTION.

## AREA CALCULATIONS:

GROSS BLDG. AREA 1,931.91 SQ. FT.

PROJECT:
4008 CARLISLE BLVD. NE

DESCRIPTION:
AS-BUILT DRAWING

CLIENT:
SENTINEL REAL ESTATE INVESTMENT

SHEET # 01 OF 01

| | | |
|---|---|---|
| ORIENTATION | MEASURED BY | JR |
| | DESIGNED BY | N.A. |
| | DRAFTED BY | JR |
| | CHECKED BY | M.G. |
| | REVISED: | |
| SCALE 3/16"=1'-0" | DATE 04/29/26 | |

REFERENCE # 260334

505-899-1199