
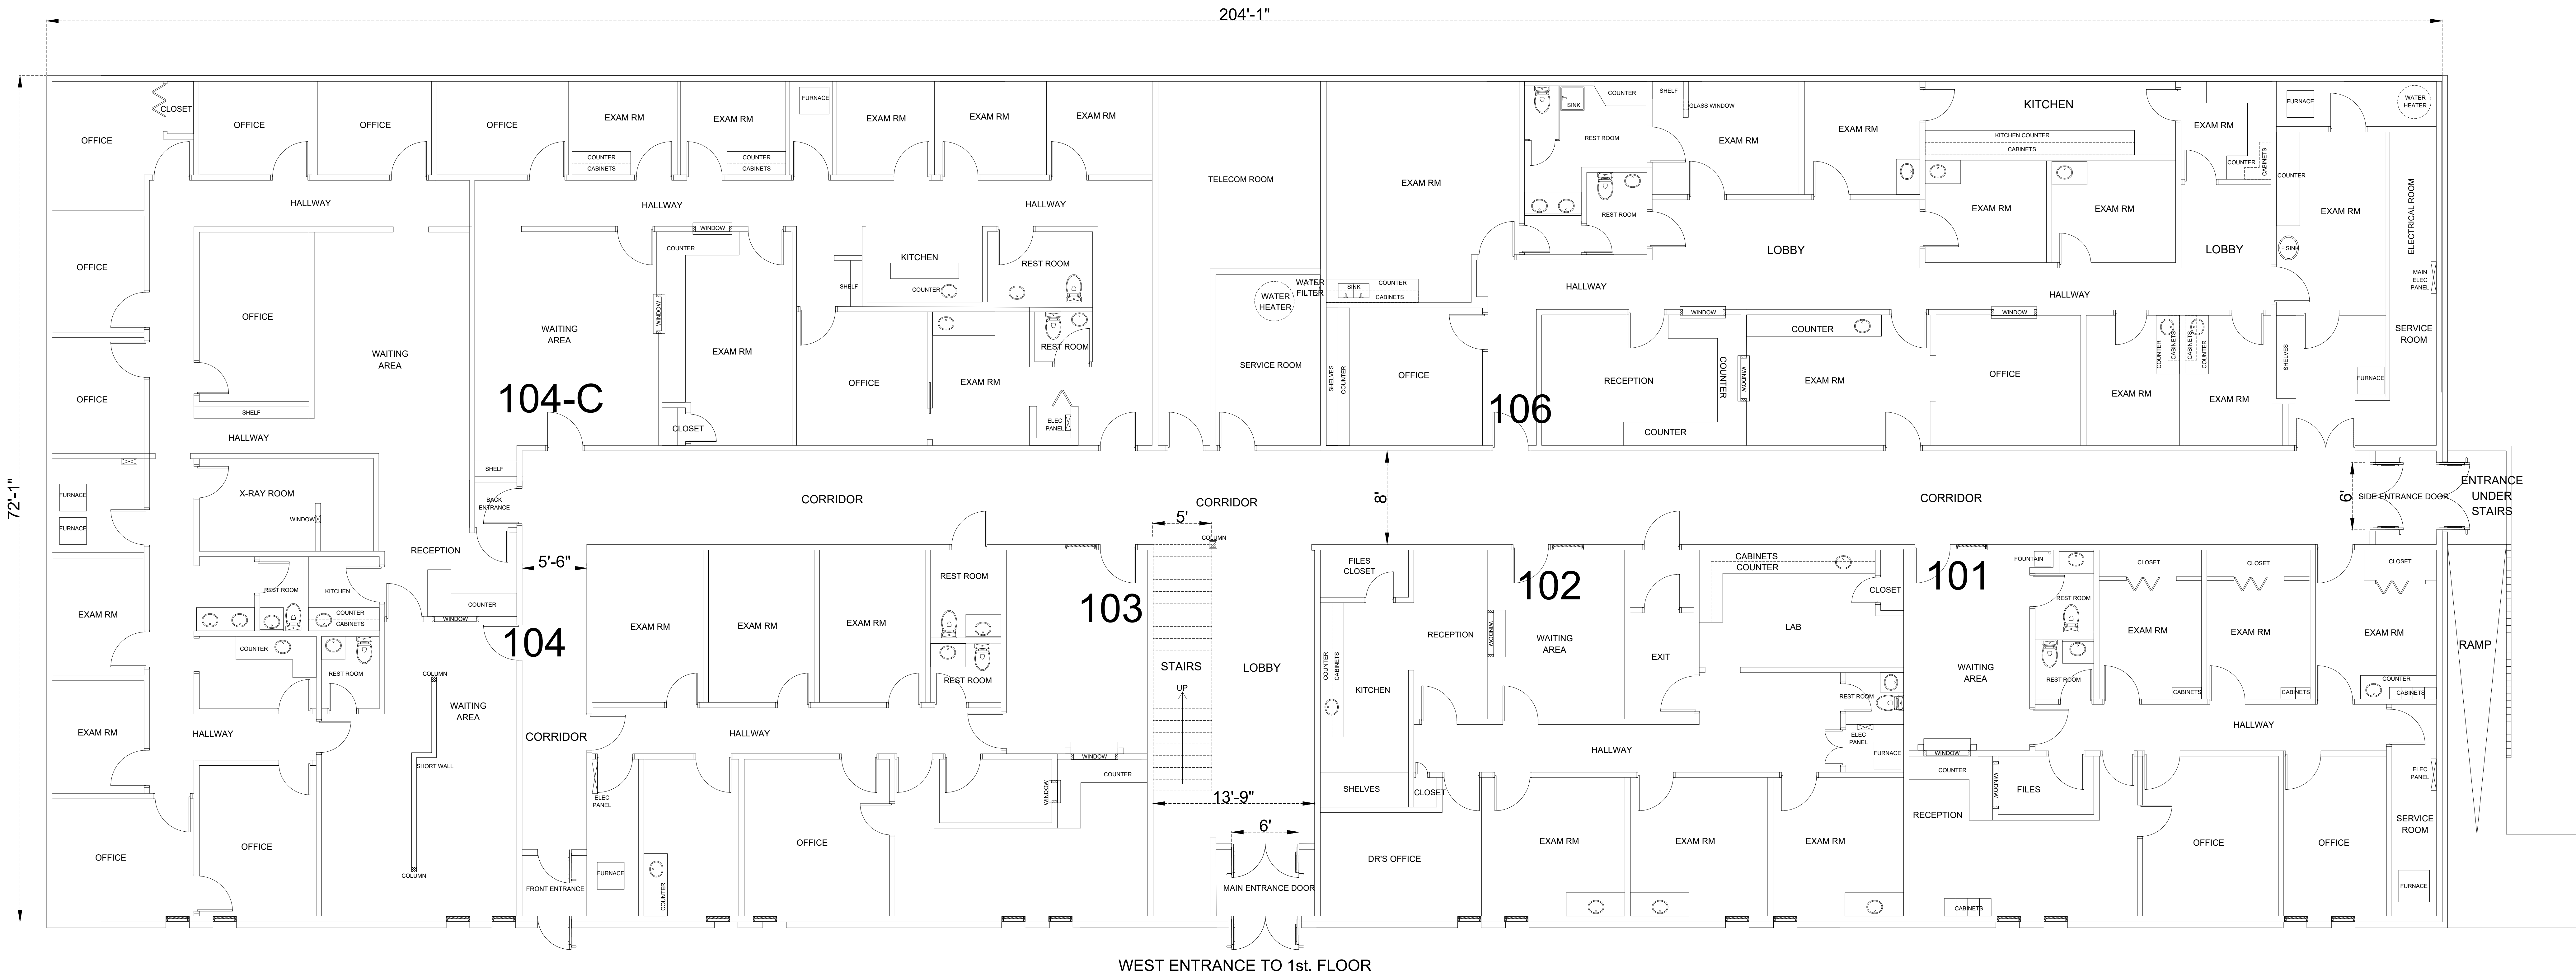


PRINT SIZE 36"X48"

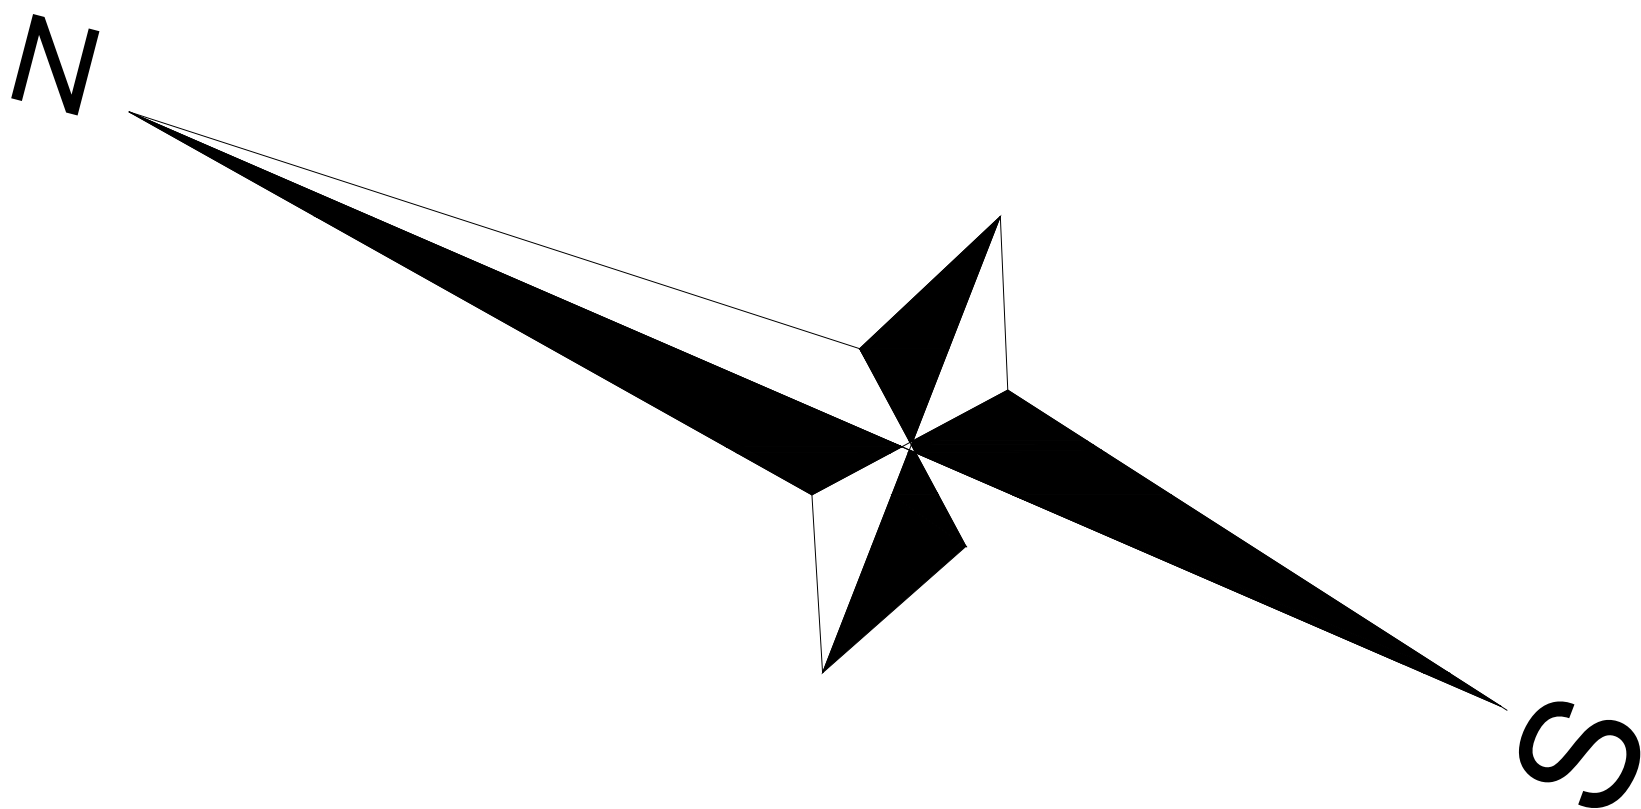

OFFICE NUMBER	AREA SQFT.
101	1,468
102	1,621
103	1,482
104	2,733
104-C	1,898
106	2,996

1ST. FLOOR

All designs are the property of Eng.Samer Shehab & cannot be used without their written permission				
Scale	Drawn	Checked	Authorized	Page
1:60	Samer Shehab	Khalid		1 of 2
File No.	DRAWING NO.	DATE	Revisions	
KJ-24-1	AR-24-03	11-18-2024	0	

Project Title:


INDIANA CLINICS

Plan description :


AS-BUILT ARCHITECTURAL 1ST. FLOOR

6		
5		
4		
3		
2		
1	ADD OFFICES AREA CHART	11/24/2024
0	FOR REVIEW	11/18/2024
No.	Issue/Submission	Date

Graphic scale:1 inch = 5 ft.

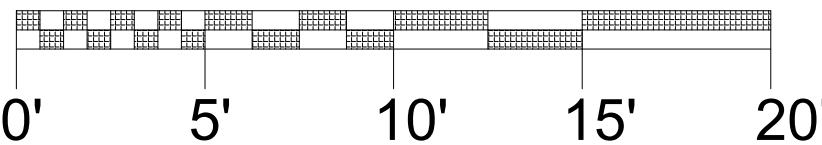

PRINT SIZE 36"X48"

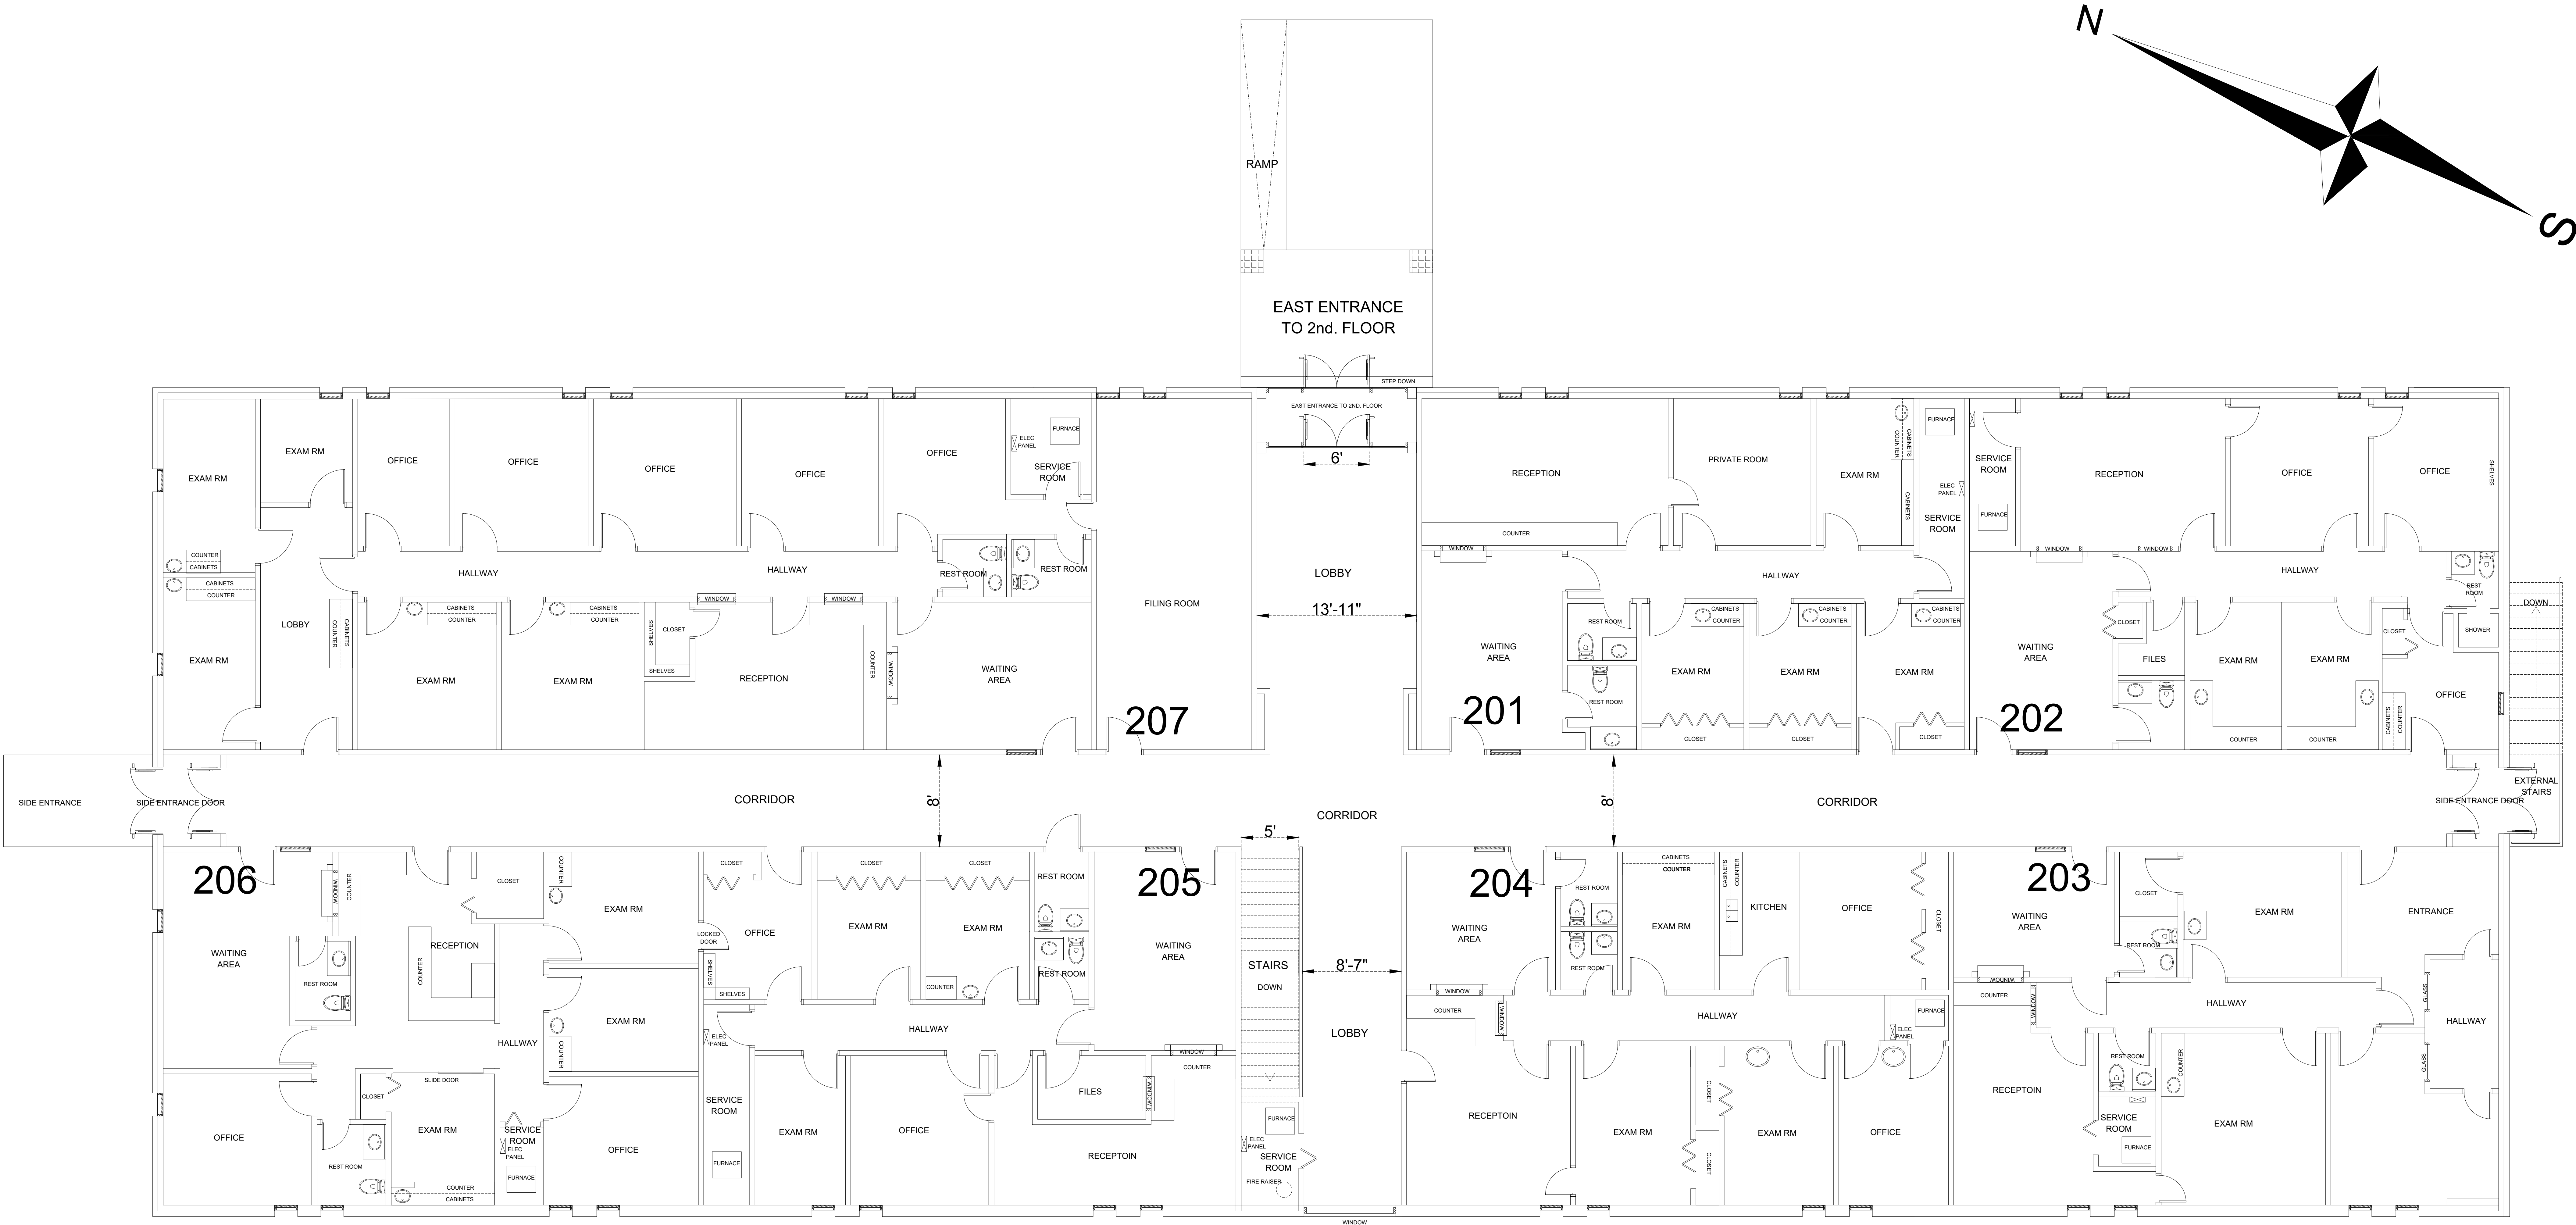

OFFICE NUMBER	AREA SQFT.
201	1,506
202	1,447
203	1,521
204	1,514
205	1,455
206	1,480
207	3,010

2nd. FLOOR

All designs are the property of Eng.Samer Shehab & cannot be used without their written permission				
Scale	Drawn	Checked	Authorized	Page
1:60	Samer Shehab	Khalid		2 of 2
File No.	DRAWING NO.	DATE	Revisions	
KJ-24-1	AR-24-03	11-18-2024	0	

Project Title:	INDIANA CLINICS		
Plan description :	AS-BUILT ARCHITECTURAL 2ND. FLOOR		
No.	Issue/Submission	Date	
6			
5			
4			
3			
2			
1	ADD OFFICES AREA CHART	11/24/2024	
0	FOR REVIEW	11/18/2024	

