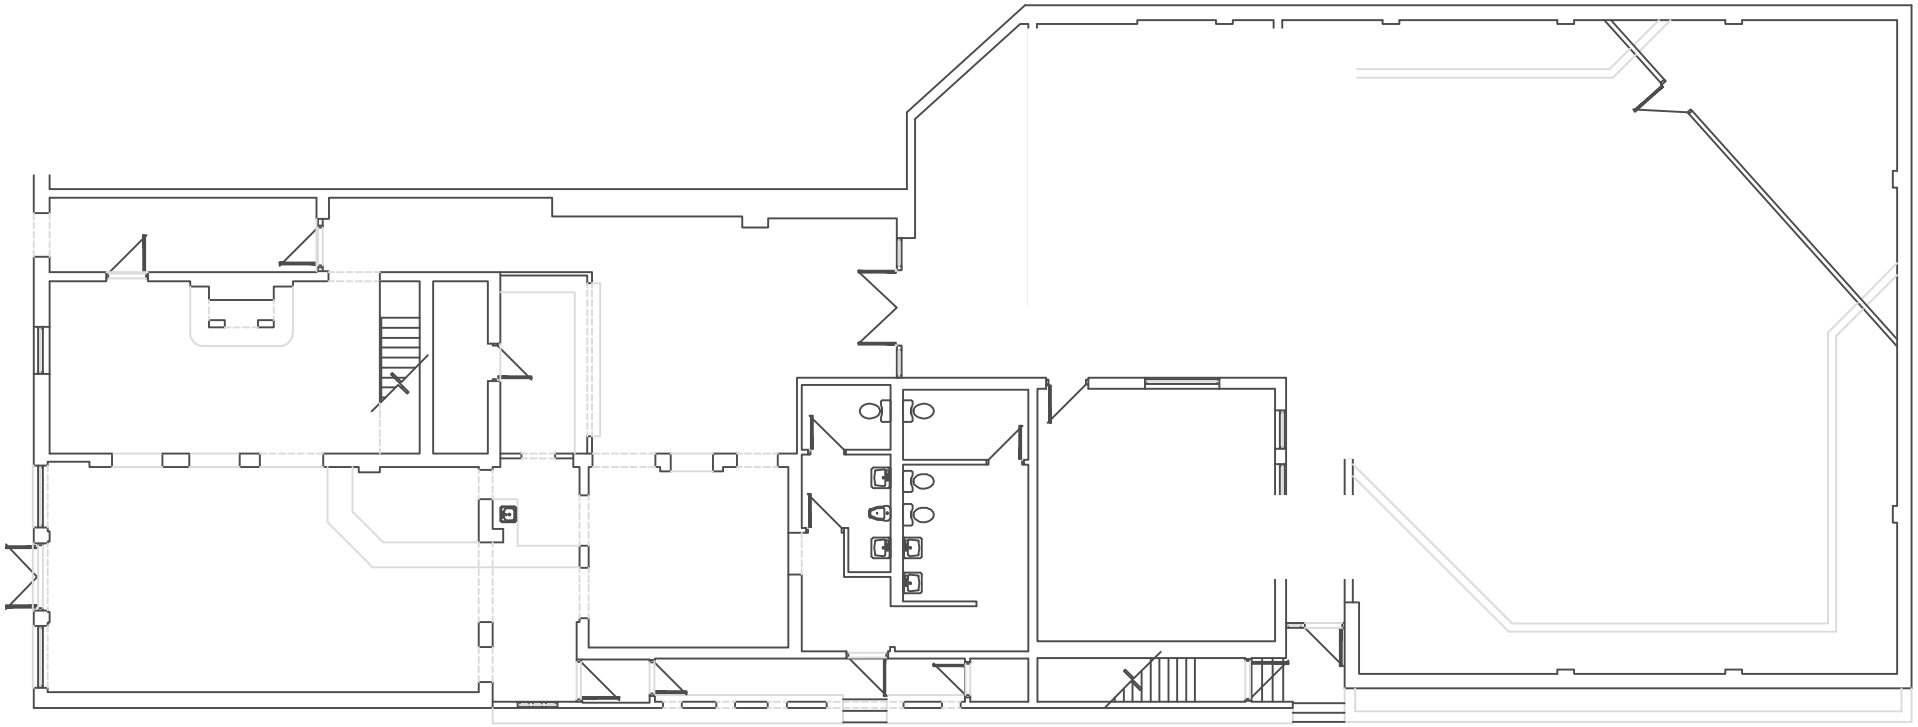

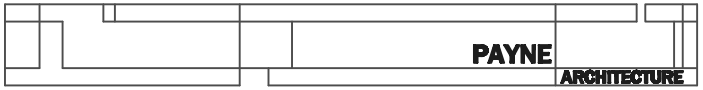

4050 Westport Road Suite 206 Louisville, Kentucky 40207 Tel 502.609.4940 PAYNEARCHITECTURE@gmail.com

FIRST FLOOR