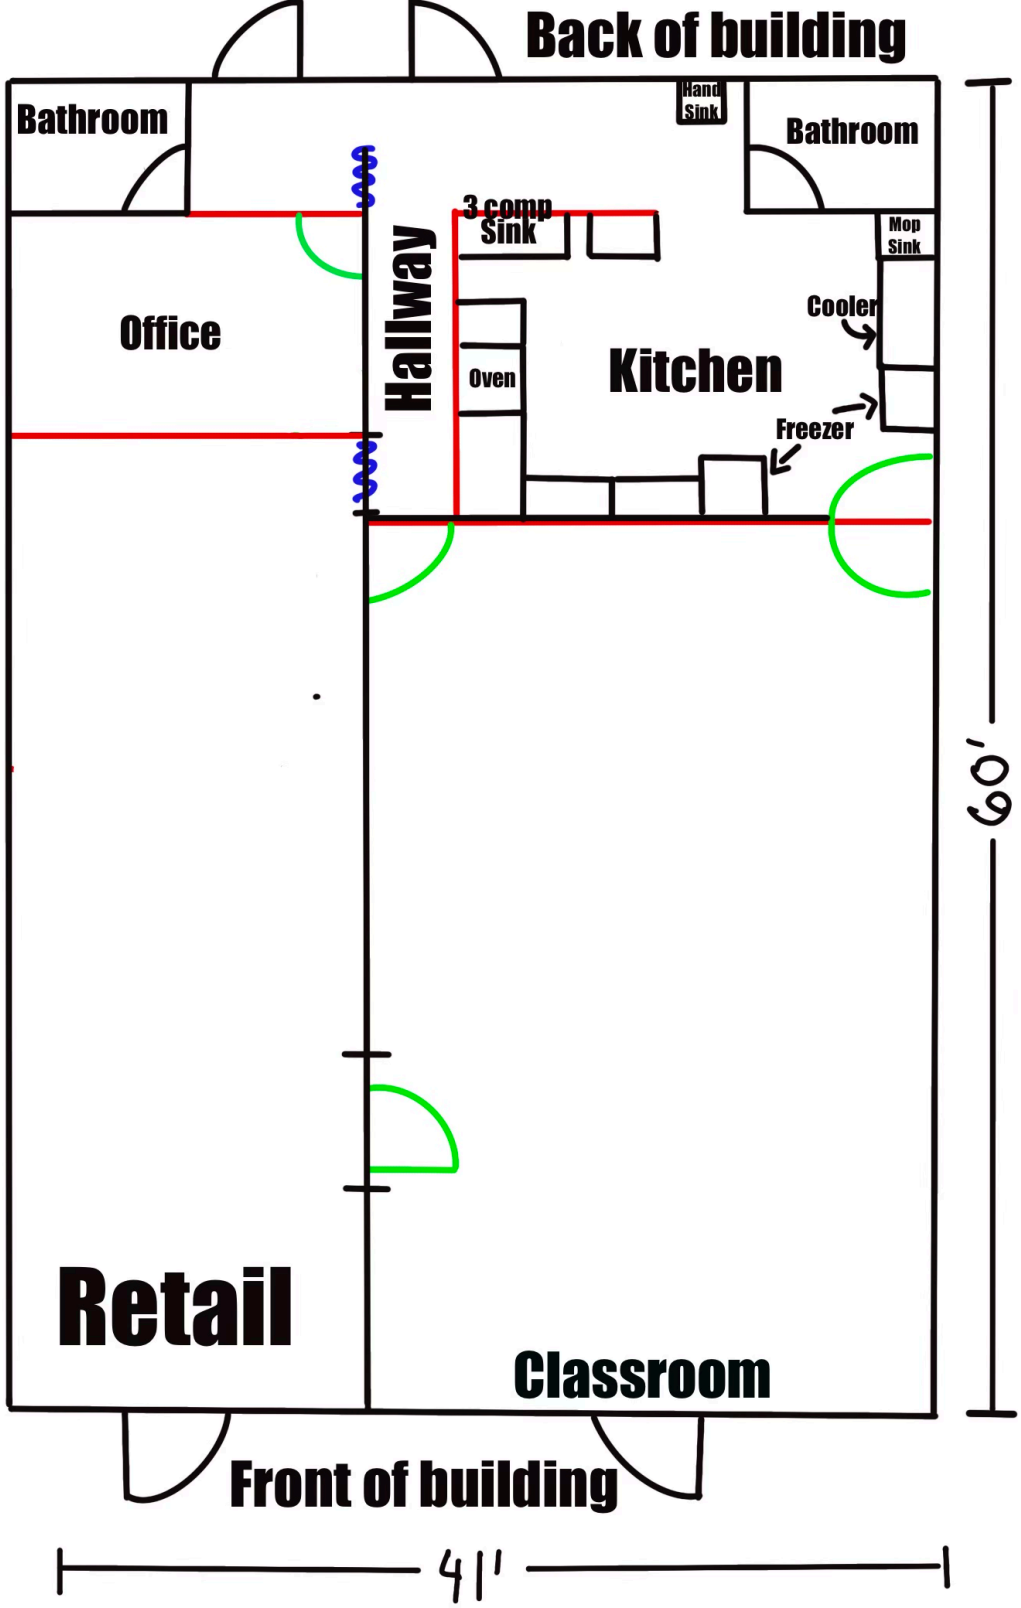
Back of building
Bathroom
Hand Sink
Bathroom
3 comp Sink
Mop Sink
Office
Hallway
Cooler
Oven
Kitchen
Freezer
60'
Retail
Classroom
Front of building
41'