8300 Earhart Expressway

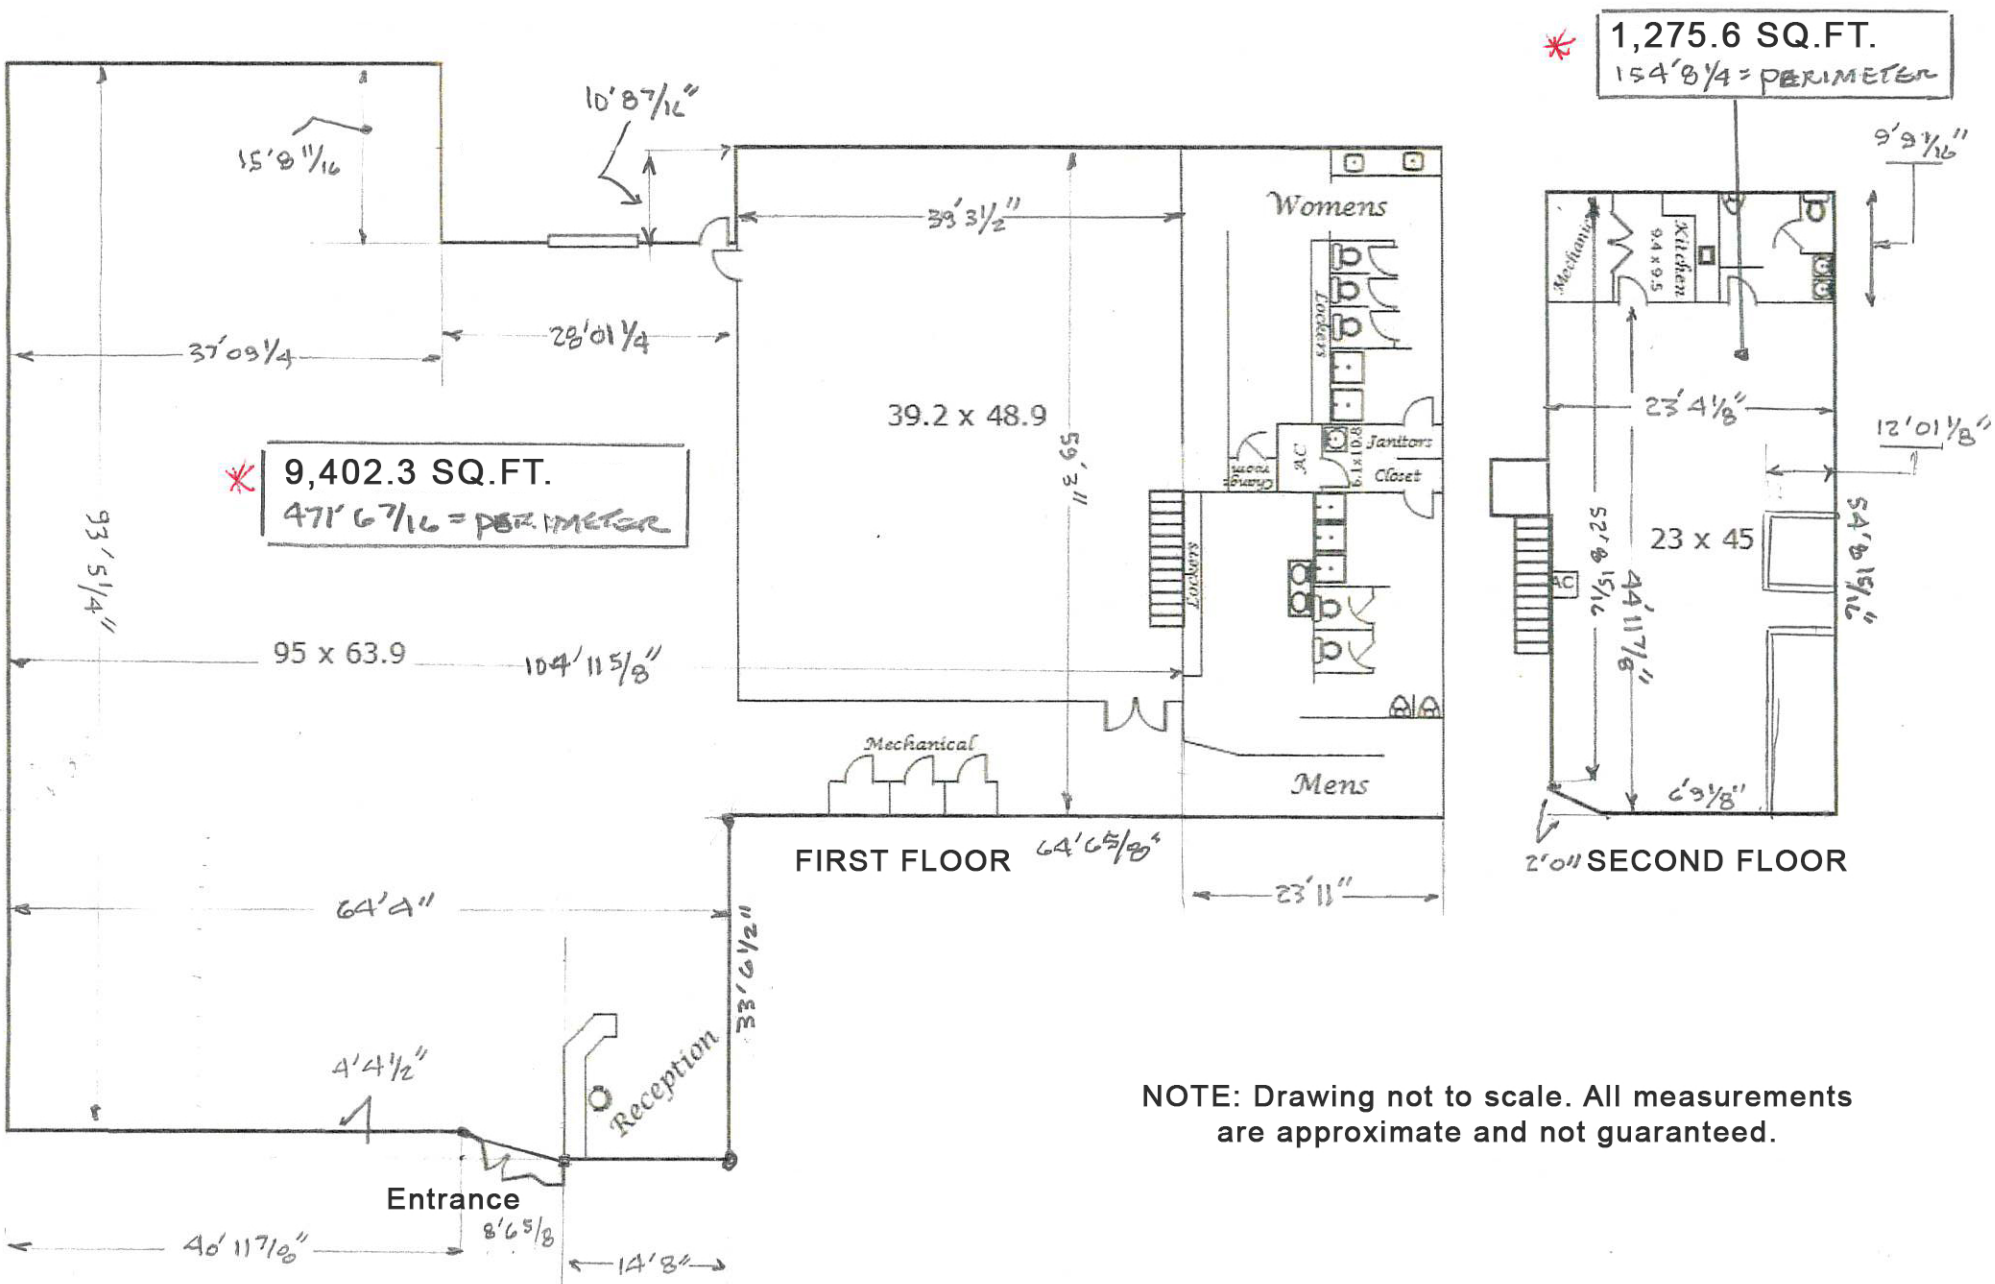

NOTE: Drawing not to scale. All measurements are approximate and not guaranteed.