

PLAT OF SURVEY SHOWING PROPERTY LOCATED IN SECTION 20, T6S-R7E, PARISH OF TANGIPAHOA, STATE OF LOUISIANA.


SCALE: 1" = 200'



ROY EDWARDS
PROFESSIONAL LAND SURVEYOR
 POST OFFICE BOX 1414
 PONCHATOULA, LOUISIANA 70454
 PHONE: (504) 386-6495

U.S. HIGHWAY 190 (Public Blacktop)

42-AN-1079

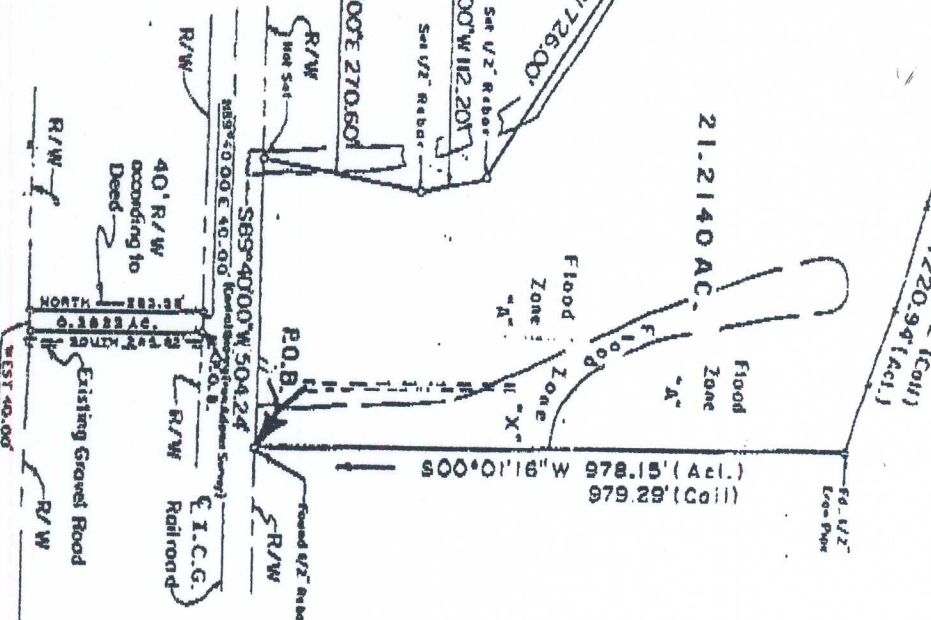

DESCRIPTION OF PROPERTY

An actual ground survey was made of a certain piece or parcel of land situated in Section 20, T6S-R7E, Parish of Tangipahoa, State of Louisiana, more fully described as beginning at a point 6.49 chains North and 11.20 chains S89°40'00\"/>

NOTES:

- 1.) I certify that this plat represents an actual ground survey, made on the ground on the date shown hereon and that no visible encroachments exist in either direction across any of the property lines.
- 2.) I certify that according to Panel No. 0165-D of the Flood Insurance Rate Map of Tangipahoa Parish, Louisiana, dated 9-18-91, subject property is located in Flood Zones A and X, all as shown on plot.
- 3.) I certify that this plat is in accordance with the applicable standards of practice for a Class D Survey.
- 4.) This Perimeter survey shall not constitute a legal opinion of title, and was made solely according to the information provided to the surveyor.

Reference: Survey by Wallace L. Adams, R.L.S., dated 11-15-76.

[Signature]
ROY C. EDWARDS, JR.
PROFESSIONAL LAND SURVEYOR
 DATE: 8-31-95
 DRAWN BY: Joseph L. Heig