

REFERENCE NOTES

- 01 FURR-DOWN ABOVE.
- 02 HEAVY DUTY SUPPORT BRACKET.


**CAN YOU INCREASE WIDTH OF DRAWER
STACK SO THAT MAX DOOR SIZE IS 1'-6" WIDE.
I AM CONCERNED ABOUT CLEARANCE WITH
THE REFRIGERATOR**

GENERAL NOTES

1. DIMENSIONS ARE GIVEN TO FACE OF STUD AND FACE OF EXISTING WALL U.N.O.
2. ALL EXPOSED MILLWORK SURFACES & BACK SIDES OF DOORS TO BE PAINTED TO MATCH EXISTING MILLWORK.
3. ALL UNFINISHED MILLWORK SURFACES TO BE MELAMINE.
4. ALL MILLWORK TO BE 3/4" MDF U.N.O.
5. PROVIDE 4" BACKSPLASH WITH PLASTIC LAMINATE FINISH.
6. RE-SHEET A001 FOR PLASTIC LAMINATE SPECIFICATIONS.
7. CONTRACTOR TO PROVIDE FLOORING, TRANSITION STRIPS AS REQUIRED BY FLOORING MANUFACTURER.

LEGEND

- | NO WORK IN THIS AREA | EXISTING STUD WALL | NEW STUD WALL | EXISTING 1 HR RATED WALL |
|---|---|---|--|
|  |  |  |  |

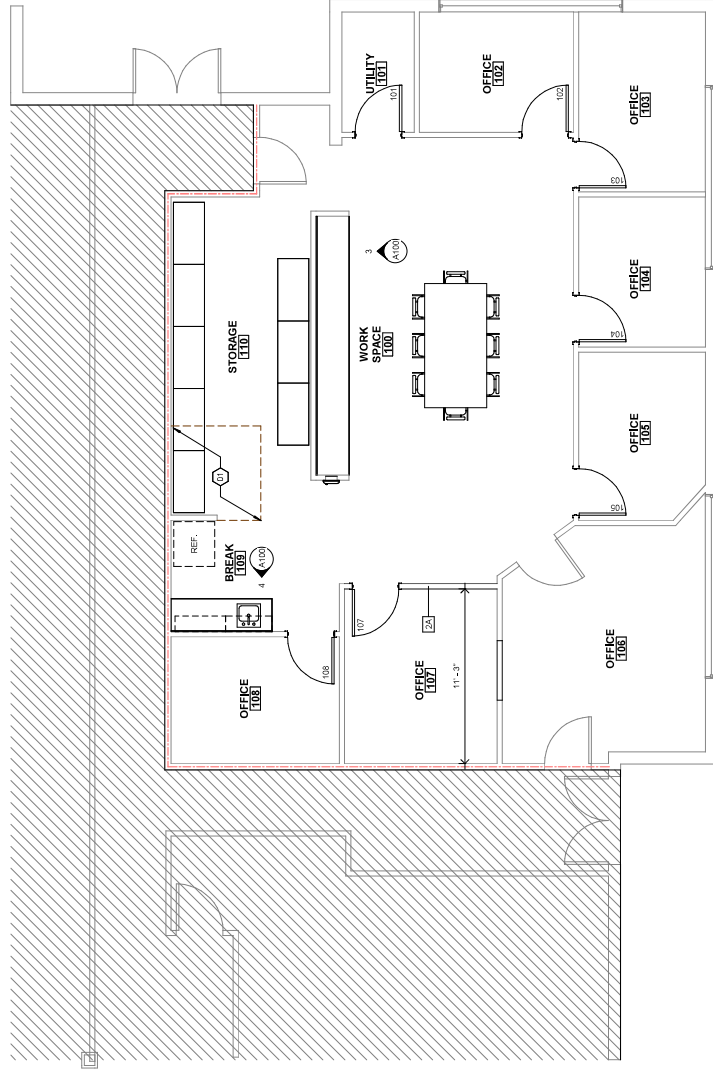

1 FLOOR PLAN
1/4" = 1'-0"

