


SQ. NO. 1791
THIRD DISTRICT


ANNETTE ST.

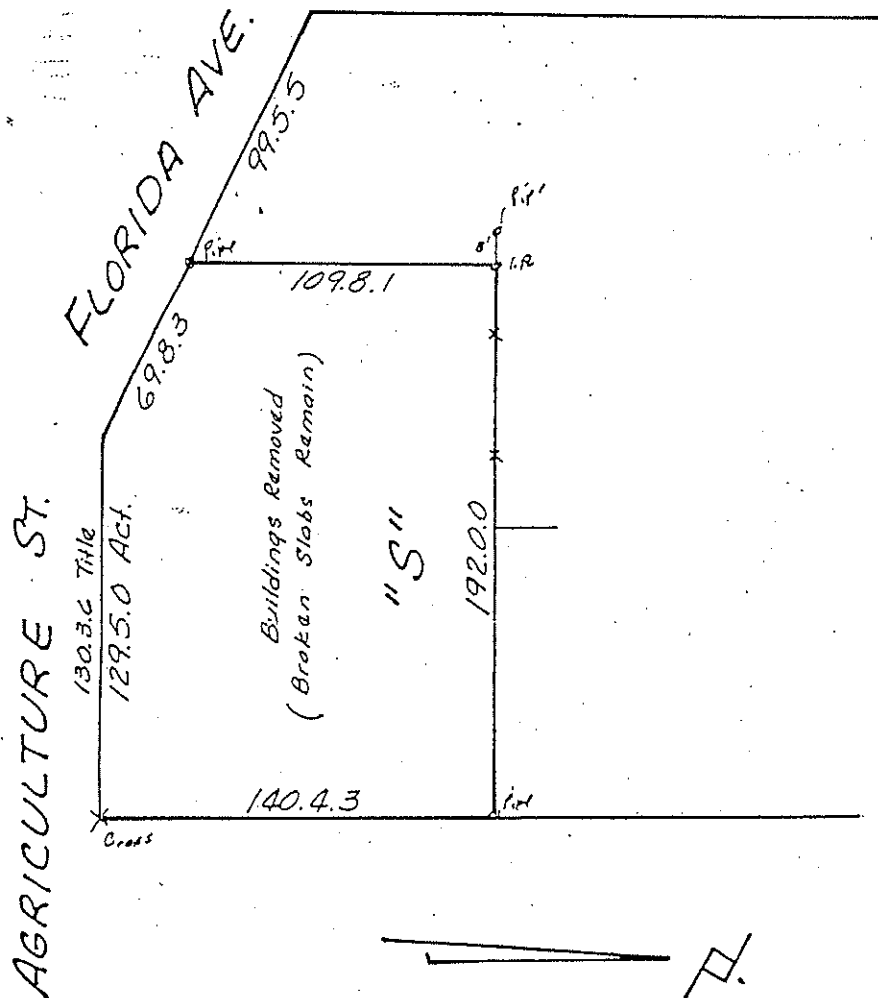

AGRICULTURE ST.

ABUNDANCE ST. SIDE

ST. ANTHONY AVE.

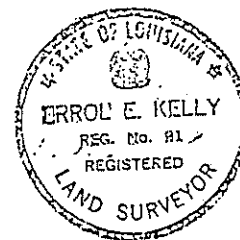

Sept 11, 1984 Irons set for foundation

New Orleans, La.
August 29, 1984

Survey certified correct. Made at the request
of Harold L. Stutson & Lawyers Title Insurance Corp.
Gilbert, Kelly & Couturie, Inc., Surveying & Engineering

2-5479

Errol E. Kelly

L.F.