


Donat Grimaldi, Licensed

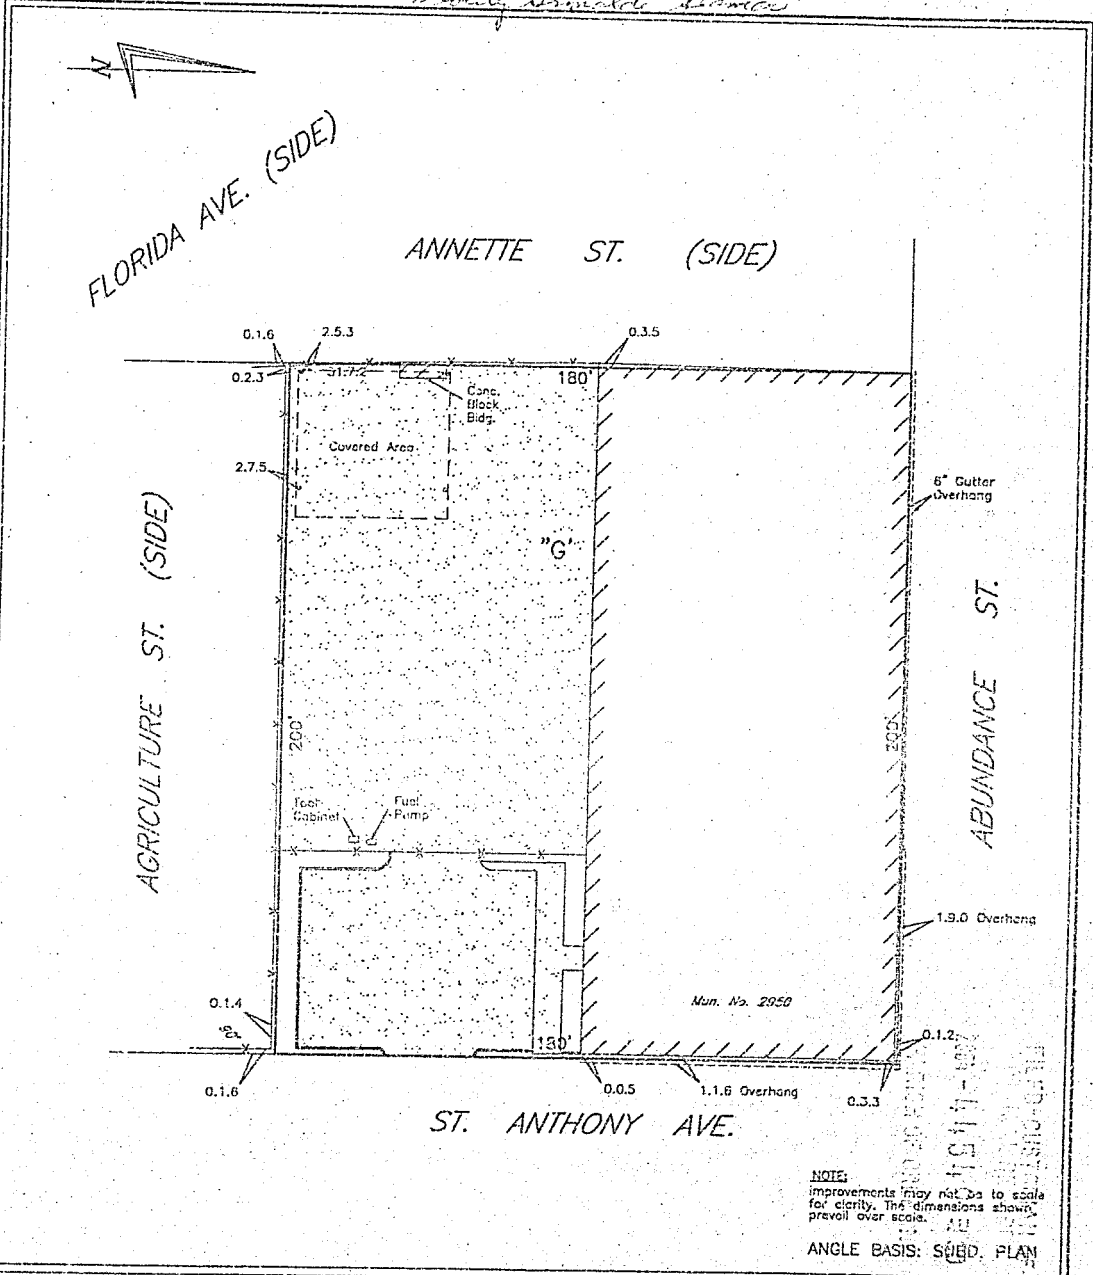

SURVEY OF LOT "G" SQUARE 1791 THIRD DISTRICT CITY OF NEW ORLEANS ORLEANS PARISH, LOUISIANA		DADING, MARQUES & ASSOCIATES, INC.			
I CERTIFY THAT THIS SURVEY AND PLAT WAS PREPARED BY ME OR BY THOSE UNDER MY DIRECT SUPERVISION, MADE AT THE REQUEST OF:		 P.O. BOX 790 METAIRIE, LA. 70004 (504) 834-0200			
CRESCENT TITLE (L04-0322LR)		<i>[Signature]</i> SURVEYOR			
THE SERVITUDES AND RESTRICTIONS SHOWN ON THIS SURVEY ARE LIMITED TO THOSE SET FORTH IN THE DESCRIPTION FURNISHED US AND THERE IS NO REPRESENTATION THAT ALL APPLICABLE SERVITUDES AND RESTRICTIONS ARE SHOWN HEREON. THE SURVEYOR HAS MADE NO TITLE SEARCH OR PUBLIC RECORD SEARCH IN COMPILING THE DATA FOR THIS SURVEY.		THIS SURVEY MEETS THE MINIMUM REQUIREMENTS FOR A CLASS "C" SURVEY ACCORDING TO THE "LOUISIANA MINIMUM STANDARDS FOR PROPERTY BOUNDARY SURVEYS."			
DATE:	SCALE:	DRAWN BY:	CHECKED BY:	JOB NO.:	PLAT No.:
6-10-2004	1" = 40'	J.F.L.	J.M.M.	419690	D-209-236