


EXHIBIT "A"

52'

VOYREE

74'

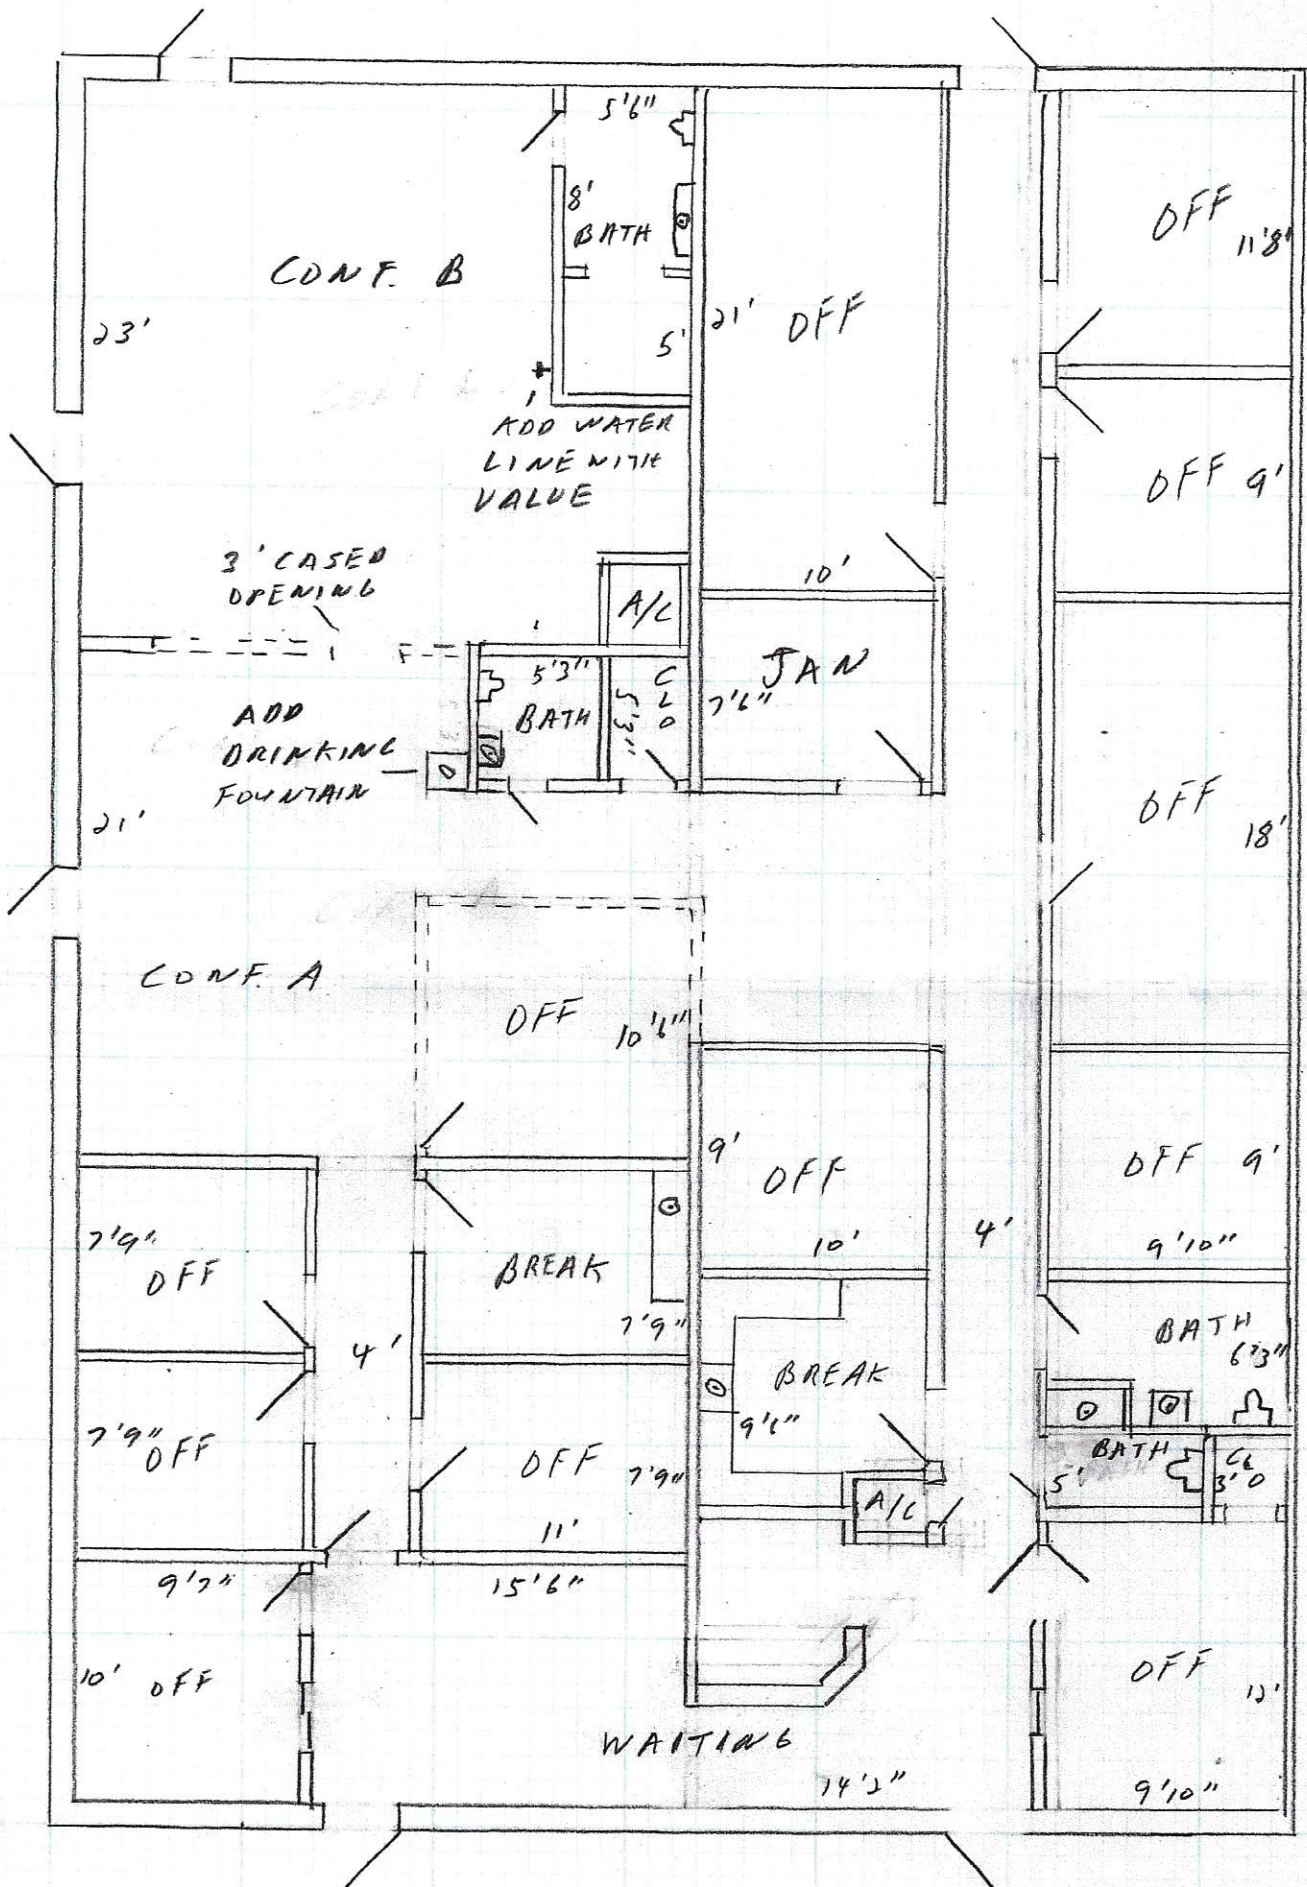

APPROX.
SCALE
1" = 8'

(ADD PARTITIONS
=====)