


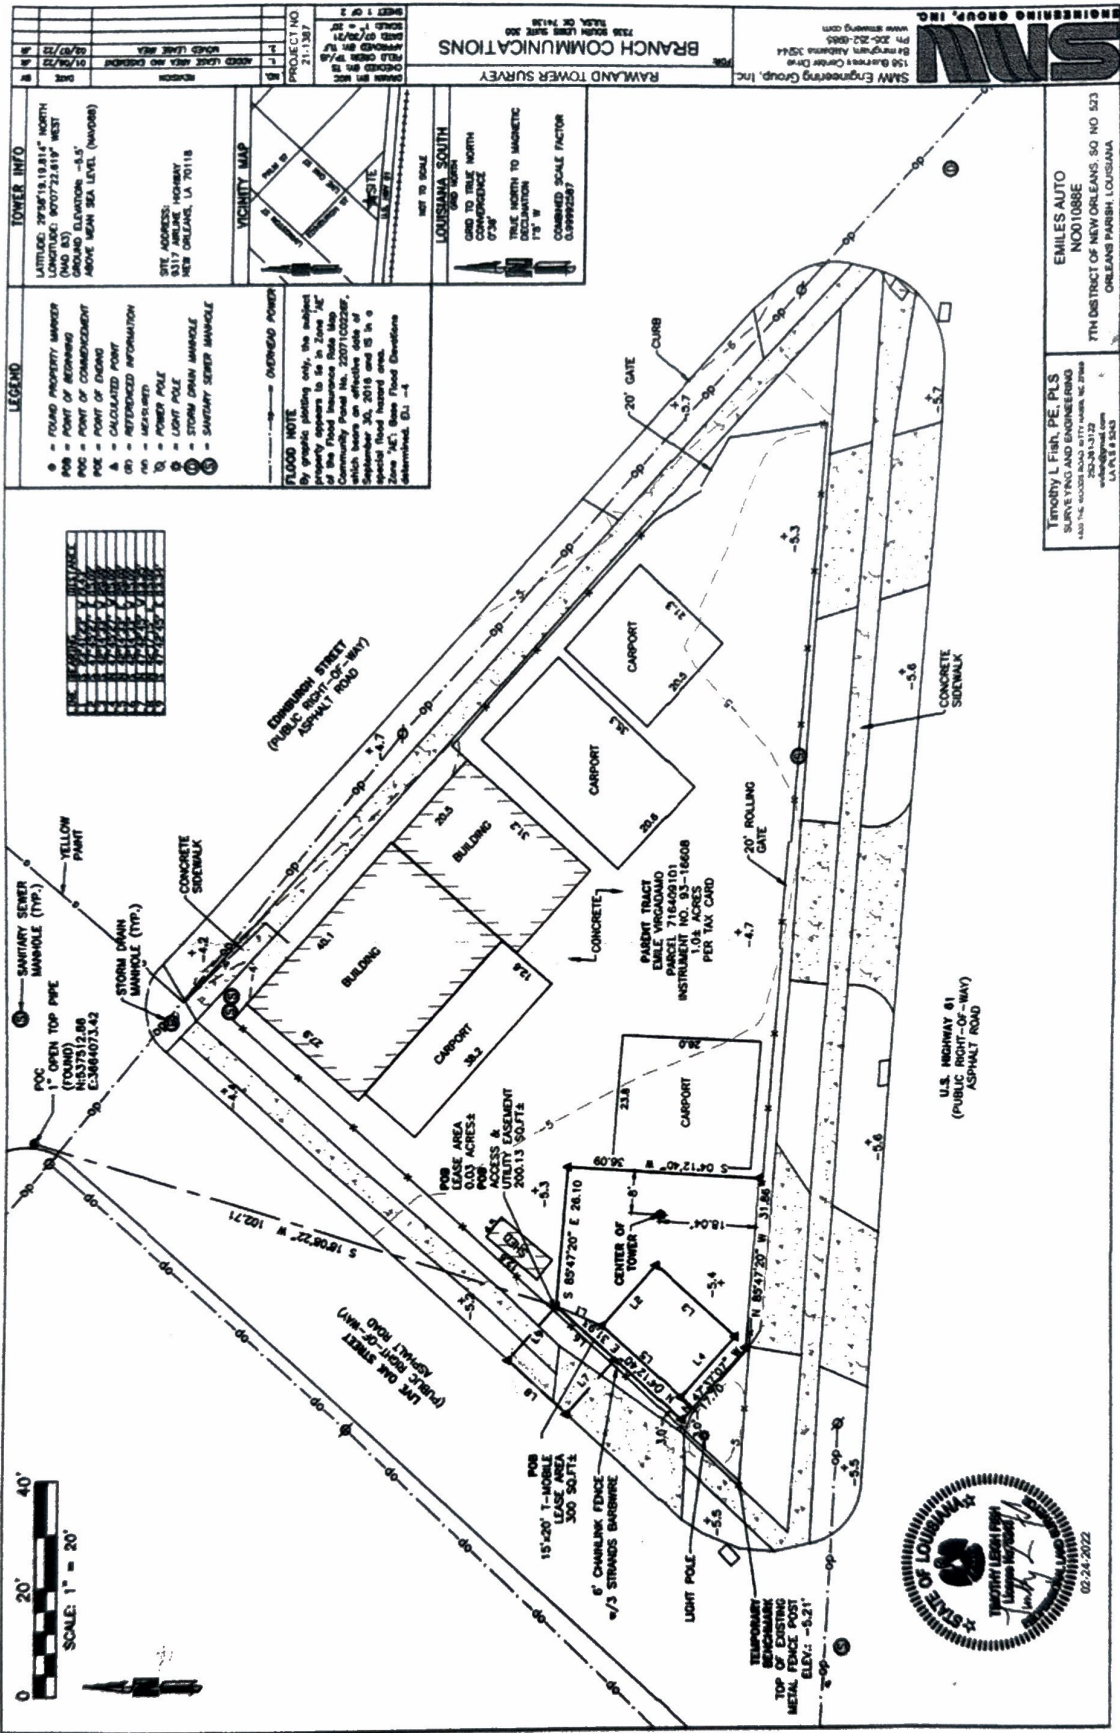

Timothy L. Fink, PE, PLS
 SURVEYING AND ENGINEERING
 1400 THE MADISON ROAD SUITE 200
 NEW ORLEANS, LA 70112
 (504) 835-1322
 LA P.E. # 240




BRANCH COMMUNICATIONS

RAWLAND TOWER SURVEY
 ORDERED BY: BR
 APPROVED BY: BR
 DATE: 07/20/21
