
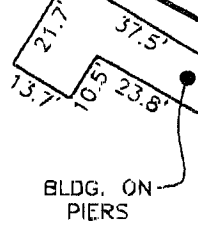


F:\JOBFILES\4060391\SURVEY\4060391

LEON R.
KLEINPETER, INC.
(NOW OR FORMERLY)

N27°55'00"E (BASE BEARING)
209.92' (SY) 210.00' (REC)

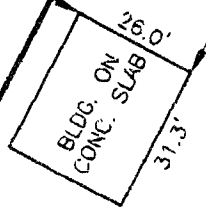

0.78 AC.


C. ELIZ K. KERSHAW
(NOW OR FORMERLY)

STARTING POINT:
The Intersection of the
Northern R/W of Airline Hwy.
with the Western R/W of
Barringer Foreman Rd.*

GENERAL NOTES

1. The original drawing of this work is the property of Alvin Fairburn & Assoc., LLC. Reproduction of this print is prohibited except by permission of this firm. Additional information is often added in a continuous updating process. Check for latest revision data before acting on data shown. This firm is not responsible for actions or projects based upon obsolete drawings for which this firm was not specifically consulted.
2. This survey was based on information supplied by the client, no abstract was obtained to verify ownership of this property.
3. Property restrictions, improvements, servitudes, and/or rights-of-way other than those shown may exist on this property and owners or potential buyers should be aware that abstracting the title to this property to show all encumbrances was not within the scope of this survey.
4. Bearings shown are based on reference no. 1.
5. * Indicates taken from reference and not surveyed.
6. Wetland determination was not requested, and was not included in this survey.
7. (REC) is information taken from reference.
8. (SY) is information actually surveyed on the ground.

CERTIFICATION: This is to certify to the client that in June 2006, this map and the survey on which it is based, was made under my direct supervision, in accordance with the minimum standards for Boundary Surveys as found in Louisiana Administrative Code TITLE 46:XXI, Chapter 25, for Class C Surveys and it was the intent to establish the surveyed boundary according to reference map #1. This certification is specifically restricted to the client for their individual use and does not extend to third parties unless the plat is properly revised by the certifier to reflect the same.

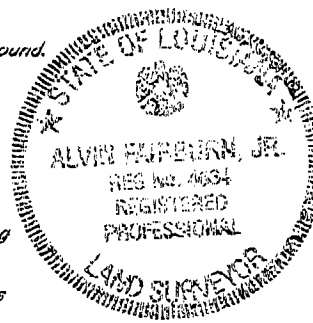

Alvin Fairburn Jr., P.L.S.
DATE: JUNE 29, 2006
FILE: "GIOVANNI-BARRINGER FOREMAN"



MAP SHOWING SURVEY OF
A CERTAIN 0.78 ACRE TRACT
OF LAND, FORMERLY THE
AARON MORRIS PROPERTY,
LOCATED IN SECTION 50, T8S-R2E, C.L.D.
EAST BATON ROUGE PARISH, LOUISIANA
FOR
GIOVANNI MUCCIACCIARO

REFERENCE:

1. "Composite Map Compiled for Leon R. Kleinpeter Farms & Dairy, Inc...", dated 11-9-1972.

FLOOD CERTIFICATION:

According to the F.I.R.M. Community Panel No. 220058 0115 D, dated 5-17-93, this property lies in flood zone "X".

36-1	60	WB	SJM	SJM	
FB	PGS	PC	CALC.	DWG	CKD

ALVIN FAIRBURN & ASSOCIATES, LLC
CONSULTING ENGINEERS ~ LAND SURVEYORS
LAND DEVELOPMENT CONSULTANTS ~
PROJECT DESIGNERS
1110 SOUTH RANGE AVENUE
DENHAM SPRINGS, LOUISIANA 70728 (225) 665-1515
JOB NO. A060391-1A

