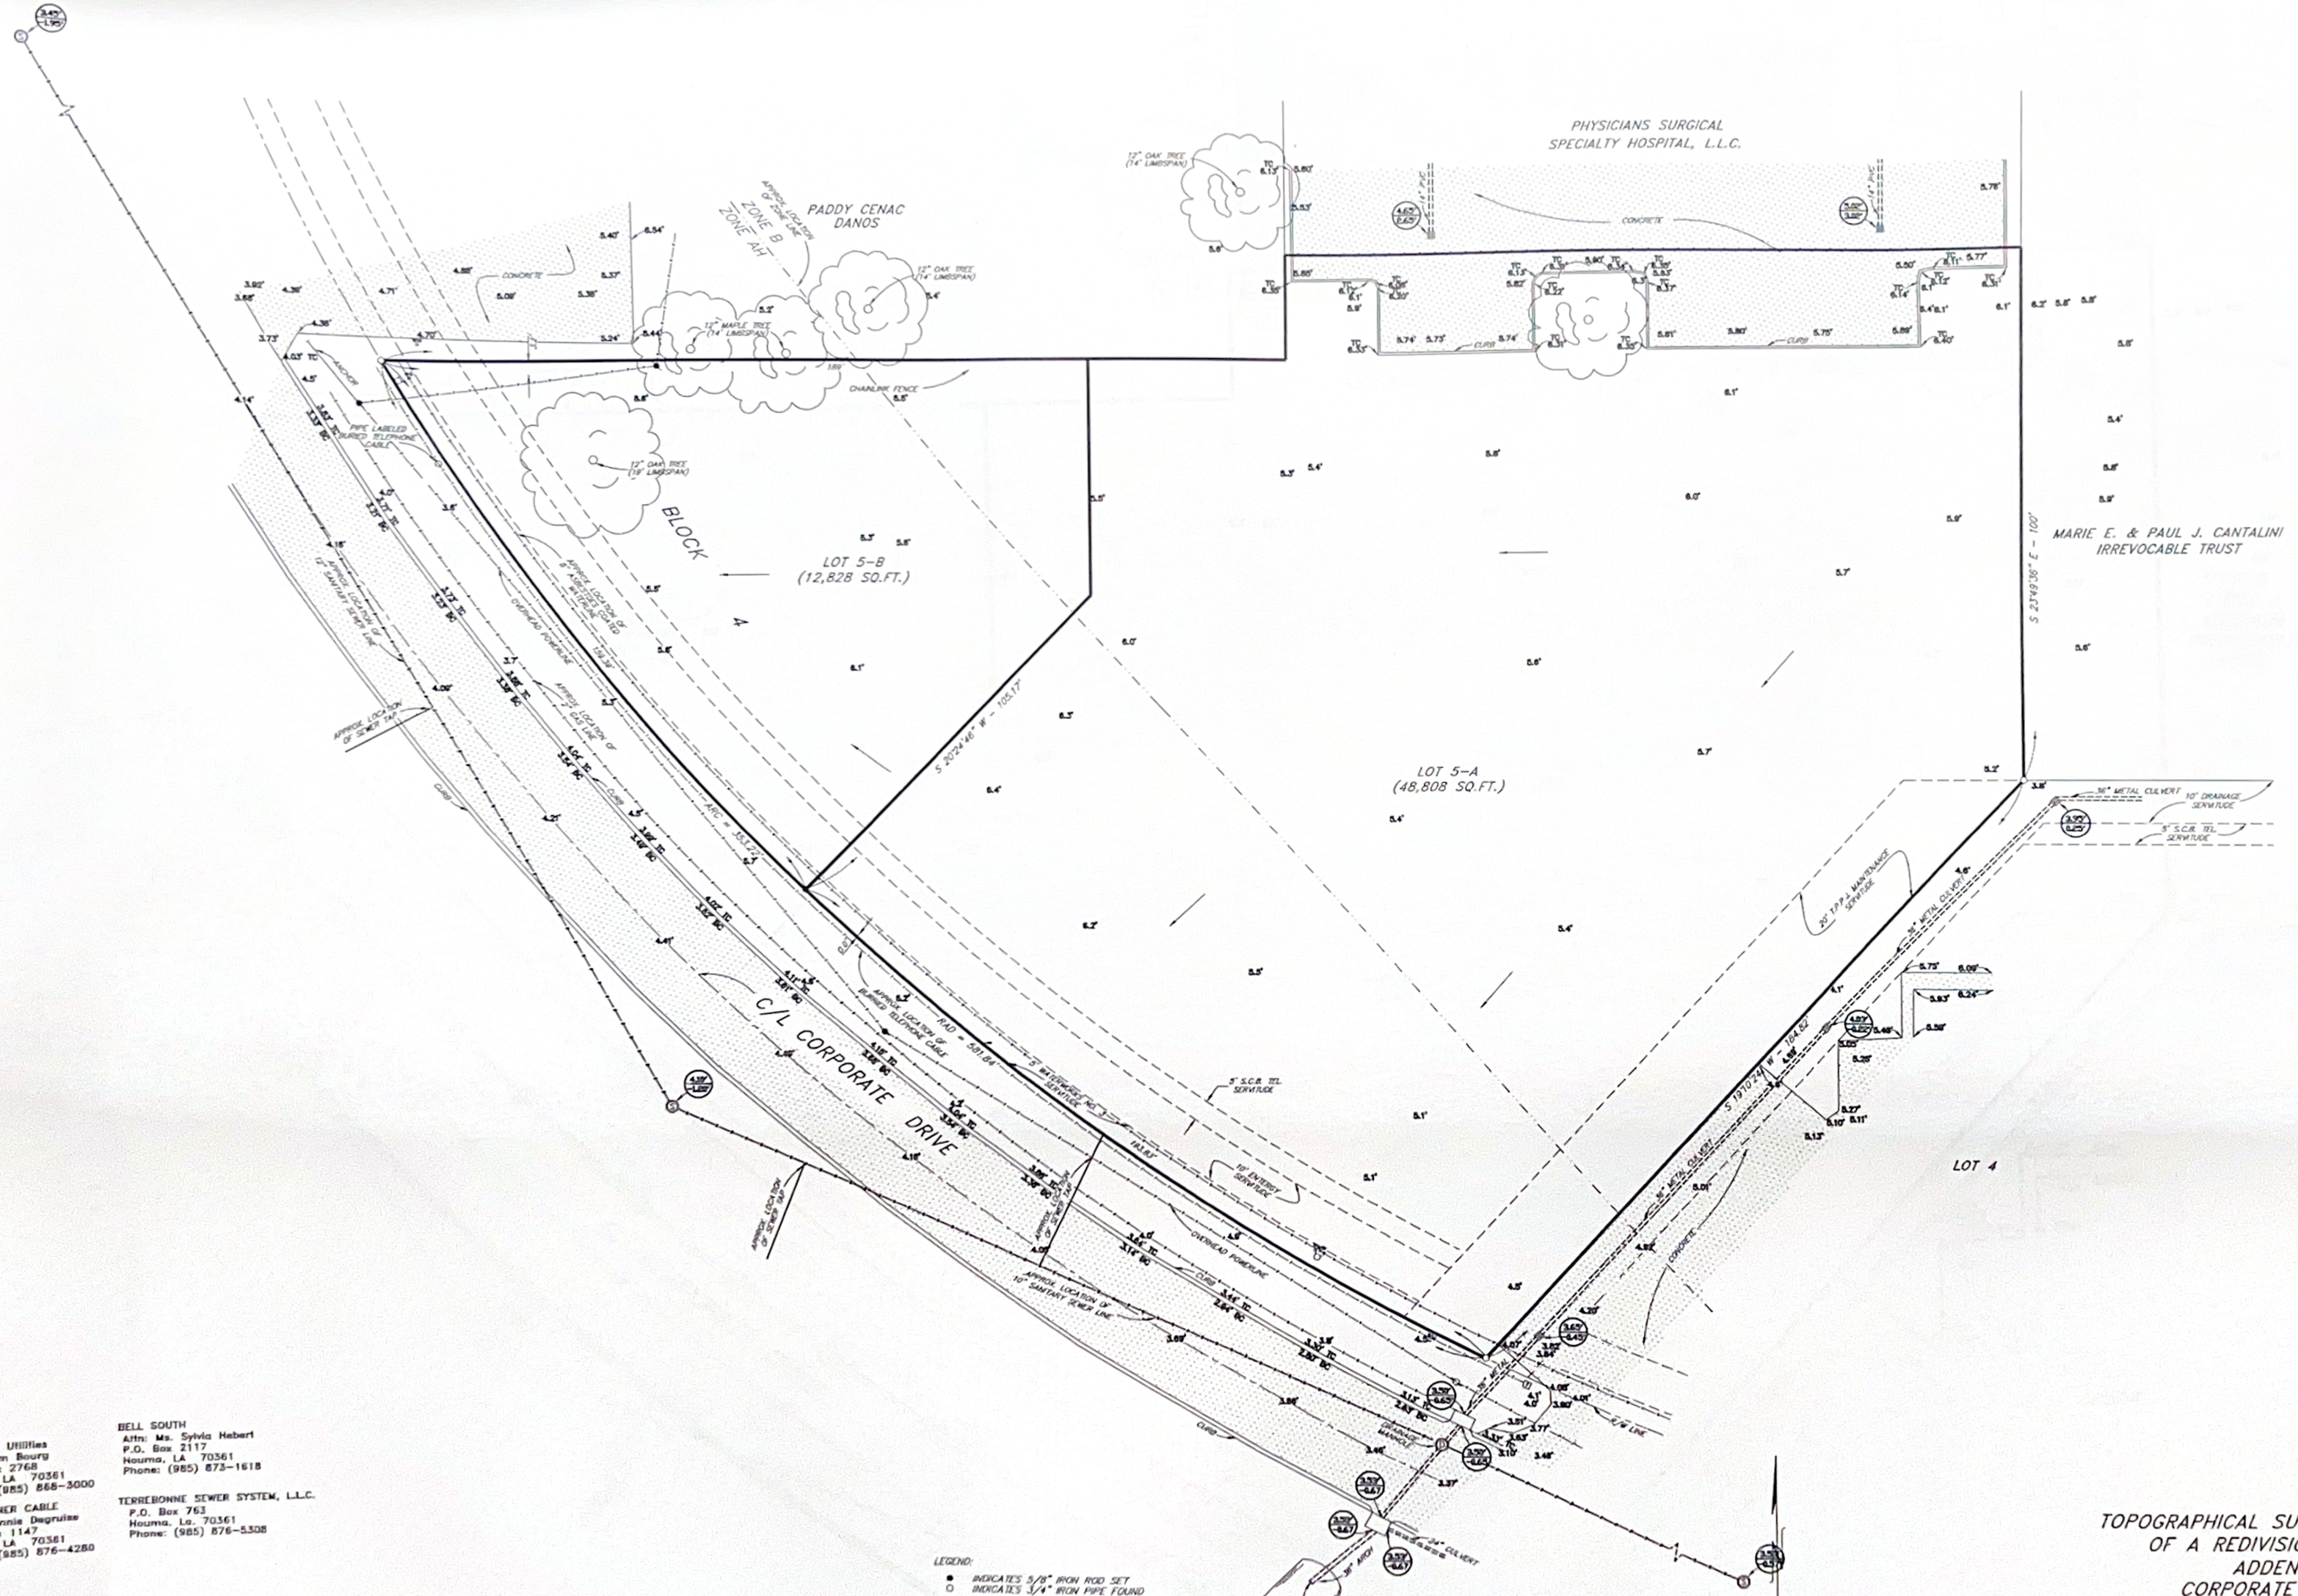

CONTACTS

WATERWORKS DIST. NO. 1
Attn: Mr. Tom Wilson
P.O. Box 630
Houma, LA 70361
Phone: (985) 879-2495

T.P.C.G.
Dept. of Utilities
Attn: Tom Bourg
P.O. Box 2768
Houma, LA 70361
Phone: (985) 868-3000

TIME WARNER CABLE
Attn: Ronnie Degruise
P.O. Box 1147
Houma, LA 70361
Phone: (985) 876-4280

BELL SOUTH
Attn: Ms. Sylvia Hebert
P.O. Box 2117
Houma, LA 70361
Phone: (985) 873-1618

TERREBONNE SEWER SYSTEM, L.L.C.
P.O. Box 763
Houma, La. 70361
Phone: (985) 876-5308

THESE LOTS ARE LOCATED IN ZONE "B" AND ZONE "AH" (BASE FLOOD REQUIREMENT IS 7') AS SHOWN ON FEDERAL EMERGENCY MANAGEMENT AGENCY MAP, COMMUNITY NO. 225206, PANEL NO. 0365, SUFFIX "C", AND DATED MAY 1, 1985.

ELEVATIONS SHOWN HEREON ARE BASED ON NAVD 88 EPOCH 2004 DATUM.

THIS MAP IS BASED ON MAP ENTITLED " LOT 5 OF BLOCK 4 OF CORPORATE ACRES SUBDIVISION ADDENDUM NO. 1 LOCATED IN SECTION 101, T17S-R17E IN TERREBONNE PARISH, LOUISIANA" PREPARED BY THETA II ENTERPRISES, INC. DATED JANUARY 18, 1985

BEARINGS SHOWN HEREON ARE BASED ON SAID MAP.

THIS MAP DOES NOT PURPORT TO SHOW ALL SERVITUDES, RIGHT-OF-WAYS, EASEMENTS OR OTHER PHYSICAL OBJECTS THAT MAY AFFECT THE TRACT SURVEYED.

I CERTIFY THAT THIS SURVEY WAS DONE UNDER MY DIRECT SUPERVISION IN ACCORDANCE WITH THE MINIMUM STANDARDS OF PRACTICE FOR LAND SURVEYORS AND THAT THE ACCURACY STANDARDS ARE IN ACCORDANCE WITH CLASS "C" (SUBURBAN) SURVEYS AS INDICATED IN THE ABOVE STANDARDS.

LEGEND:
- INDICATES 5/8" IRON ROD SET
- INDICATES 3/4" IRON PIPE FOUND
- EXISTING POWER POLE
- EXISTING POWER POLE WITH LIGHT
- EXISTING FIRE HYDRANT
- INDICATES SPOT ELEVATION
- INDICATES DRAINAGE ARROWS
- INDICATES TELEPHONE PEDESTAL
- INDICATES DROP INLET
- INDICATES SEWER MANHOLE
- INDICATES WATER VALVE
- INDICATES WATER METER
- INDICATES CATCH BASIN

TOPOGRAPHICAL SURVEY OF LOTS 5-A & 5-B OF A REDIVISION OF LOT 5 BLOCK 4 ADDENDUM NO. 1 TO CORPORATE ACRES SUBDIVISION LOCATED IN SECTION 101, T17S - R17E TERREBONNE PARISH, LOUISIANA

STATE OF LOUISIANA
KENETH L. REMBERT
REG. No. 331
REGISTERED PROFESSIONAL LAND SURVEYOR

SEPTEMBER 18, 2006

SCALE: 1" = 20'

KENETH L. REMBERT, SURVEYOR
635 SCHOOL ST., HOUMA, LA.