


CAMP ST. (SIDE)

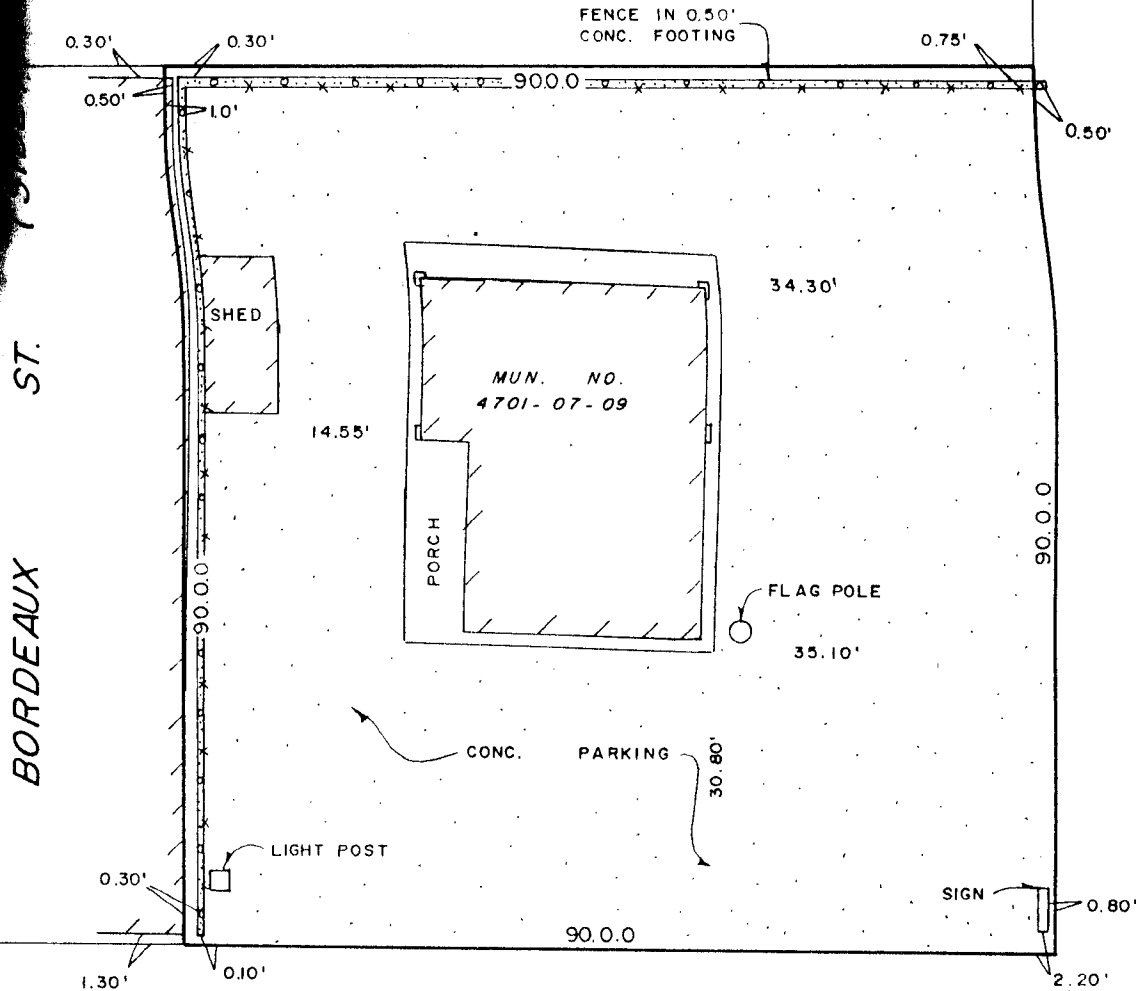

MAGAZINE

ST.


IS TO CERTIFY THAT I HAVE CONSULTED WITH THE TROLLING PARISH AGENT AND/OR THE F.I. A. FLOOD HAZARD BOUNDARY MAPS AND FIND THAT THE ABOVE DESCRIBED PROPERTY IS NOT LOCATED IN A SPECIAL FLOOD HAZARD ZONE. (ZONE B)

SURVEY OF A PORTION
OF LOTS 9, 17, 18 AND 19
SQUARE 235
BOULIGNY, SIXTH DISTRICT
CITY OF NEW ORLEANS
ORLEANS PARISH, LA

IFY THAT THIS SURVEY AND PLAT WAS PREPARED
FOR THOSE UNDER MY DIRECT SUPERVISION.
AT THE REQUEST OF:

g Thanh Le, Ph.D., P.E.

Dading, Marques &
Associates, Inc.

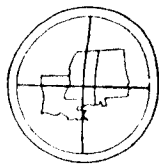

P.O. BOX 790
METAIRIE, LA 70004
834-0200

James M. Marques
SURVEYOR

SERVITUDES AND RESTRICTIONS SHOWN ON THIS SURVEY ARE
TO THOSE SET FORTH IN THE DESCRIPTION FURNISHED US AND
IS NO REPRESENTATION THAT ALL APPLICABLE SERVITUDES
RESTRICTIONS ARE SHOWN HEREON THE SURVEYOR HAS MADE
LE SEARCH OR PUBLIC RECORD SEARCH IN COMPILING THE
OR THIS SURVEY.

SURVEYED IN ACCORDANCE WITH THE LOUISIANA
"MINIMUM STANDARDS FOR PROPERTY BOUNDARY SURVEYS"
FOR A CLASS B SURVEY.

DATE	SCALE	DRAWN BY	CHECKED BY	JOB NO.	PLAT NO.
------	-------	----------	------------	---------	----------