

BORE ST. (SIDE)




N. CAUSEWAY (LATE HARLEN) BLVD.

ATHANIA

PKWY.

(SIDE)

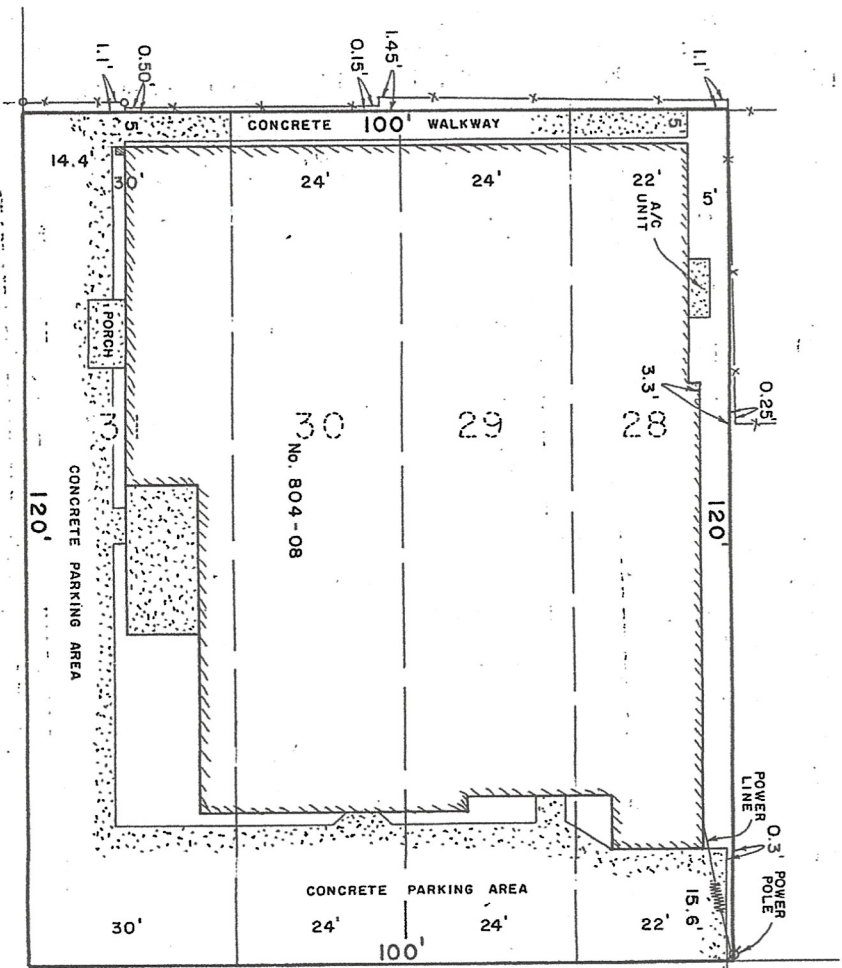

WEST METAIRIE (LATE BEAULIEU) AVE.

SQUARE 103
HARLEM SUBD.
JEFFERSON PARISH,
LA.



RESURVEYED DEC. 14, 1999
METAIRIE, LA.
JULY 19, 1978
SURVEY MADE AT THE REQUEST
OF V.P. OWEN CONSTRUCTION CO.
CERTIFIED CORRECT
J.J. KREBS & SONS, INC.

Randall W. Brown