


THE P.O.B. IS REPORTED TO BE S89°26'E
2244.0'; N31°15'W 766.8' FROM THE SOUTH
WEST CORNER OF SECTION 36, T-5-S,
R-10-E, ST. TAMMANY PARISH, LOUISIANA.

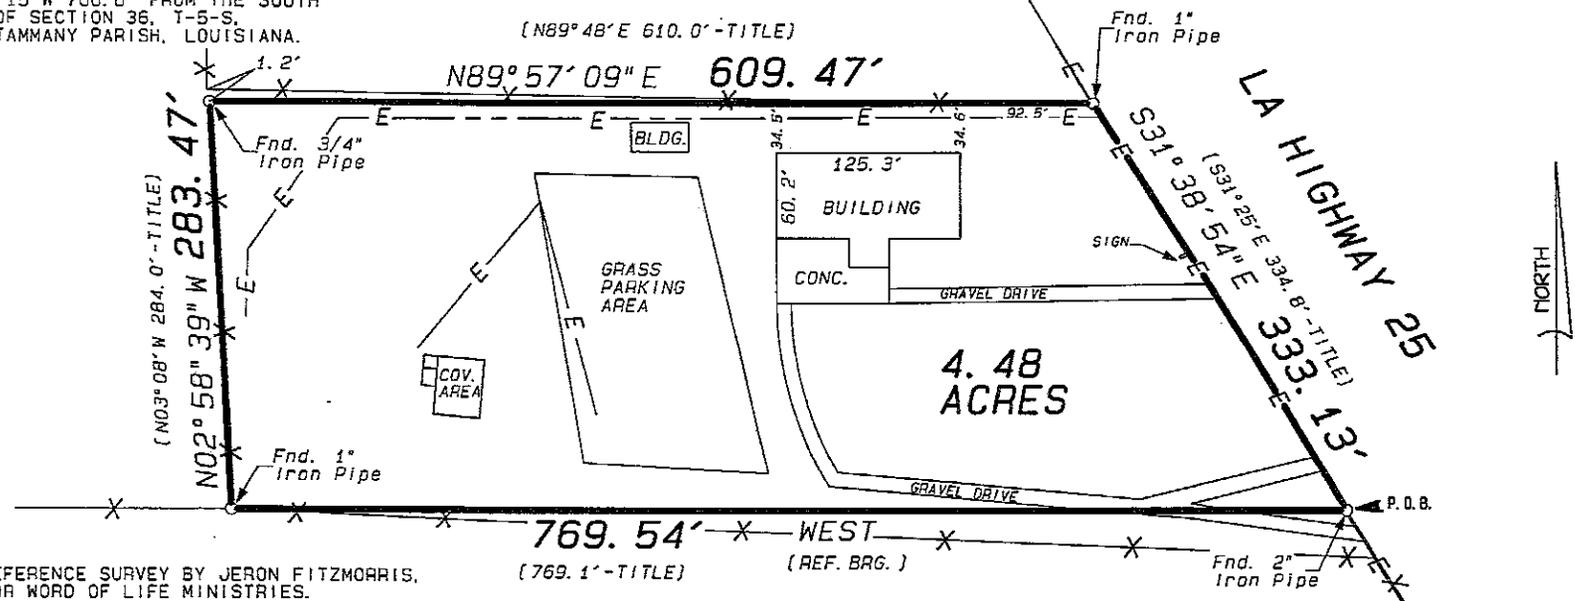

REFERENCE SURVEY BY JERON FITZMORRIS,
FOR WORD OF LIFE MINISTRIES.

NOTE: Setback lines shall be verified by owner
or contractor prior to any construction, as an
abstract has not been performed by the undersigned.

Note: This is to certify that I have consulted the Federal Insurance
Administration Flood Hazard Boundary Maps and found the property
described is located in Flood Zone(s) "C" with a
Base Flood Elevation of N/A in accordance with Community
Panel No. 225205 0125 C ; Revised: OCTOBER 17, 1989

Note: Servitudes shown hereon are not
necessarily exclusive. Servitudes of
record as shown on title opinion or title
policy will be added hereto upon request,
as surveyor has not performed any title
search or abstract.

This is to certify that I have done
an actual ground survey and found that
no encroachments exist either way across
any property lines except as shown.

**SURVEY MAP OF
A 4.48 ACRE PARCEL OF LAND SITUATED**

SECTION 36, T-5-S, R-10-E

St. Tammany Parish, Louisiana

**for
ROBERT RATHE and RON GITZ, JR.**

THIS IS TO CERTIFY THAT THIS SURVEY WAS DONE UNDER MY DIRECT SUPERVISION AND CONTROL; AND THAT THE SURVEY WAS MADE ON THE GROUND AND IS IN ACCORDANCE WITH THE "MINIMUM STANDARDS FOR PROPERTY BOUNDARY SURVEYS" AS ADOPTED BY THE STATE OF LOUISIANA AND THE REGISTRATION FOR PROFESSIONAL ENGINEERS AND LAND SURVEYORS FOR A CLASS "D" SURVEY.		
Survey No. 2003 200 Date: MAY 29, 2003	Drawn by: JEB Revised:	Scale: 1" = 100'
JOHN E. BONNEAU & ASSOCIATES, INC. Professional Land Surveyors • Planners and Consultants 1011 N. CAUSEWAY BLVD. - SUITE 34 • MANDEVILLE, LA. 70471 (985) 626-0808 SLIDELL (985) 643-2508 • MANDEVILLE (985) 626-3546 • N. O. (504) 456-2042 HAMMOND (985) 345-7641 • FAX NO. (985) 626-0057 • E-MAIL jebco1@bellsouth.net		
		This Survey is Certified true JOHN E. BONNEAU REG. No. 4423 REGISTERED PROFESSIONAL ENGINEER JOHN E. BONNEAU Professional Land Surveyor Registration No. 4423

22