



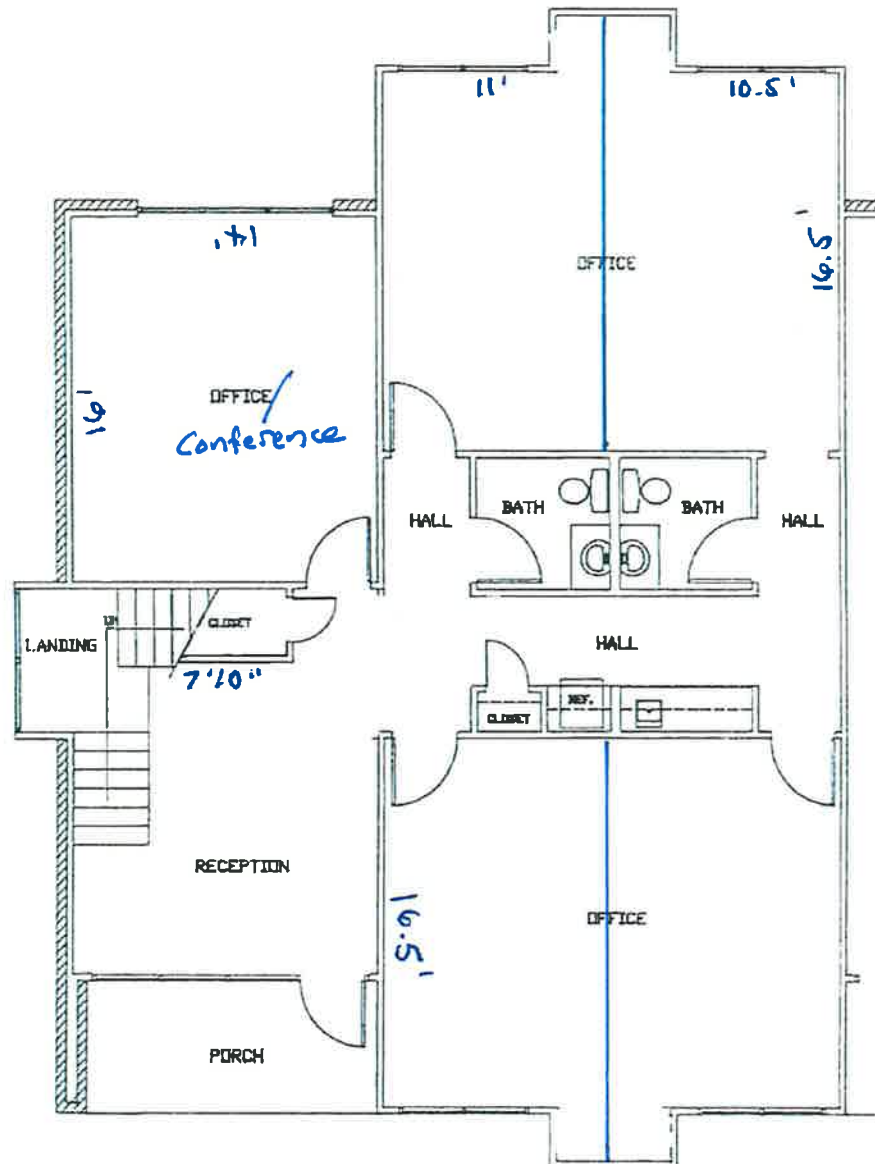

Fairway Centre
OFFICE PARK

FIRST FLOOR PLAN
SCALE: 1/8" = 1'-0" UNIT D6

CHRIS HENRY KLAHORST
SPACE PLANNER - BUILDING DESIGNER
19 JENNIFER COURT - HANDEVILLE, LOUISIANA 70448

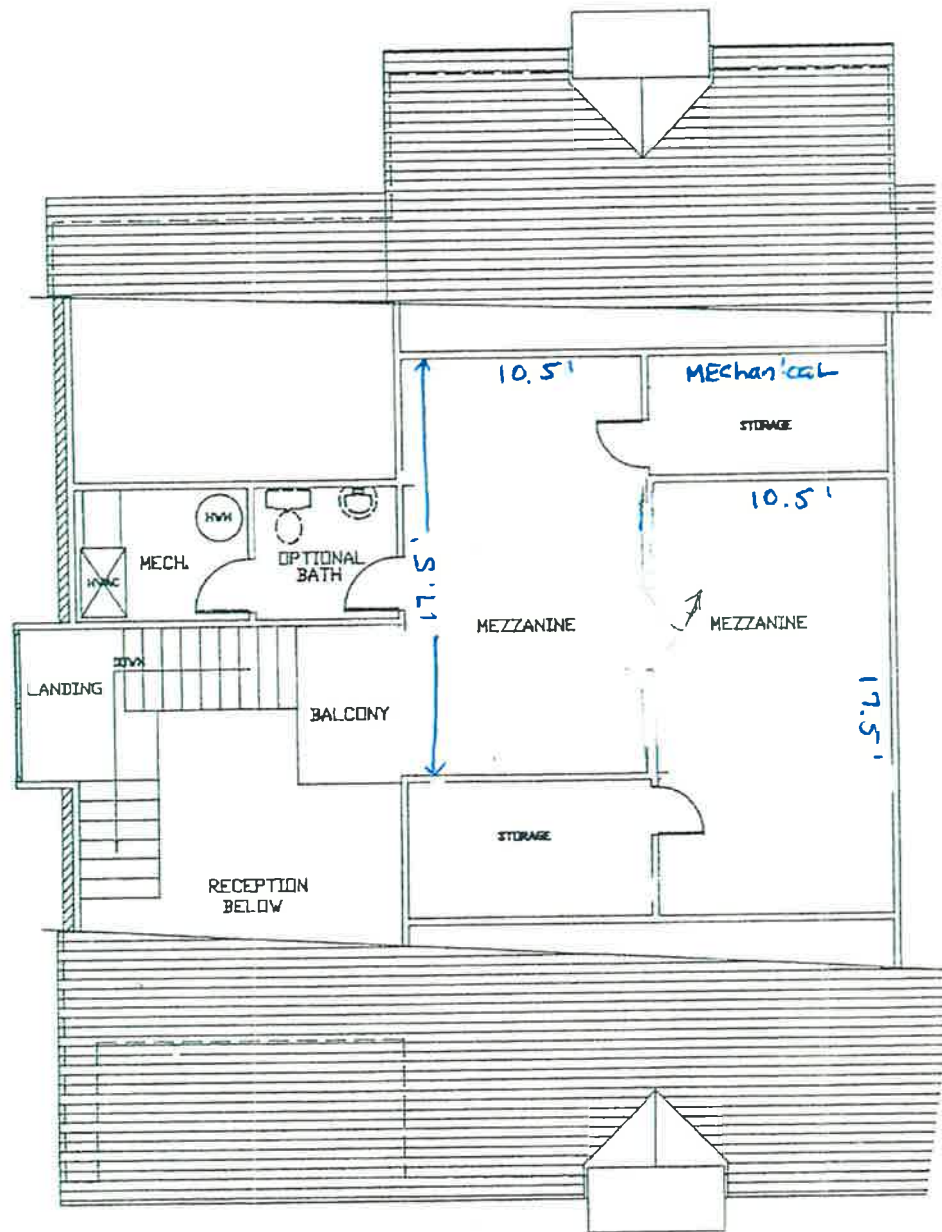

SECOND FLOOR PLAN
SCALE: 1/8" = 1'-0" UNIT D6

CHRIS HENRY KLAHORST
SPACE PLANNER - BUILDING DESIGNER
19 JENNIFER COURT - MANDEVILLE, LOUISIANA 70448