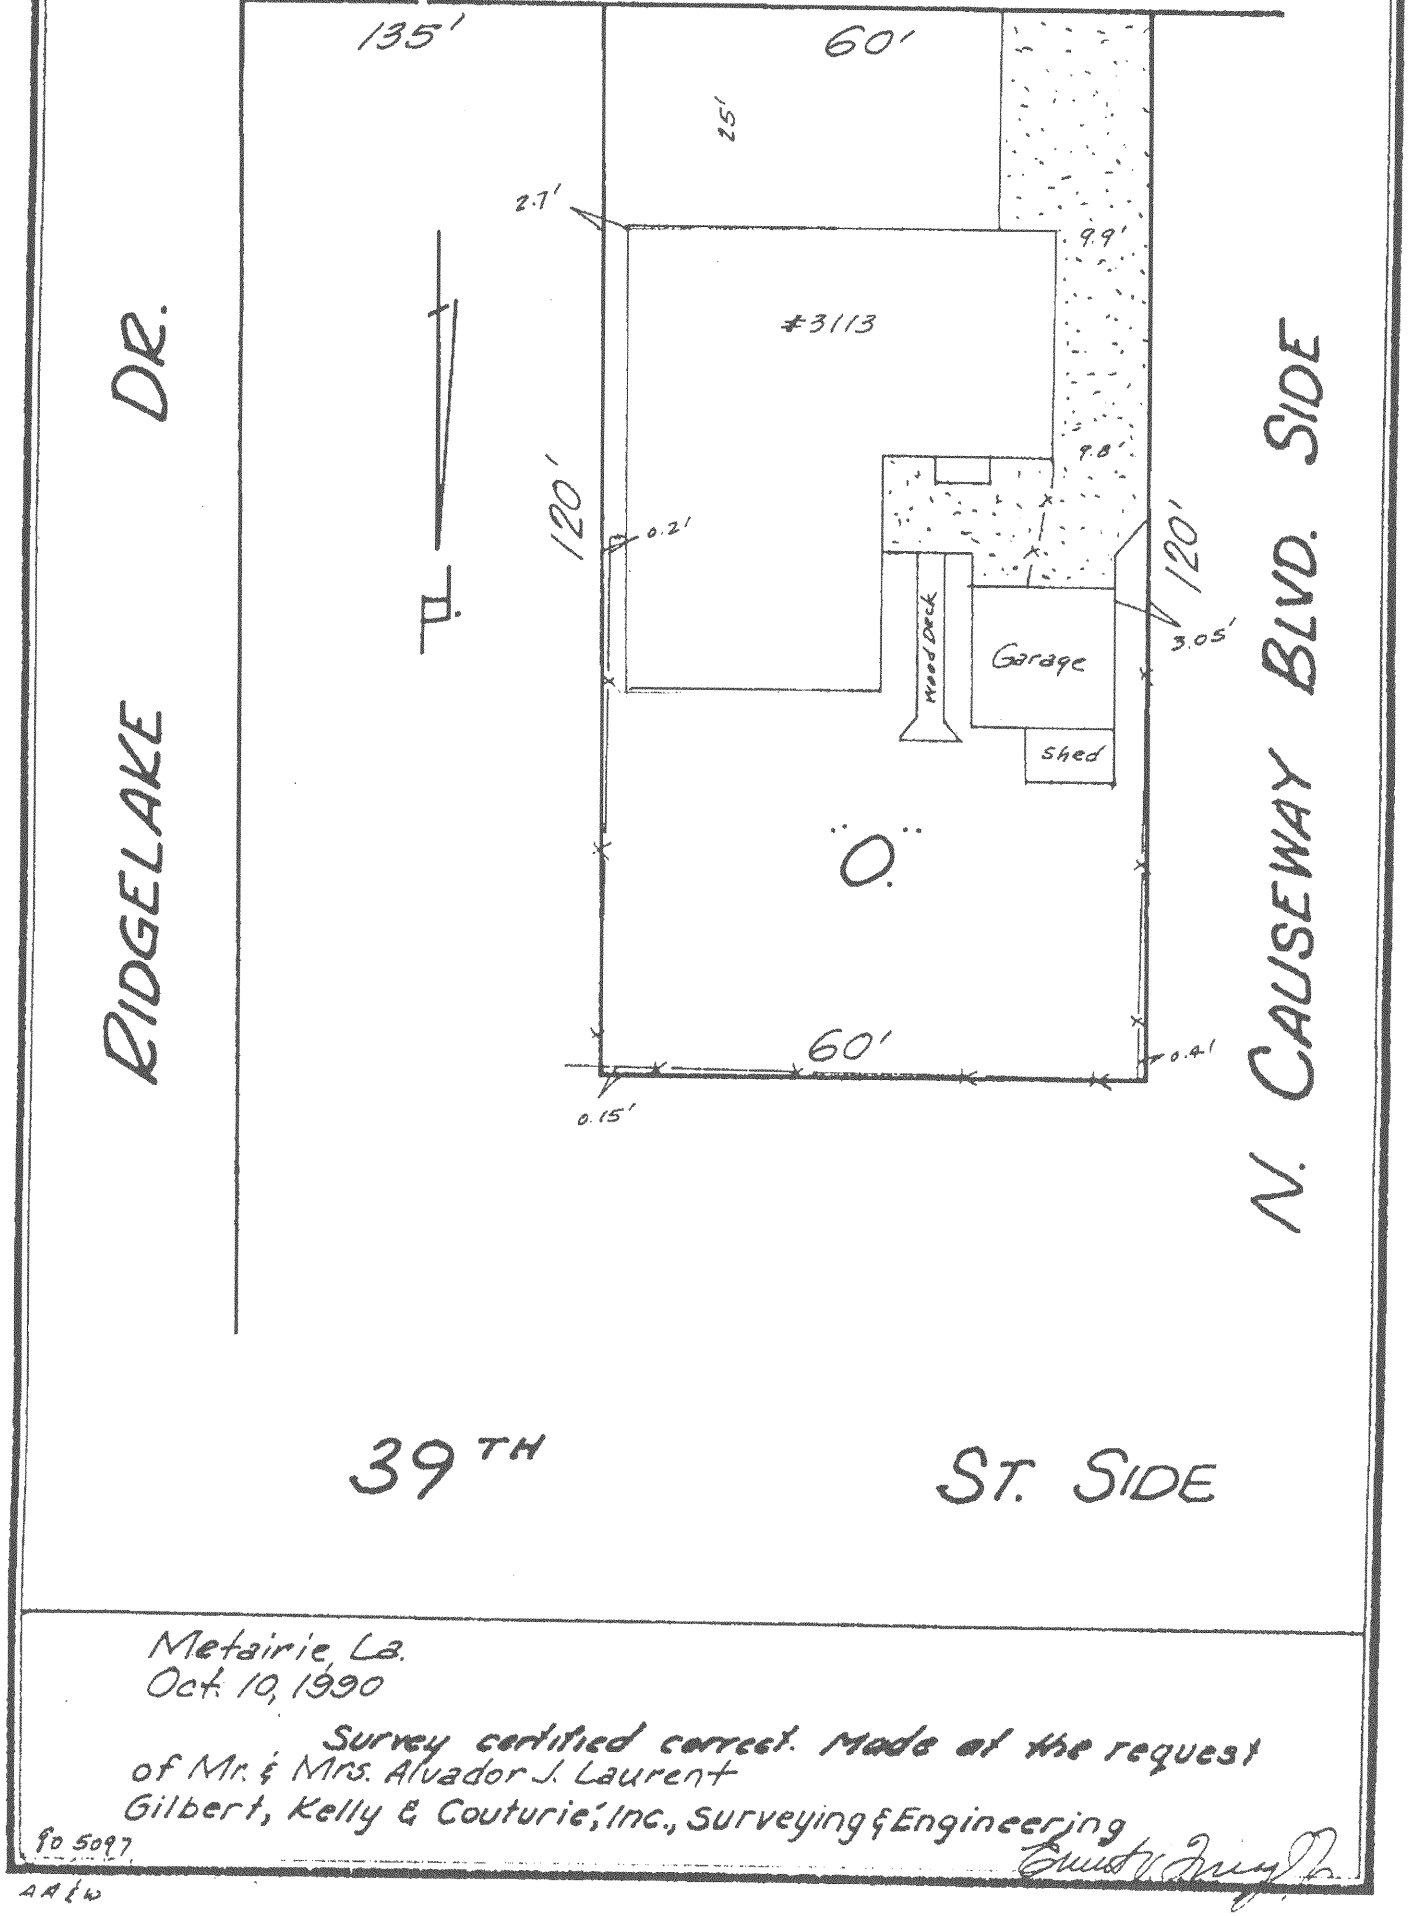


Metairie, La.
Oct. 10, 1990

Survey certified correct. Made at the request of Mr. & Mrs. Alvador J. Laurent

Gilbert, Kelly & Couturie', Inc., Surveying & Engineering

90 5097

AA & W