

BOUNDARY SURVEY

Situated in the:
SECTION 07, TOWNSHIP 10 SOUTH, RANGE 09 WEST,
SOUTHWESTERN LAND DISTRICT, LOUISIANA MERIDIAN,
CALCASIEU PARISH, LOUISIANA.

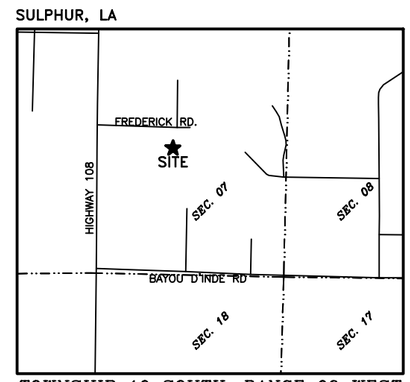

TOWNSHIP 10 SOUTH, RANGE 09 WEST
VICINITY MAP
SCALE: 1" = 2000'

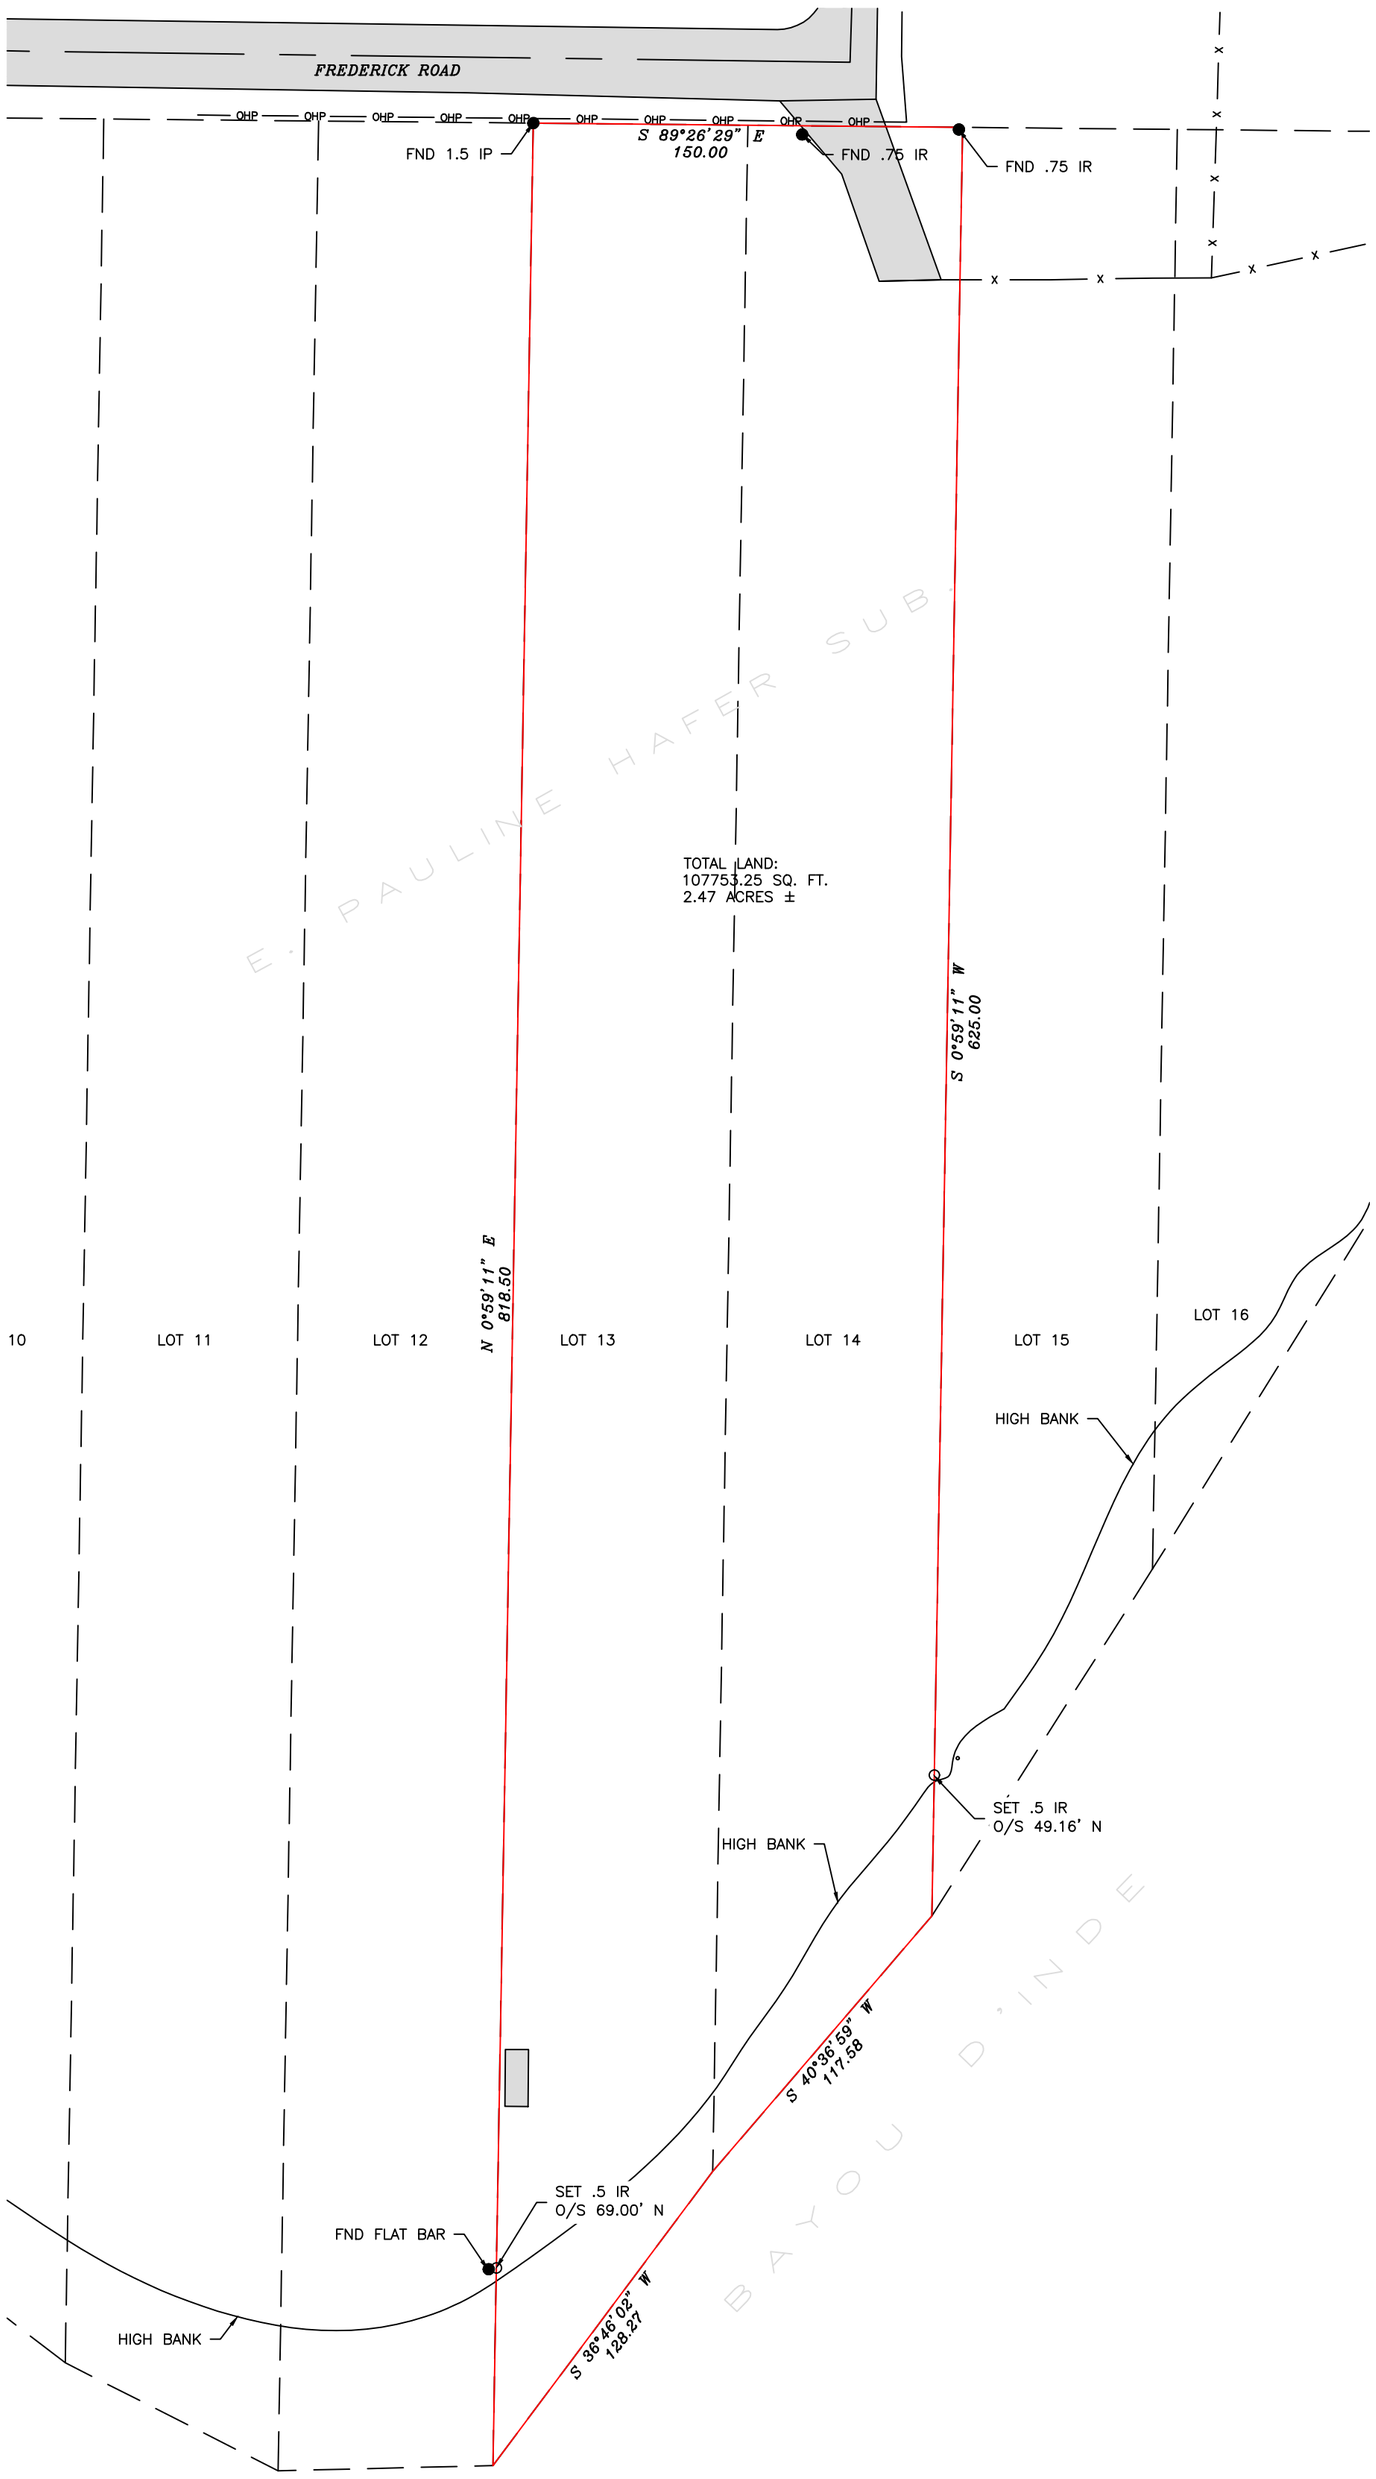

LEGEND

- IRONS FOUND IN PLACE
- 1/2" RODS SET IN PLACE
- POWER POLE
- EASEMENT OR RIGHT OF WAY LINES
- DEED OR RECORD LINES
- INTERIOR AND ADJACENT LOT LINES
- FENCES
- CENTERLINE
- OVERHEAD POWER LINES
- BUILDING TIES

LEGAL DESCRIPTION:
LOTS 13 AND 14 OF E. PAULINE HAFER SUBDIVISION. PAGE 49–3

REFERENCE PLAT:
SUBDIVISION SURVEY FOR E. PAULINE HAFER SUB. BY FRED SHUTTS C. DATED: 04/09/1948.

BASIS OF BEARINGS:
ALL BEARINGS SHOWN HEREON ARE BASED ON THE LOUISIANA SOUTH ZONE 1702, NAD 83.

SERVITUDES RESEARCH NOTE:
THE SERVITUDES AND RESTRICTIONS SHOWN ON THIS SURVEY ARE LIMITED TO THOSE SET FORTH IN THE DESCRIPTION FURNISHED US AND THERE IS NO REPRESENTATION THAT ALL APPLICABLE SERVITUDES AND RESTRICTIONS ARE SHOWN HEREON. THE SURVEYOR HAS MADE NO TITLE SEARCH OR PUBLIC RECORD SEARCH IN COMPILING THE DATA FOR THIS SURVEY.

CERTIFICATIONS:
I HEREBY CERTIFY THAT THIS PLAT REPRESENTS AN ACTUAL GROUND SURVEY MADE BY ME OR UNDER MY DIRECT SUPERVISION AND WAS PERFORMED IN ACCORDANCE WITH THE APPLICABLE PROFESSIONAL AND OCCUPATIONAL STANDARDS PER LOUISIANA ADMINISTRATIVE CODE, TITLE 46, PART LXI, CHAPTER 25, FOR A CLASS "C" SURVEY AS DEFINED IN SUBPART #2505.

STATE OF LOUISIANA
GARRY J. JOHNSON
REG. NO. 5112
REGISTERED PROFESSIONAL
LAND SURVEYOR
06/12/2026

GARRY J. JOHNSON
LA. REG. NO. 5112

FLOOD ZONE INFORMATION:
FIRM COMMUNITY–PANEL:
NO. 22019C0454 F
MAP REVISED:
02/18/2011
PROPERTY IS IN ZONE "AE,X"

SURVEY AND MAP FOR:
SUNDBACK INC.
2651 FREDERICK ROAD
SULPHUR LA 70663

GARRY J. JOHNSON AND ASSOCIATES, LLC
CIVIL ENGINEERING AND LAND SURVEYING CONSULTANTS

DATE:	SCALE:	DRAWN BY:	CHECKED BY:	W.O. NUMBER:	REVISION:	17 CENTER AVE. SULPHUR, LOUISIANA	PHONE: (337)–528–0060 EMAIL:GJJENGINEERING@YAHOO.COM
06/12/2026	1" = 50'	SAJ	GJJ	26–061			