

SQ. NO. 120, METAIRIEVILLE
JEFFERSON PARISH, LA

A Boundary Survey of Lot M-1.



CARROLLTON ST. SIDE


ST. SIDE

ST.

OAK


LIVE

PLAQUEMINES

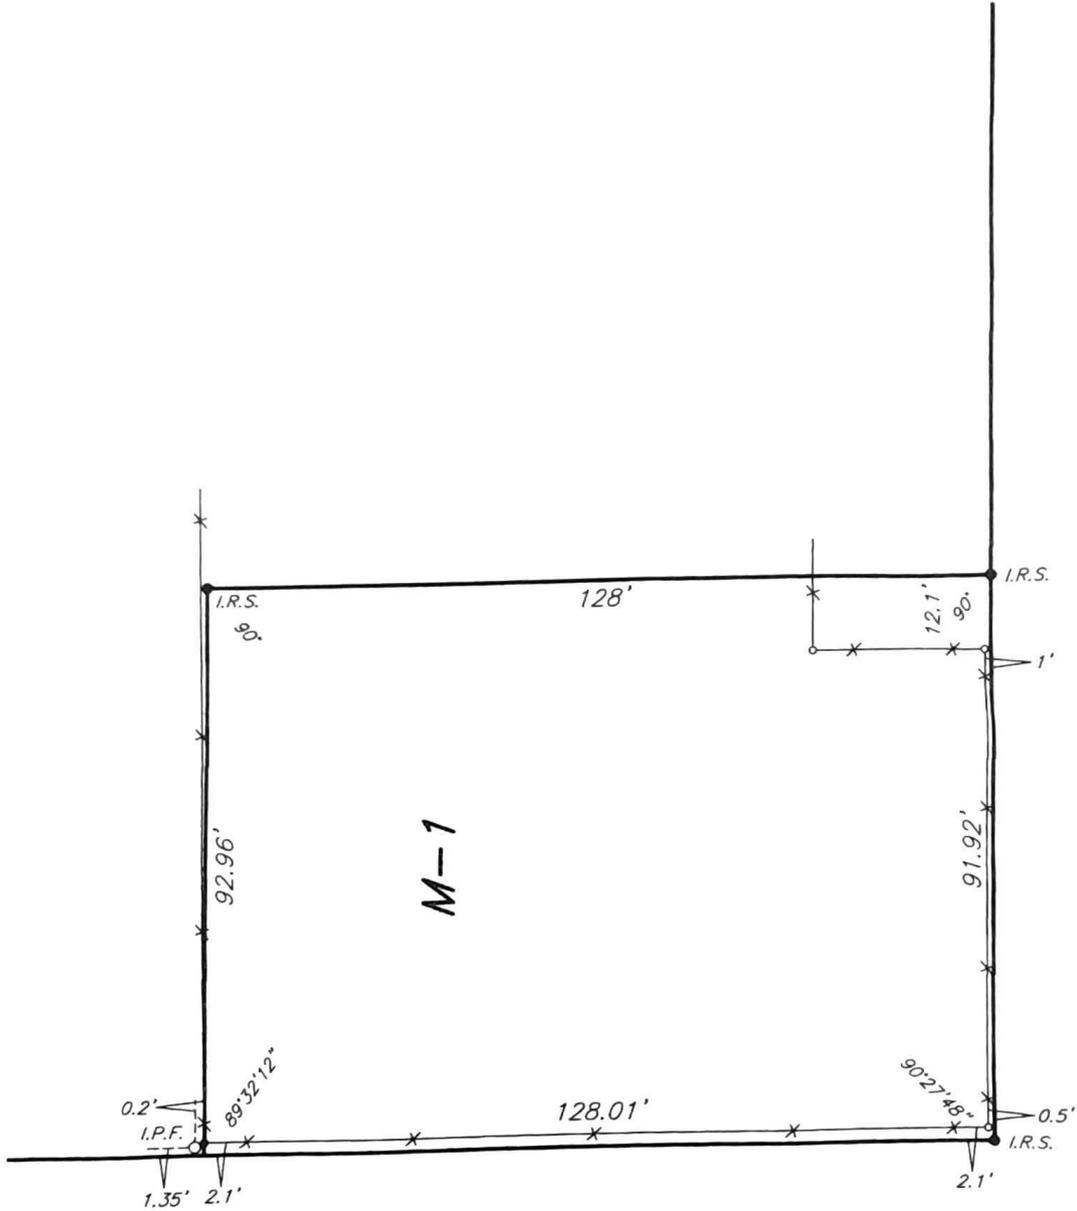

MAYAN

LANE

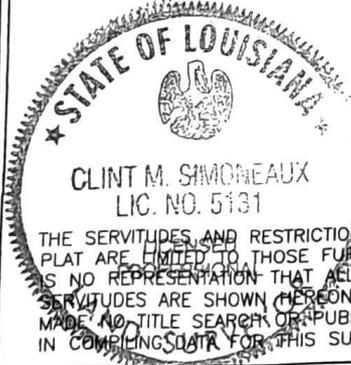

- Legend:
- I.R.S. 1/2" Iron Rod Set
 - I.R.F. 1/2" Iron Rod Found
 - I.P.F. 1/2" Iron Pipe Found
 - x — Fence

Note:
Improvements may not be to scale for clarity.
The dimensions shown prevail over scale.
Lot angles as per plan of subd.

Date: May 15, 2025

Scale: 1" = 30'

This plat represents an actual ground survey made by me or under my direct supervision and control and meets the requirements for the Standards of Practice for Boundary Surveys as found in Louisiana Administrative Code TITLE 46:LXI, Chapter 29 for a Class "C" survey.
Made at the request of AJ Breaux

Gilbert, Kelly & Couturie, Inc., Professional Land Surveying
2121 N. Causeway Blvd., Metairie LA 70001 (504) 836-2121