
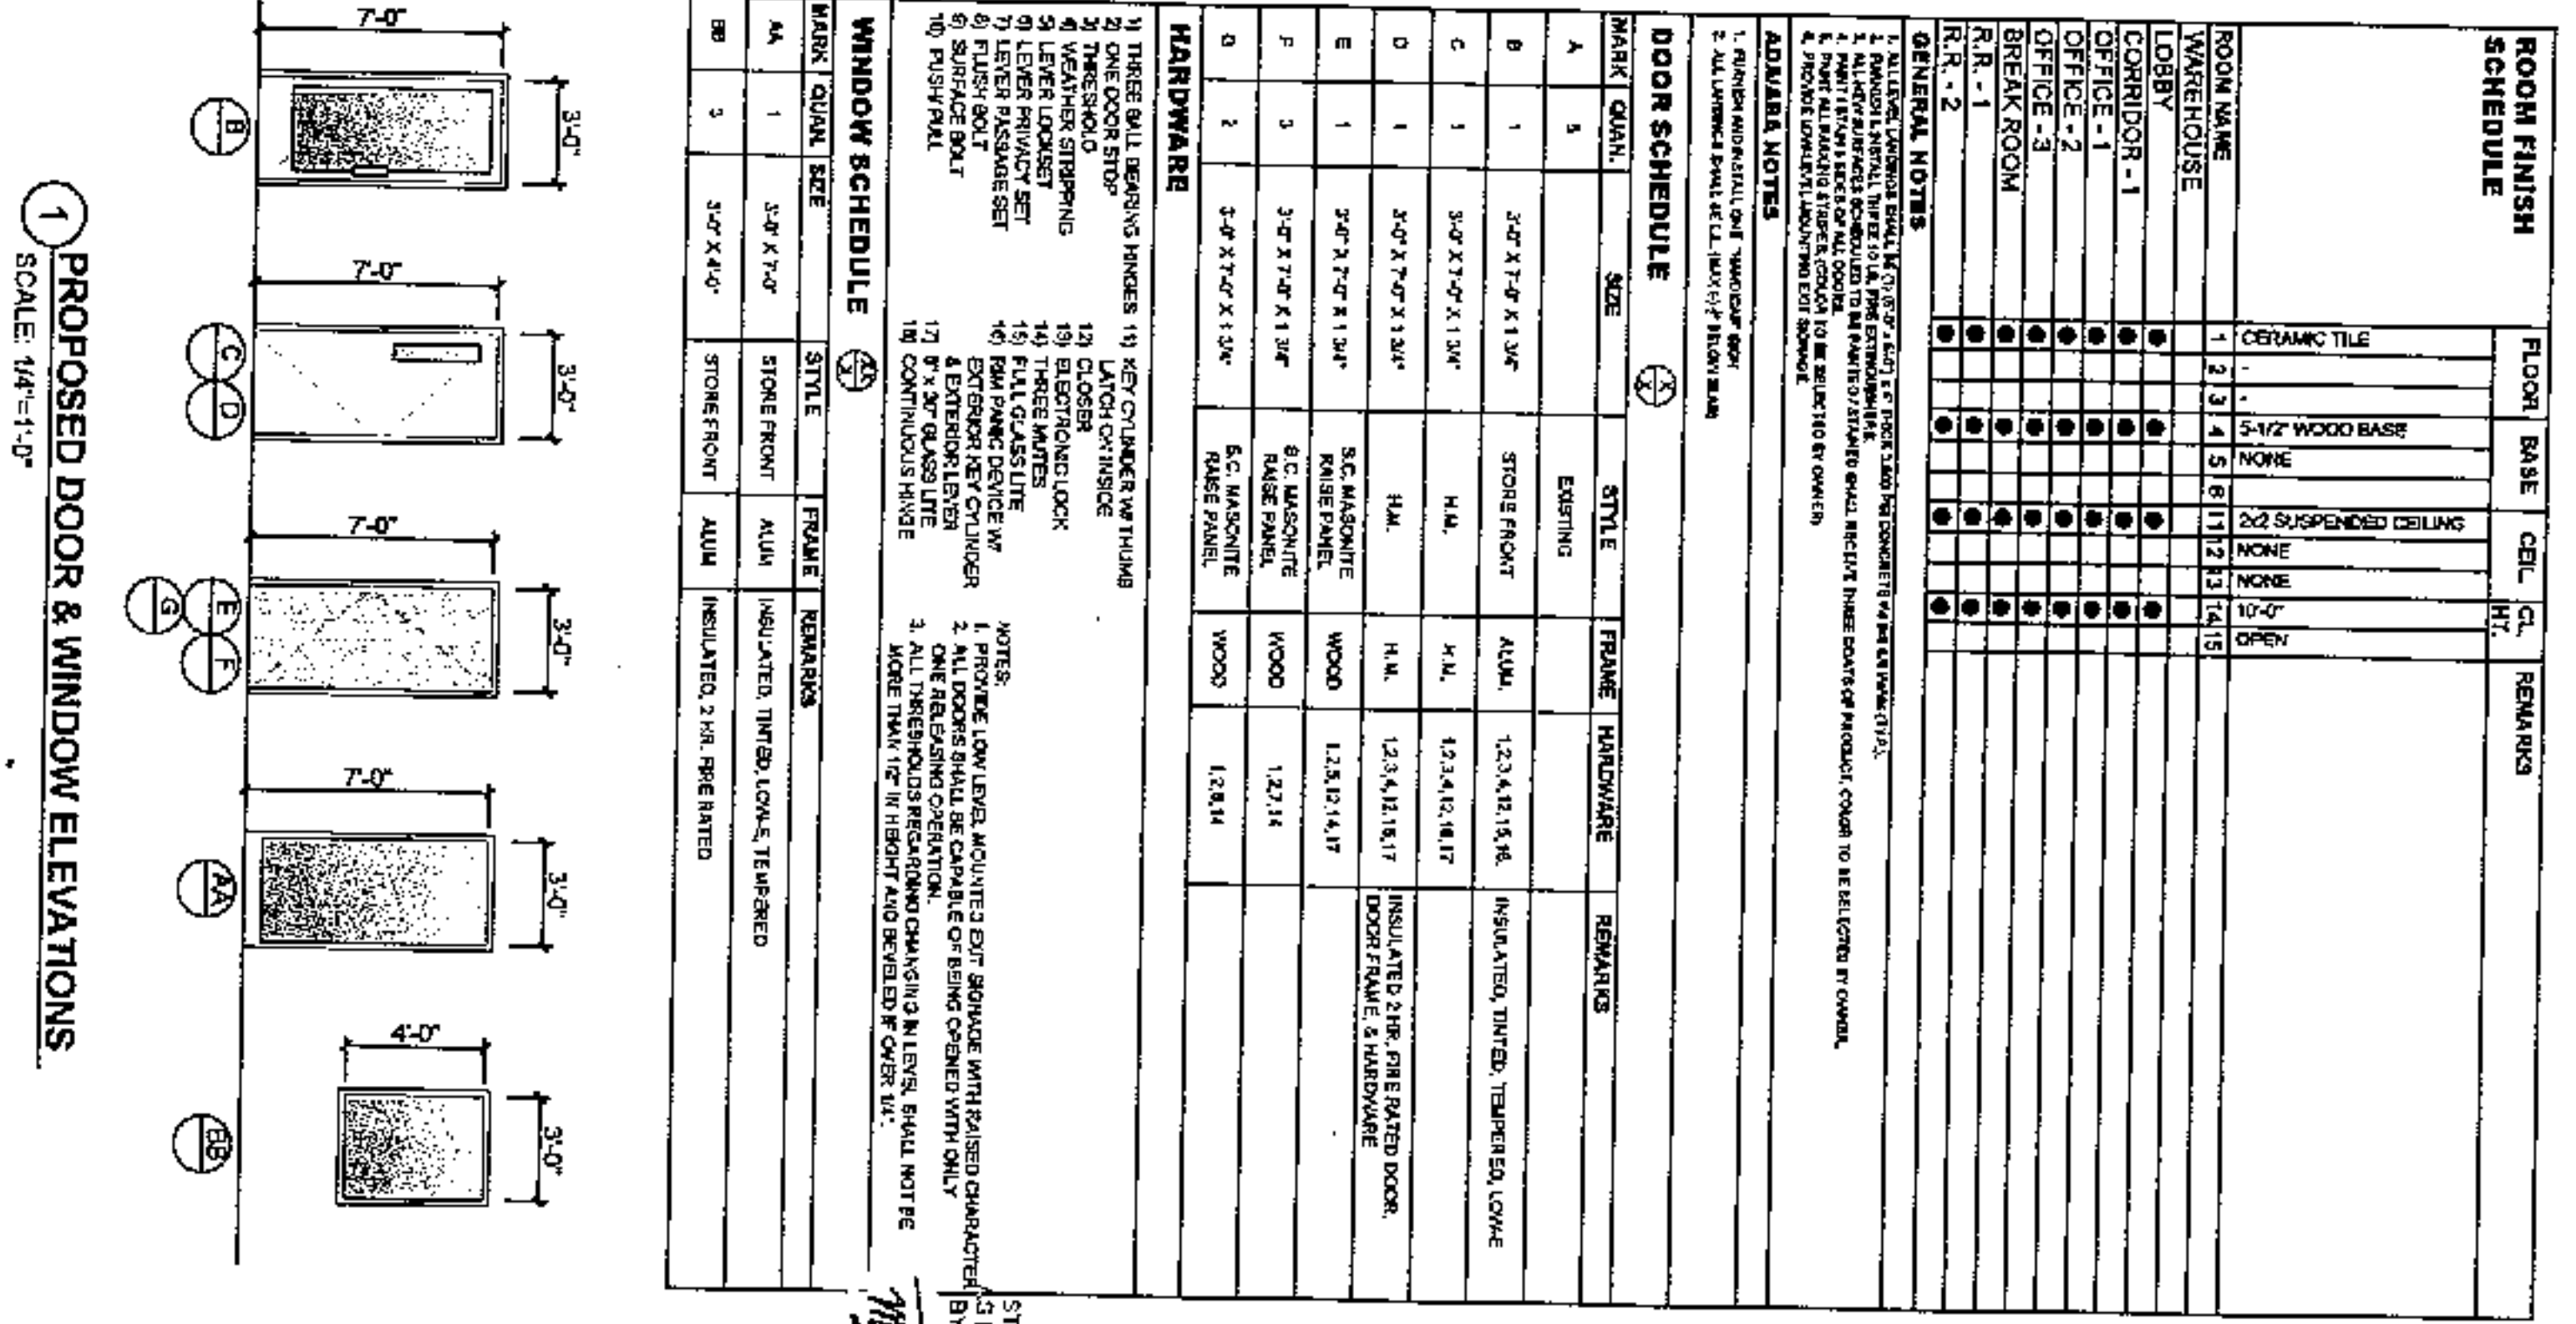


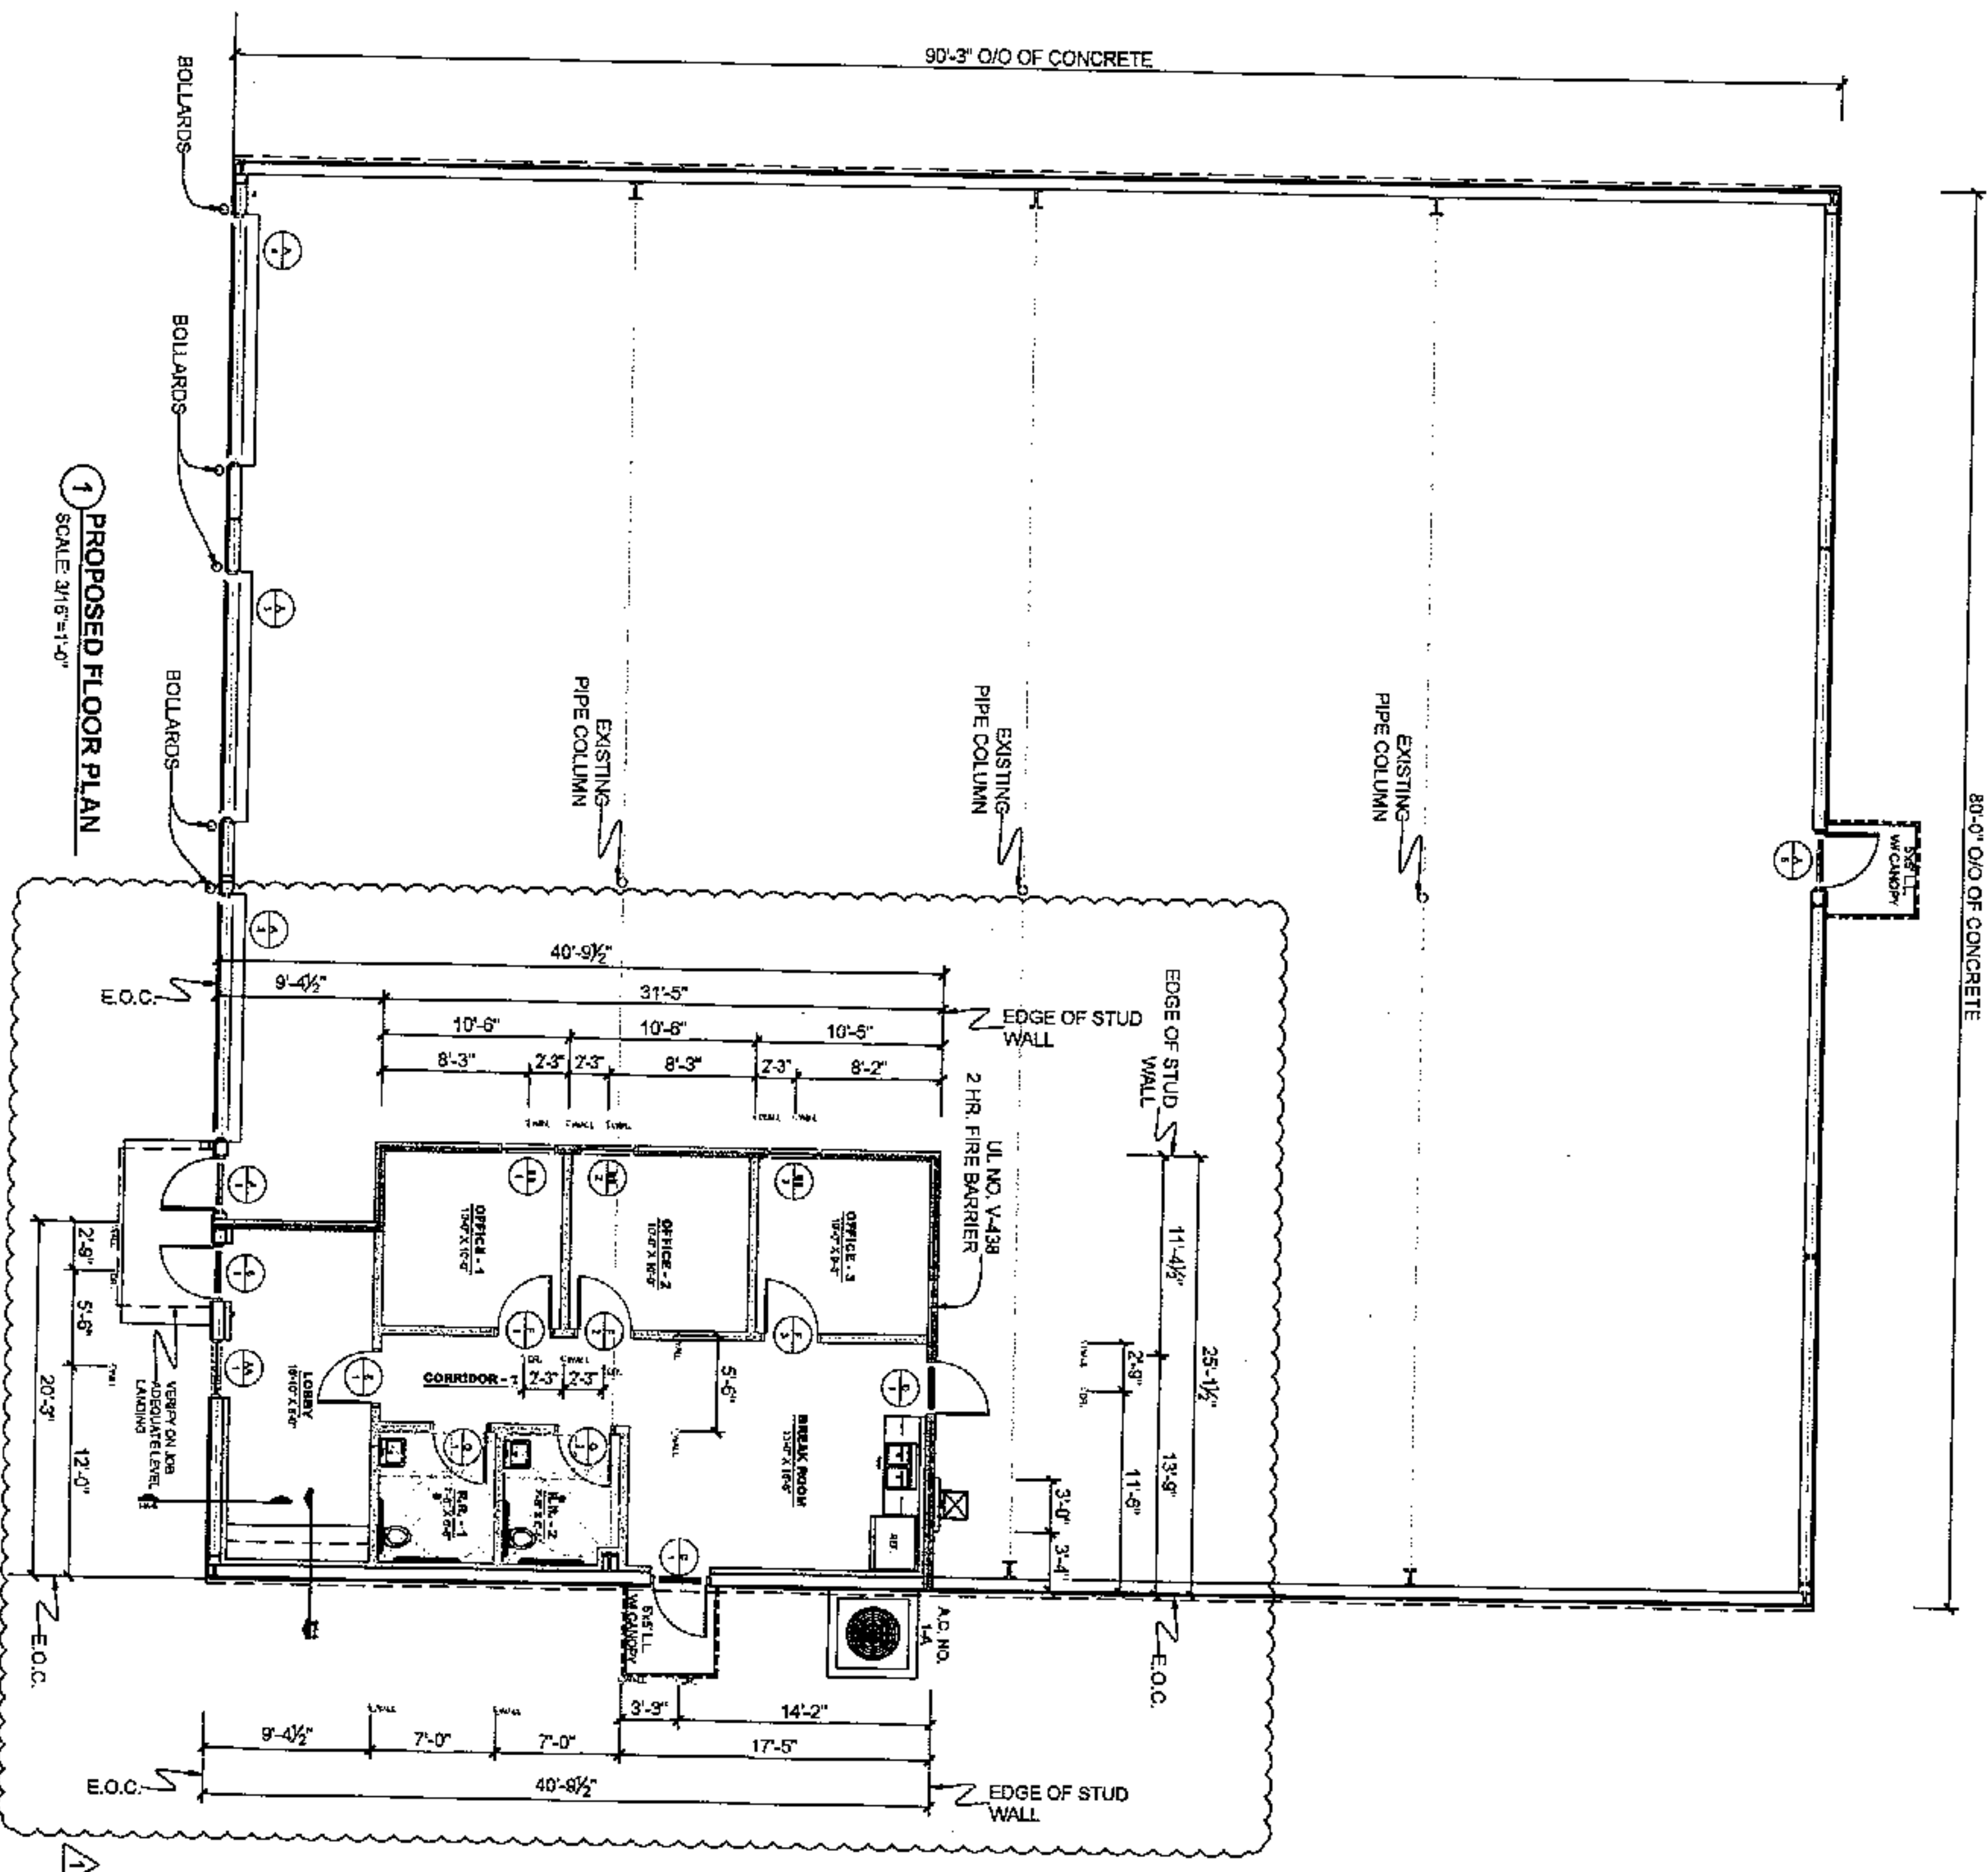

APPENDIX NO.1
DATE: 06-05-2025

A-3

CONSTRUCTION DOCUMENTS

OFFICE / WAREHOUSE RENOVATION
111 MARCON DRIVE
LAFAYETTE, LOUISIANA 70507
FOR
CHUCK LEBLANC

NO.	DATE	DESCRIPTION
1	06-05-2025	PROPOSED FLOOR PLAN, SCHEDULES, & ELEVATIONS
2		
3		
4		
5		
6		
7		
8		
9		
10		

REVIEWED FOR
STATE ARCHITECT
BY: [Signature]
DATE: 06-05-2025

