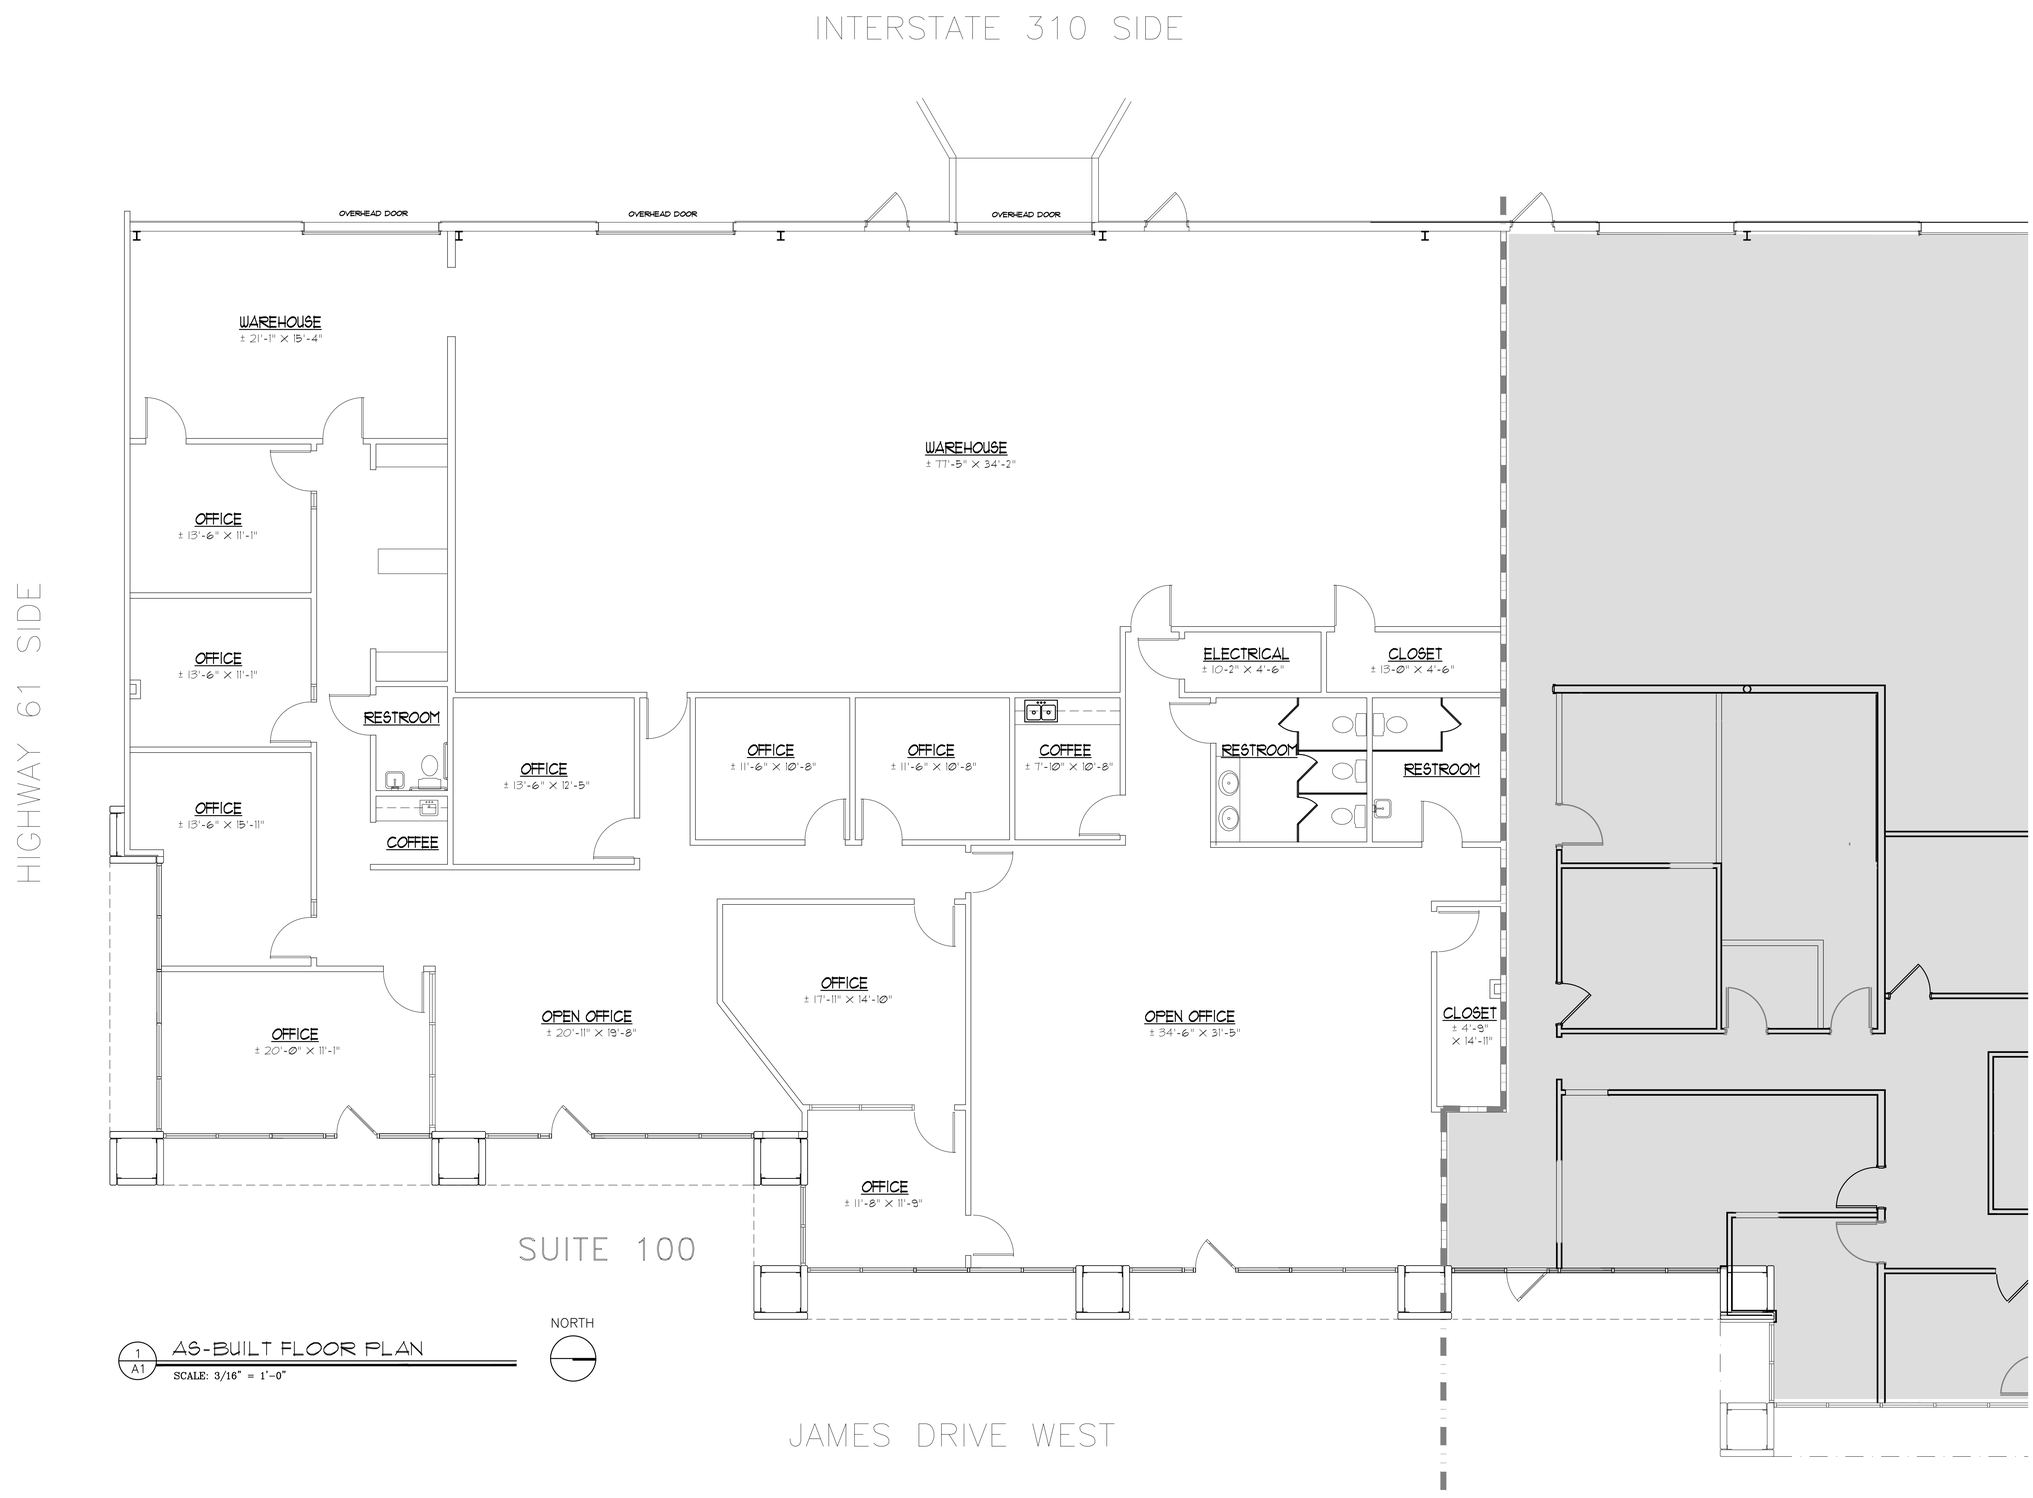

1 / A1 AS-BUILT FLOOR PLAN

SCALE: 3/16" = 1'-0"

AGL COMMERCIAL INTERIORS

AGLDESIGNS.COM

433 METAIRIE ROAD
SUITE 208

METAIRIE, LA 70005
504. 888. 7077

AS-BUILT FLOOR PLAN

SUITE 100

125 JAMES PARK WEST
ST. ROSE, LA.

ISSUE DATE 06-10-25

PROJECT NO. 12158

DRAWN BY RR

CHECKED BY

A-1

SHEET 1 OF 1