


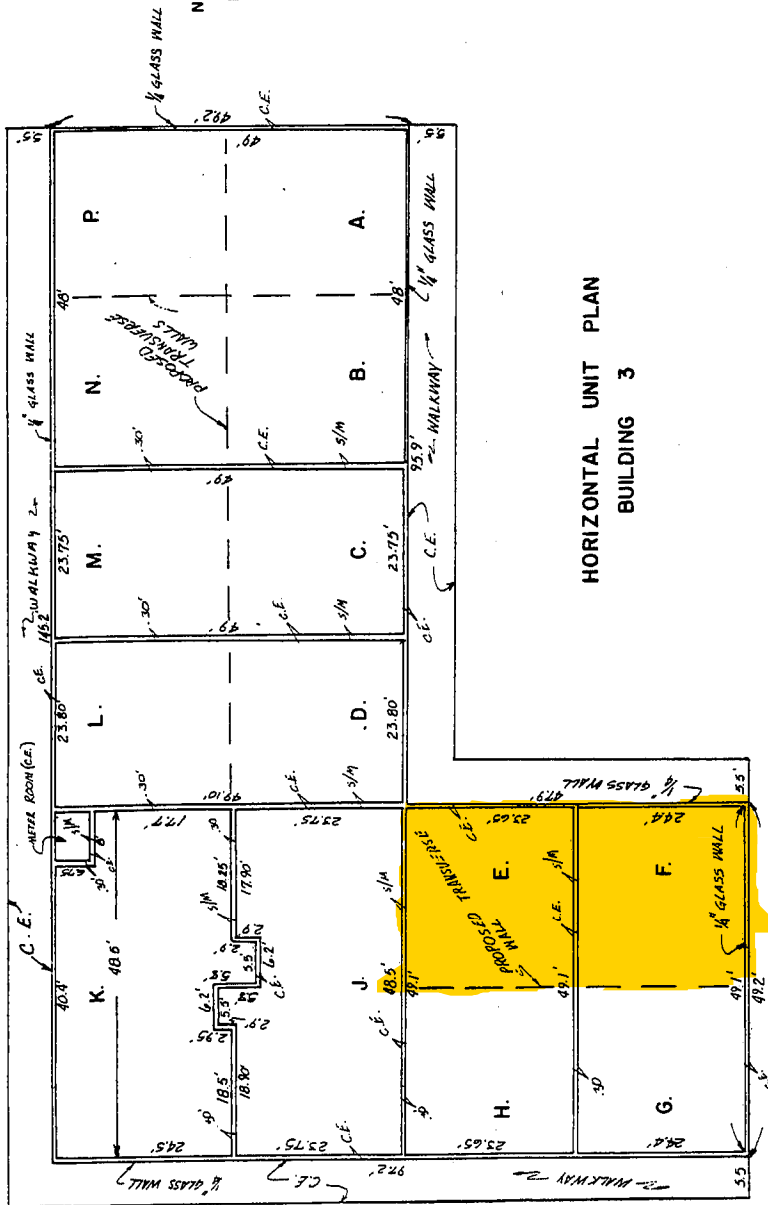

HORIZONTAL UNIT PLAN BUILDING 3

SURVEY CERTIFIED CORRECT TO:
REINDEER II, A PARTNERSHIP

AS A HORIZONTAL SURVEY OF UNITS 3A THRU 3H, 3J THRU 3N, 3P
CREATED AS CONDOMINIUM UNITS ACCORDING TO THIS SURVEY
AND THAT NOTES HEREON ARE TRUE AND CORRECT.

Joseph M. Marques
JOSEPH M. MARQUES
REG. NO. 4457

NOTES:

- 1) C.E. = COMMON ELEMENT
- 2) WIDTH OF UNITS ARE MEASURED FROM:
a) OUTSIDE SURFACE OF SHEETROCK WALLS AT RIGHT ANGLES.
b) OUTSIDE SURFACE OF SHEETROCK WALL TO INSIDE SURFACE OF GLASS WALL AT RIGHT ANGLES.
c) INSIDE SURFACE OF GLASS WALLS AT RIGHT ANGLES.
- APPLY OPTIONS a, b, OR c WHERE APPLICABLE.
- 3) S/M = SHEETROCK WITH METAL STUDS.
- 4) METER ROOM SUBJECT TO AGREEMENT WITH N.O.P.S.I.

HORIZONTAL UNIT PLANS BUILDING 3

DEER PARK BUSINESS PARK

THIRD DISTRICT

APPROVED BY

SCALE: 1" = 15'

DATE: 4-6-83

UNIVERSAL LAND SURVEYORS, INC.

DRAWING NUMBER