
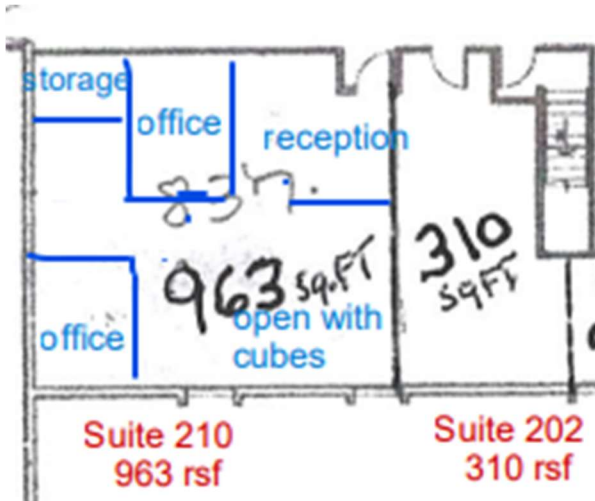
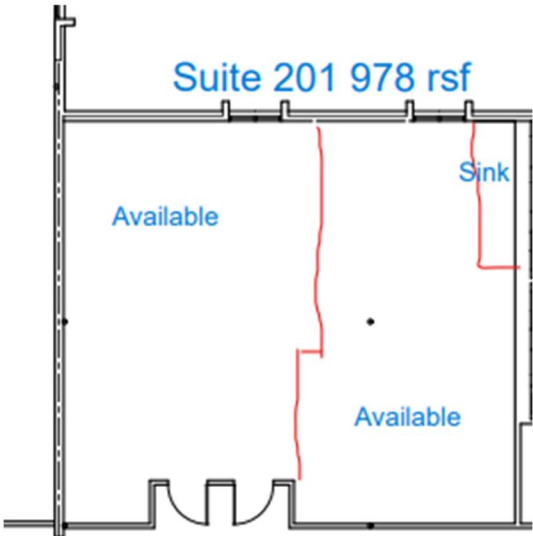


3229 36th Street Available Space

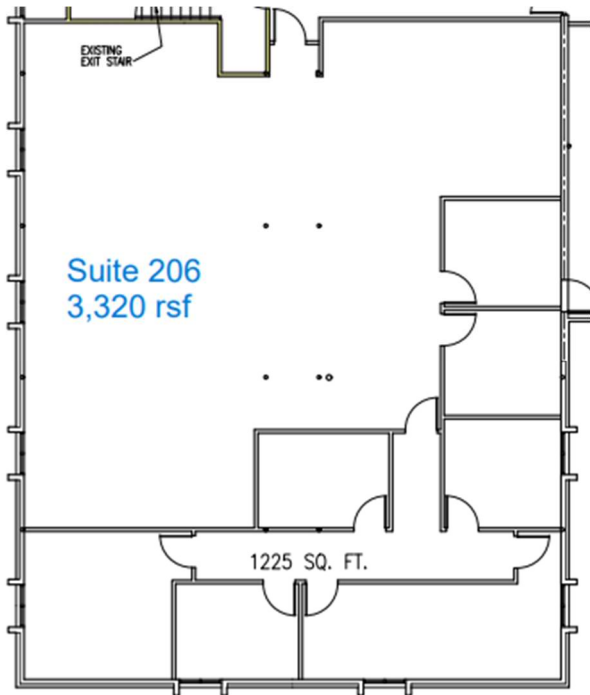

FLOOR PLAN