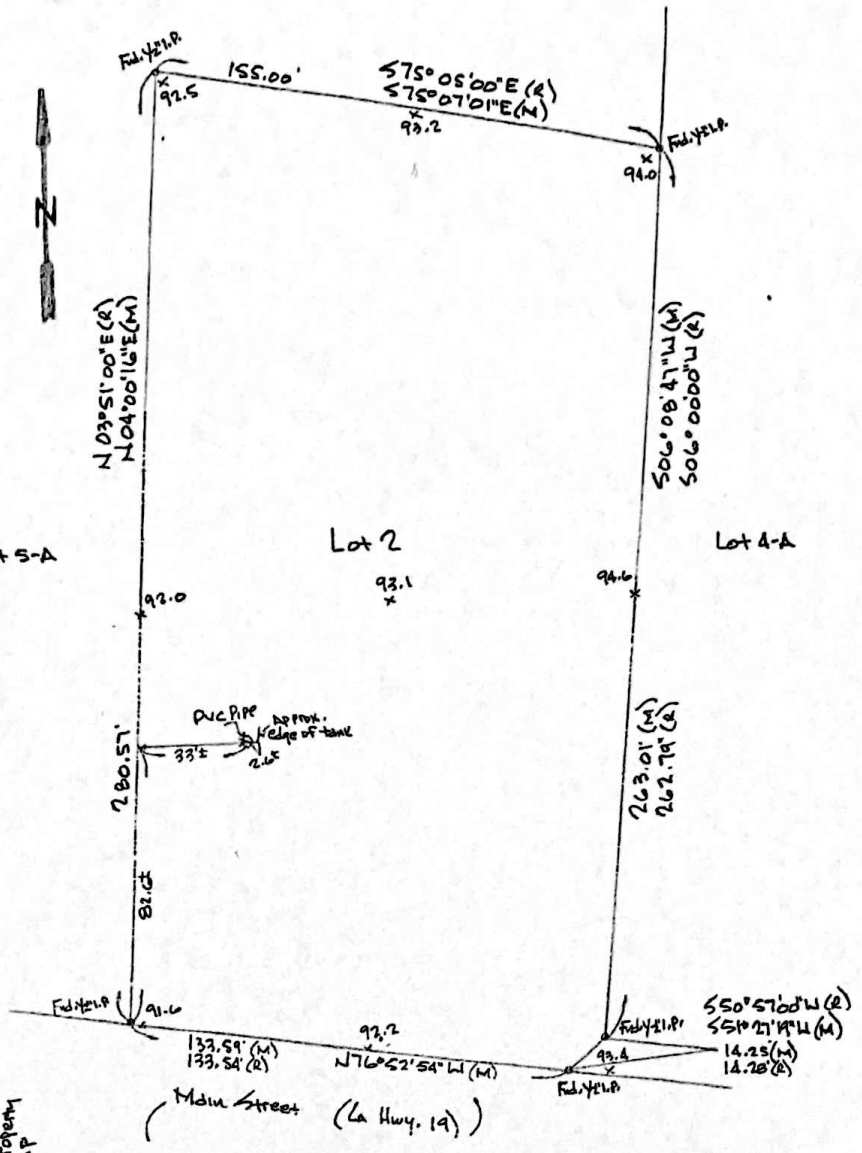



Reference Map: Map showing the resubdivision of an unlabeled tract and Lots 4 & 5 into Tract X, Lot 4-A & Lot 5-A, by P. Daniel Willgruss, P.L.S., dated 11/24/94

Base Bearing N76°52'54"W, being the Property line along Main Street, referenced from Map

(M) Denotes Measured (R) Denotes Recorded

O.D. Denotes actual ground elevations

# *MAP SHOWING SURVEY OF*

Lot 2 — 1.44 Buildable Tract

Municipal — 9981 Main Street (La Hwy. 19)

## *IN THE PARISH OF EAST BATON ROUGE LOUISIANA*

**FOR**

Transmission Service Connection (Michael Decs-Owner)

**To all parties interested in title to premises surveyed:-**

**I hereby certify that the above shown survey was actually made on the ground, as per record description, and is correct, and that there are no encroachments either way across property lines.**

**Baton Rouge, La.**

**Date:** 1/10/2024

STATE OF LOUISIANA
PHILIP [illegible] THOMAS
License [illegible] 4602
REGISTERED PROFESSIONAL
LAND SURVEYOR

**Certification: According to the applicable standards of practice, as stipulated in L.A.C., Title 46, Section 2501 Et. Seq., this conforms to a class "C" survey.**

According to the East Baton Rouge Parish, FEMA, F.I.R.M. No. 220058-_____, dated _____, this property lies within zone _____

**Scale: 1" = 40'**