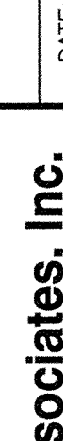


1	OF	1
SHEET NO. 1		
JOB: ALTA/ACSM LAND TITLE SURVEY FOR W.W. GRAINGER, INC.		
OWNER: MOUNTAIN VENTURES W.W.G. VII, LLC.		
DESIGNED BY: N/A	DATE: 1/28/09	GSE Associates, Inc.  Pearre, Louisiana 70383 (504) 833-6600 20115 North Woodman Ave. Suite 201 Metairie, Louisiana 70001-7402 (504) 885-8800 800 Younga Road Morgan City, Louisiana 70381 (807) 334-4635 www.gulf-south.com ENGINEERS • ARCHITECTS • SURVEYORS
DRAWN BY: TJM	SCALE: 1" = 20'	
CHECKED BY:	PLOT SCALE: 20	
A.A.D. JR	JOB NO. 98704.09	
REVISIONS		DATE:
REMARKS:		APP'D:
CADD FILE NAME: MysticLOTS05shrubASBUILT.dwg		