


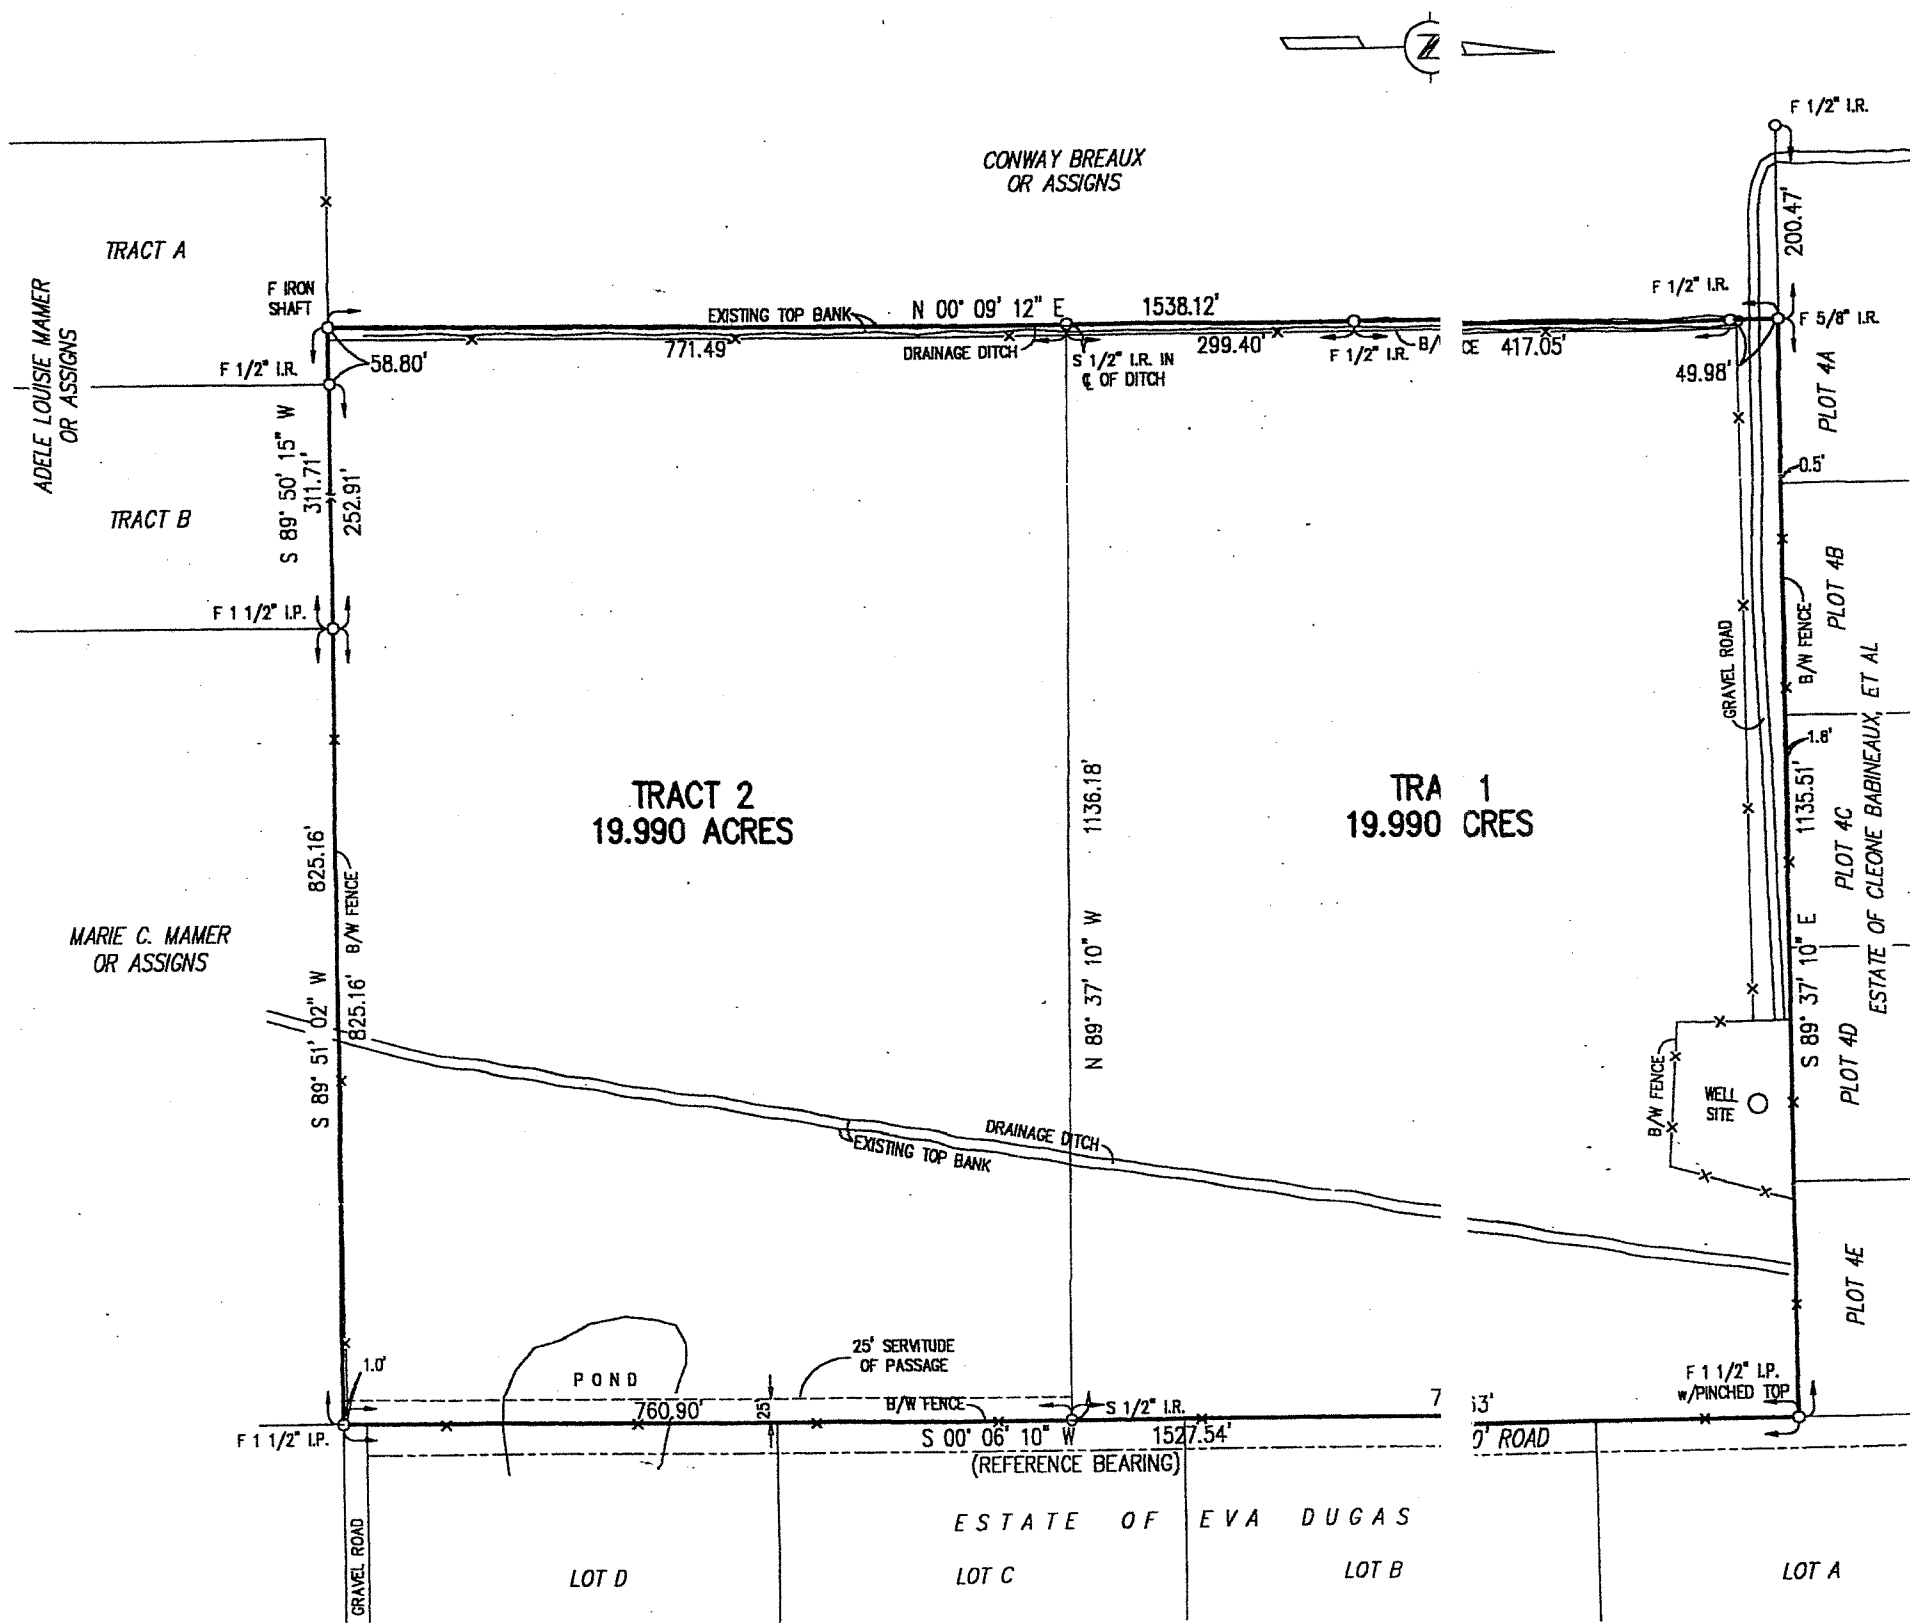

NOTE: This survey was conducted by me or under my direct supervision based on standards for Class C surveys in accordance with the minimum standards for property boundary surveys as adopted by the Board of Registration for Professional Engineers and Land Surveyors.

Bearings & Plot are referenced to Plot recorded under Act No. 349495.

Title lines not proven.

Property may be subject to R/W's, Servitudes, and/or Easements that are not shown.

Tract 1 to be acquired by Elizabeth Renee Savoie.

Tract 2 to be acquired by John A. Hernandez, Jr.

A Plat of Survey showing partition property of

ELIZABETH RENEE SAVOIE
and
JOHN A. HERNANDEZ, JR.

located in
Section 33, T-8-S, R-4-E
Lafayette Parish, Louisiana

Scale: 1" = 200' Date: September 13, 2002

prepared by
Michael J. Breau & Associates, Inc.
Professional Land Surveyors
Lafayette, Louisiana

Revised 12-09-02

