


Schedule I to Exhibit A
Floor plan Specifications

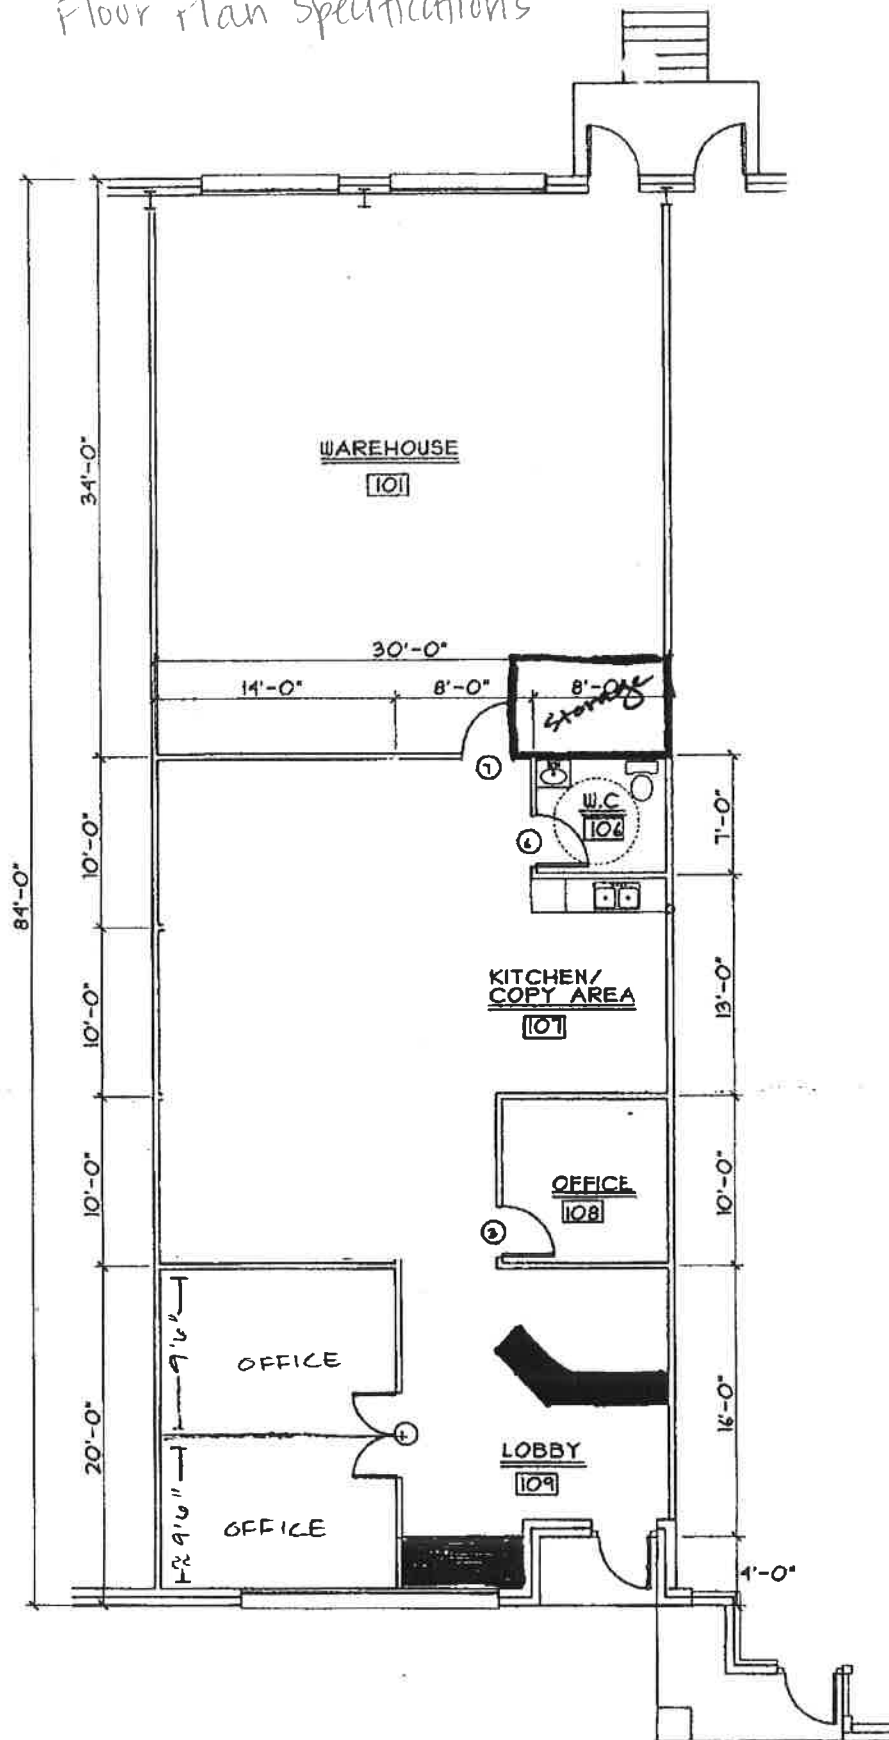

FLOOR PLAN
BUILDING #1-SUITE "U"
Refined Technologies

for