


62'-3 1/2"

1200 #

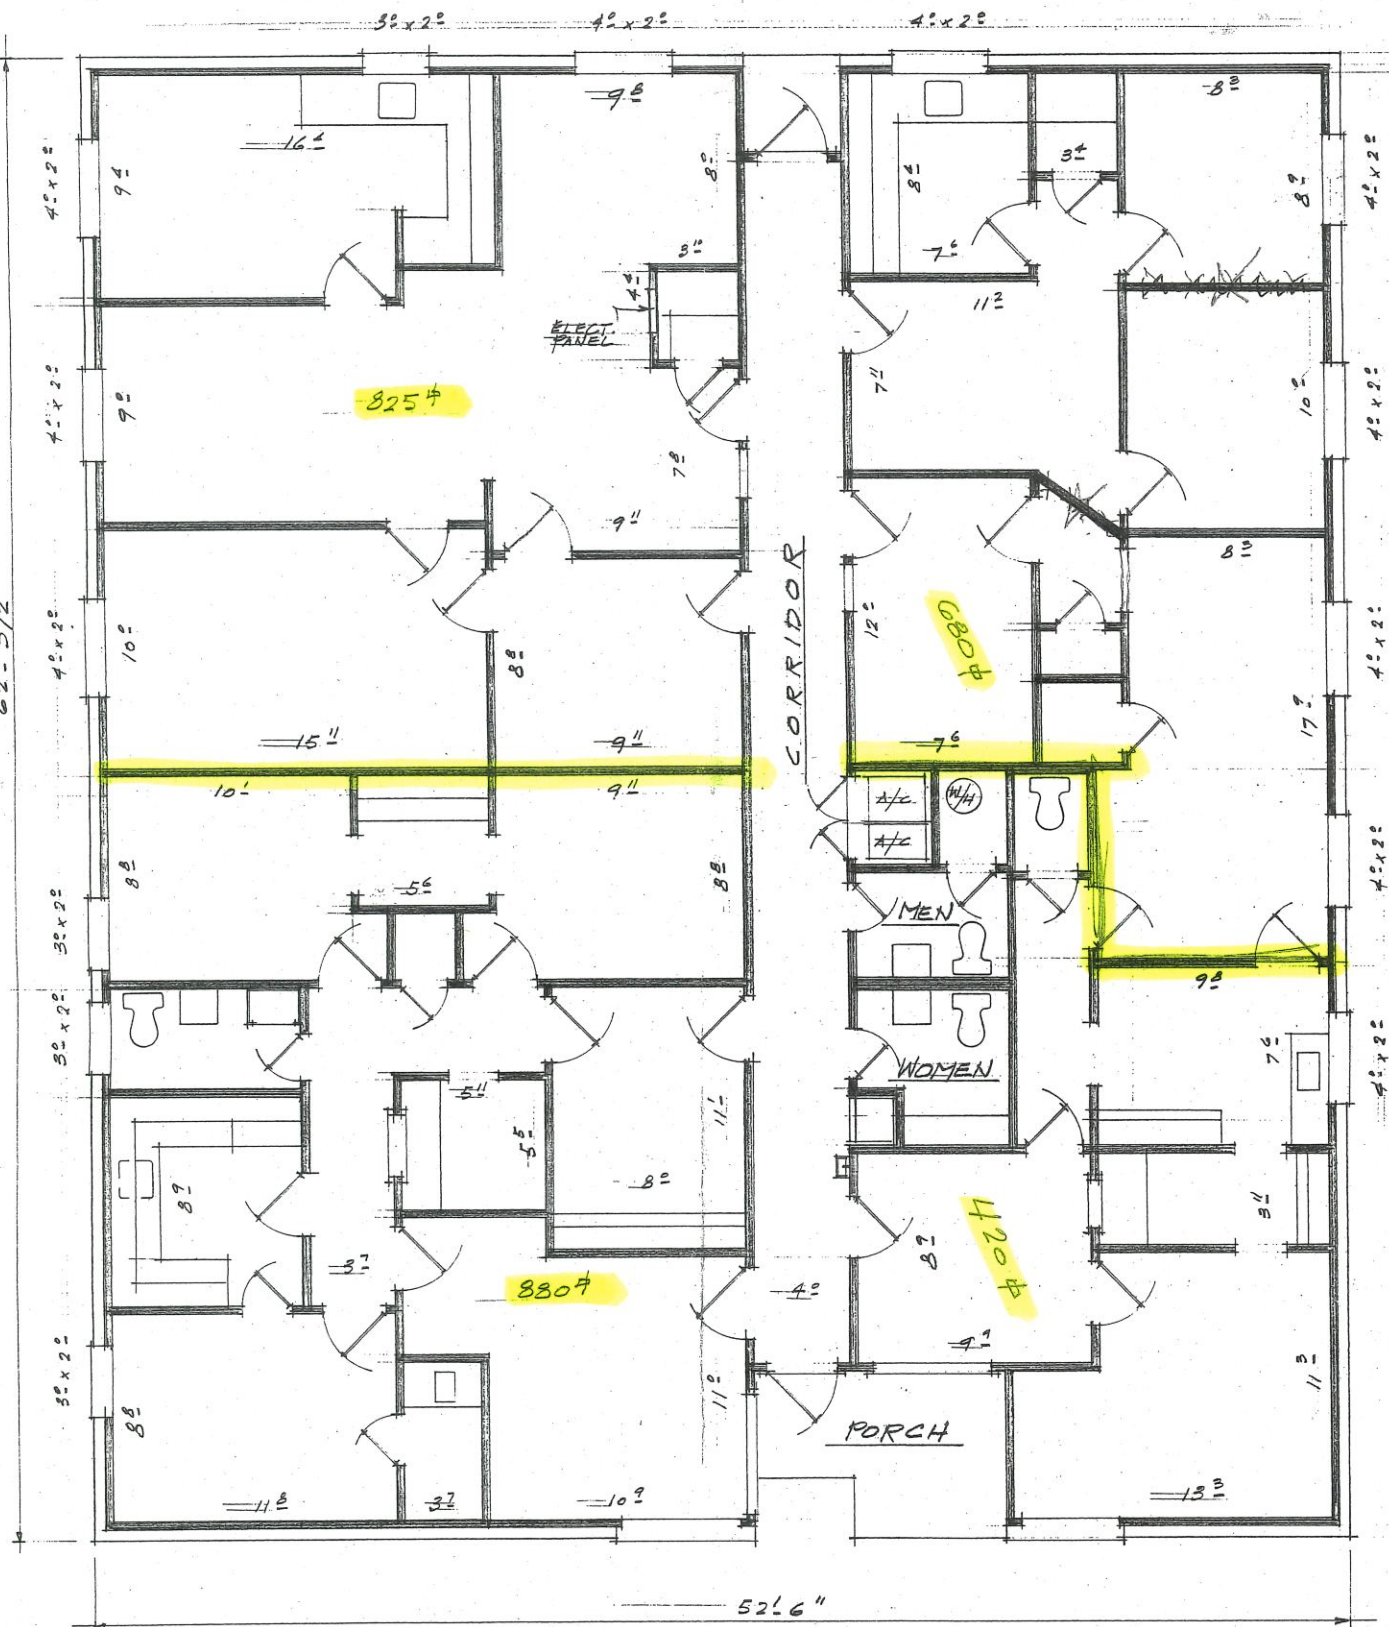

FLOOR PLAN

SCALE: 1/4" = 1'-0"

SQ. FT. 3180