


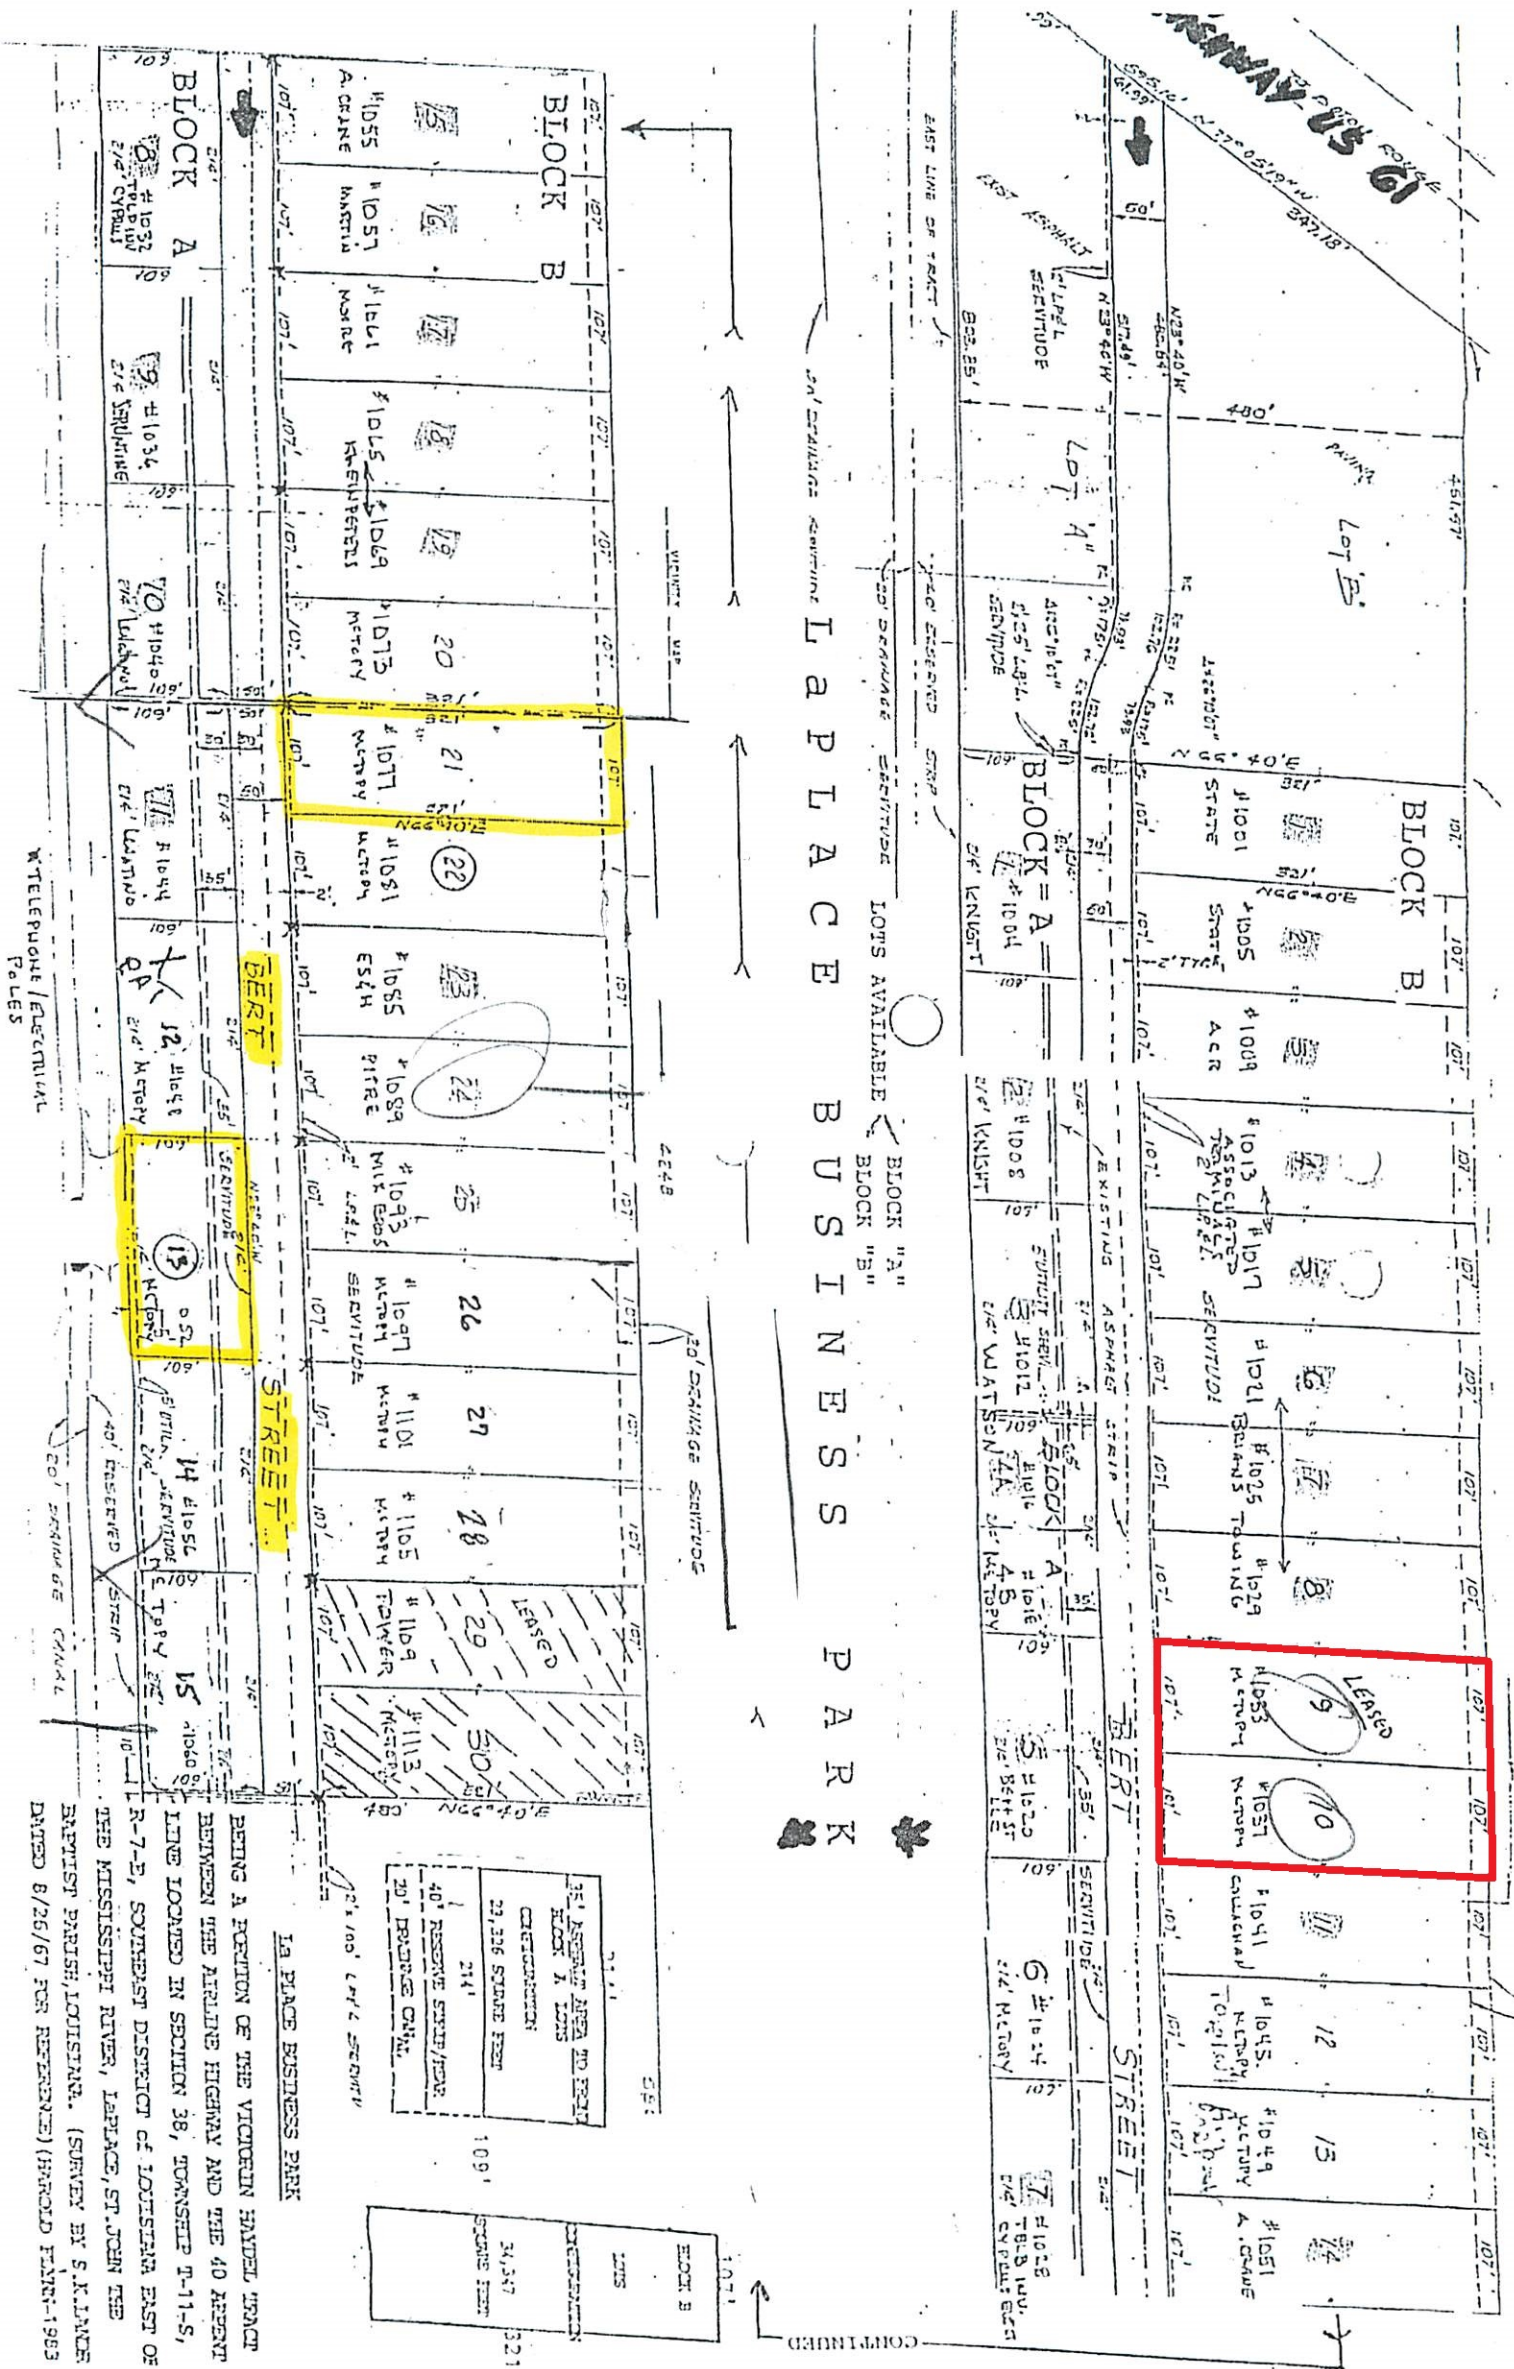

CONTINUED