


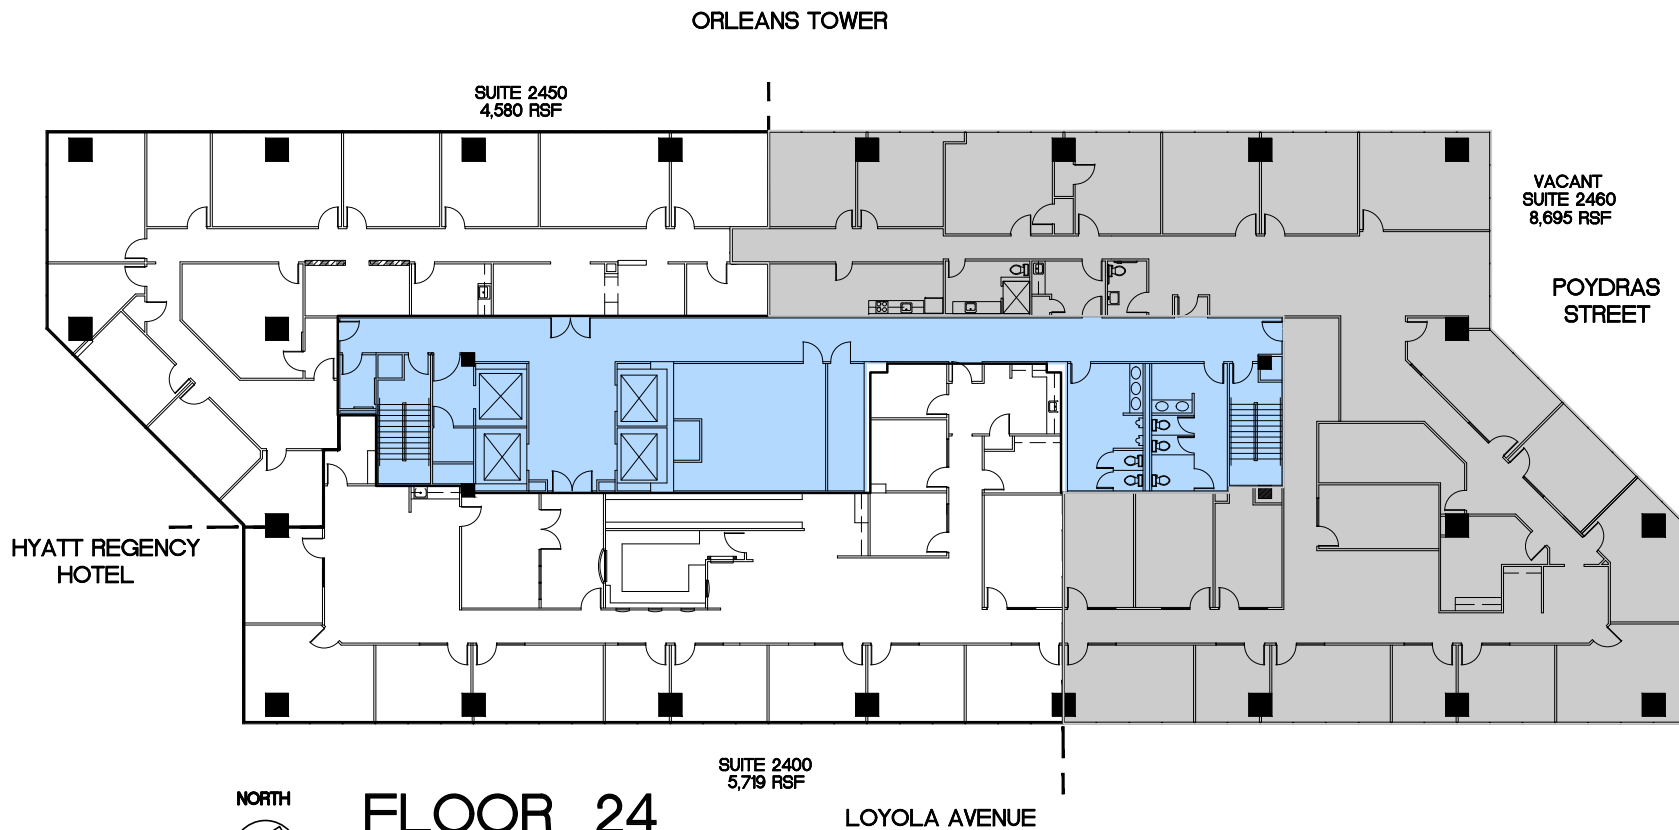

10157	DATE	05-09-22
9088	DATE	09-11-20
9088	DATE	09-03-20
TASK NO.	FLOOR	SHEET
	24	AB

FLOOR 24
1250 POYDRAS STREET
NEW ORLEANS, LA

PROJECT

