


City of Shreveport
 2121 Fairfield Avenue, Suite 100
 Shreveport, LA 71104
 9,000 sf

The room dimensions hereunder are approximations
 and are interior room measurements

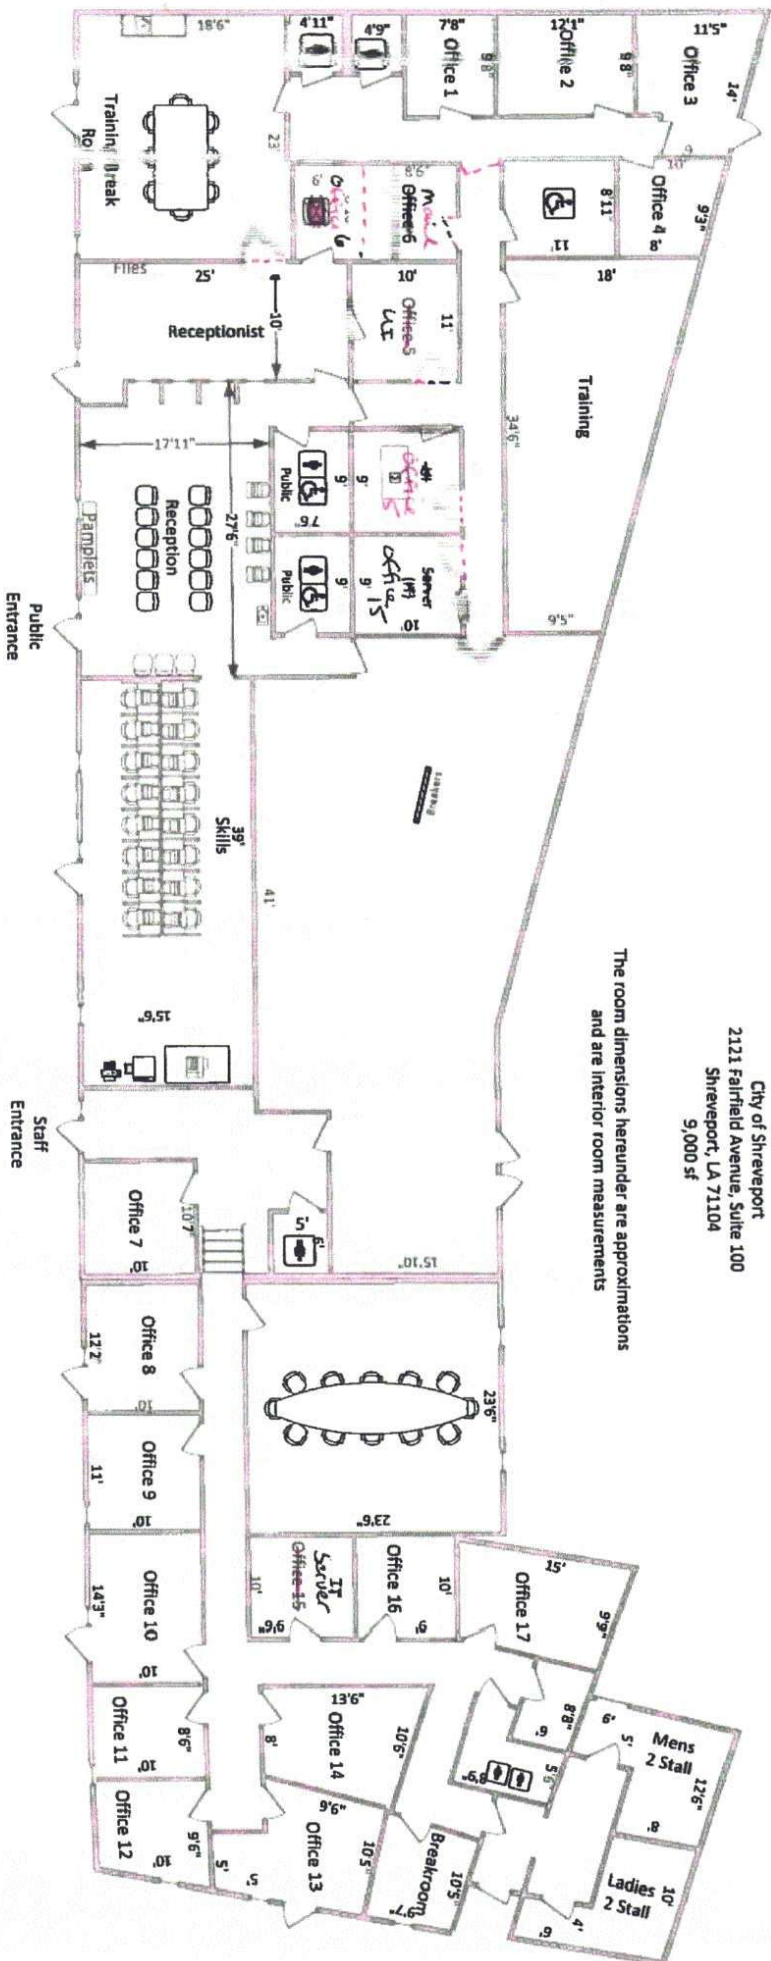

Remove
 new placement