


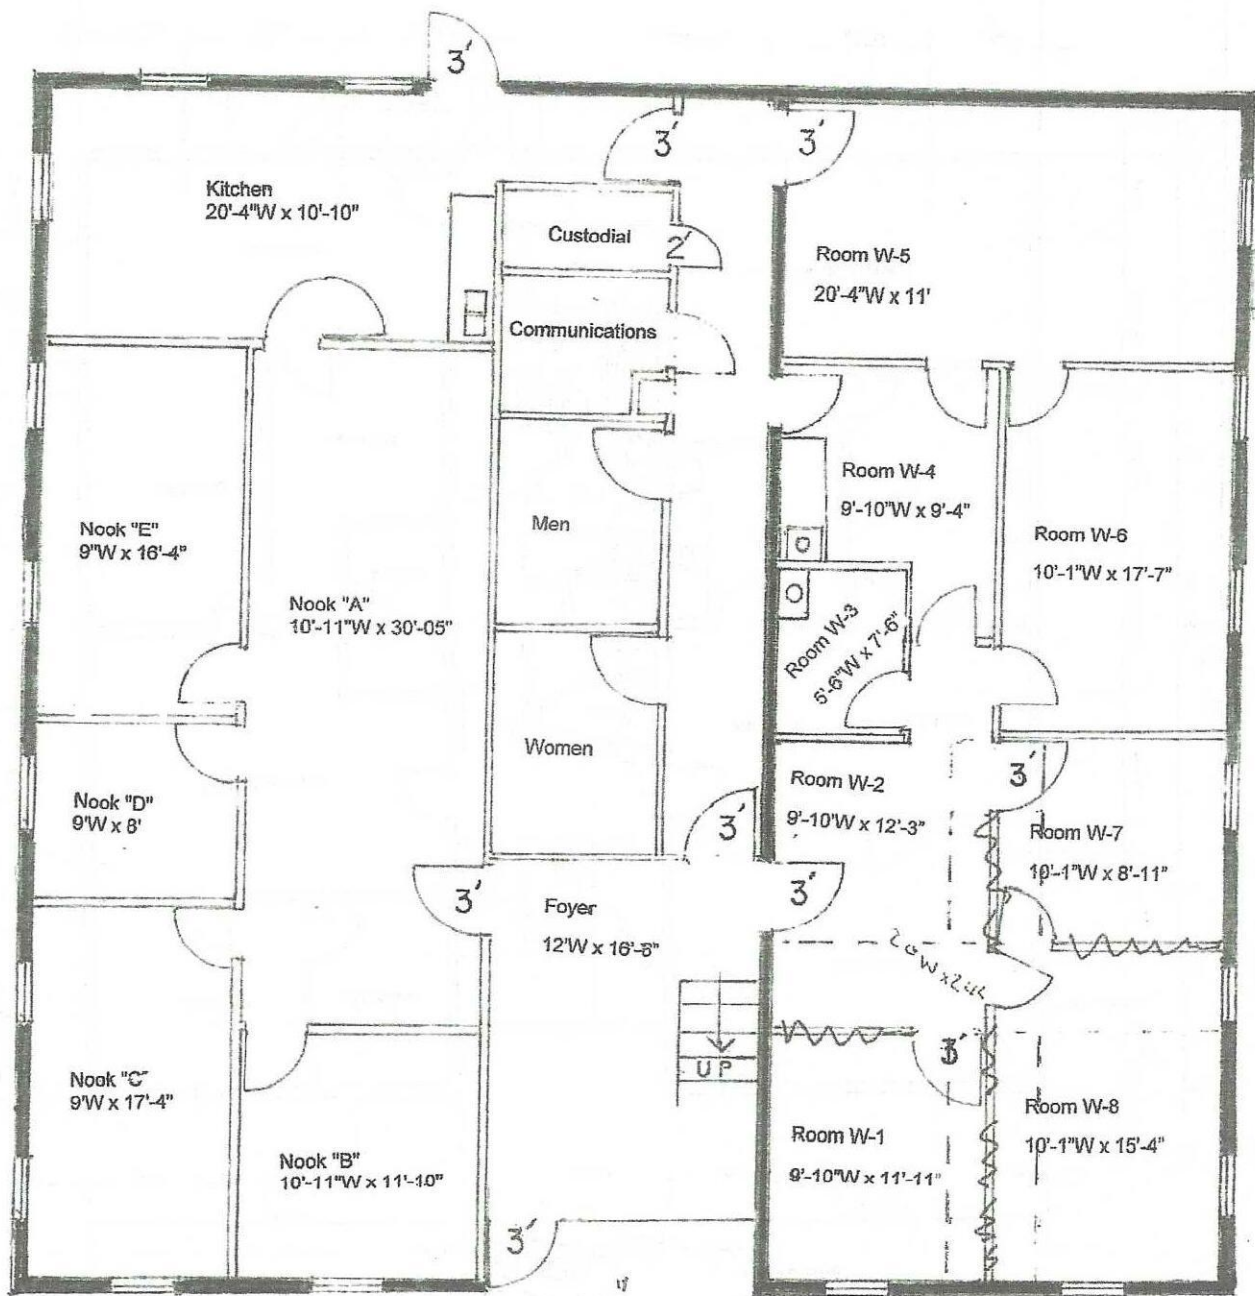

12' x 4'
9' x 4'
20' x 4'

107 Montrose (6/17/2014)

Ground floor layout

This structure is 55.2' square.

24 x 20
480 SF
3025 S.F.

The dark shaded interior wall is the same thickness as the outside walls and is probably a supporting wall for the 2nd floor. Interior doors are 2'-8" unless noted otherwise.