


1 FLOOR PLAN  
A1.0 SCALE: 1/8"=1'-0"

 

Essential Service for  
Architects, Builders,  
Remediers, etc....  
**Helihawk Associates**  
COMPREHENSIVE SITE SURVEYS  
Phone: (618) 656-8440  
Fax: (618) 656-8441  
helihawk@charter.net  
1315 GERBER WOODS DR.  
Edwardsville, IL 62025

CORT FURNITURE  
BATON ROUGE, LA  
4810 CONSTITUTION AVENUE

CORT FURNITURE  
11250 WAPLES MILL RD.  
SUITE 500  
FAIRFAX, VA 22030

ISSUE DATE:  
4/18/07

PROJECT NO 7261  
DRAWN BY CBM

FLOOR  
PLAN

A1.0