


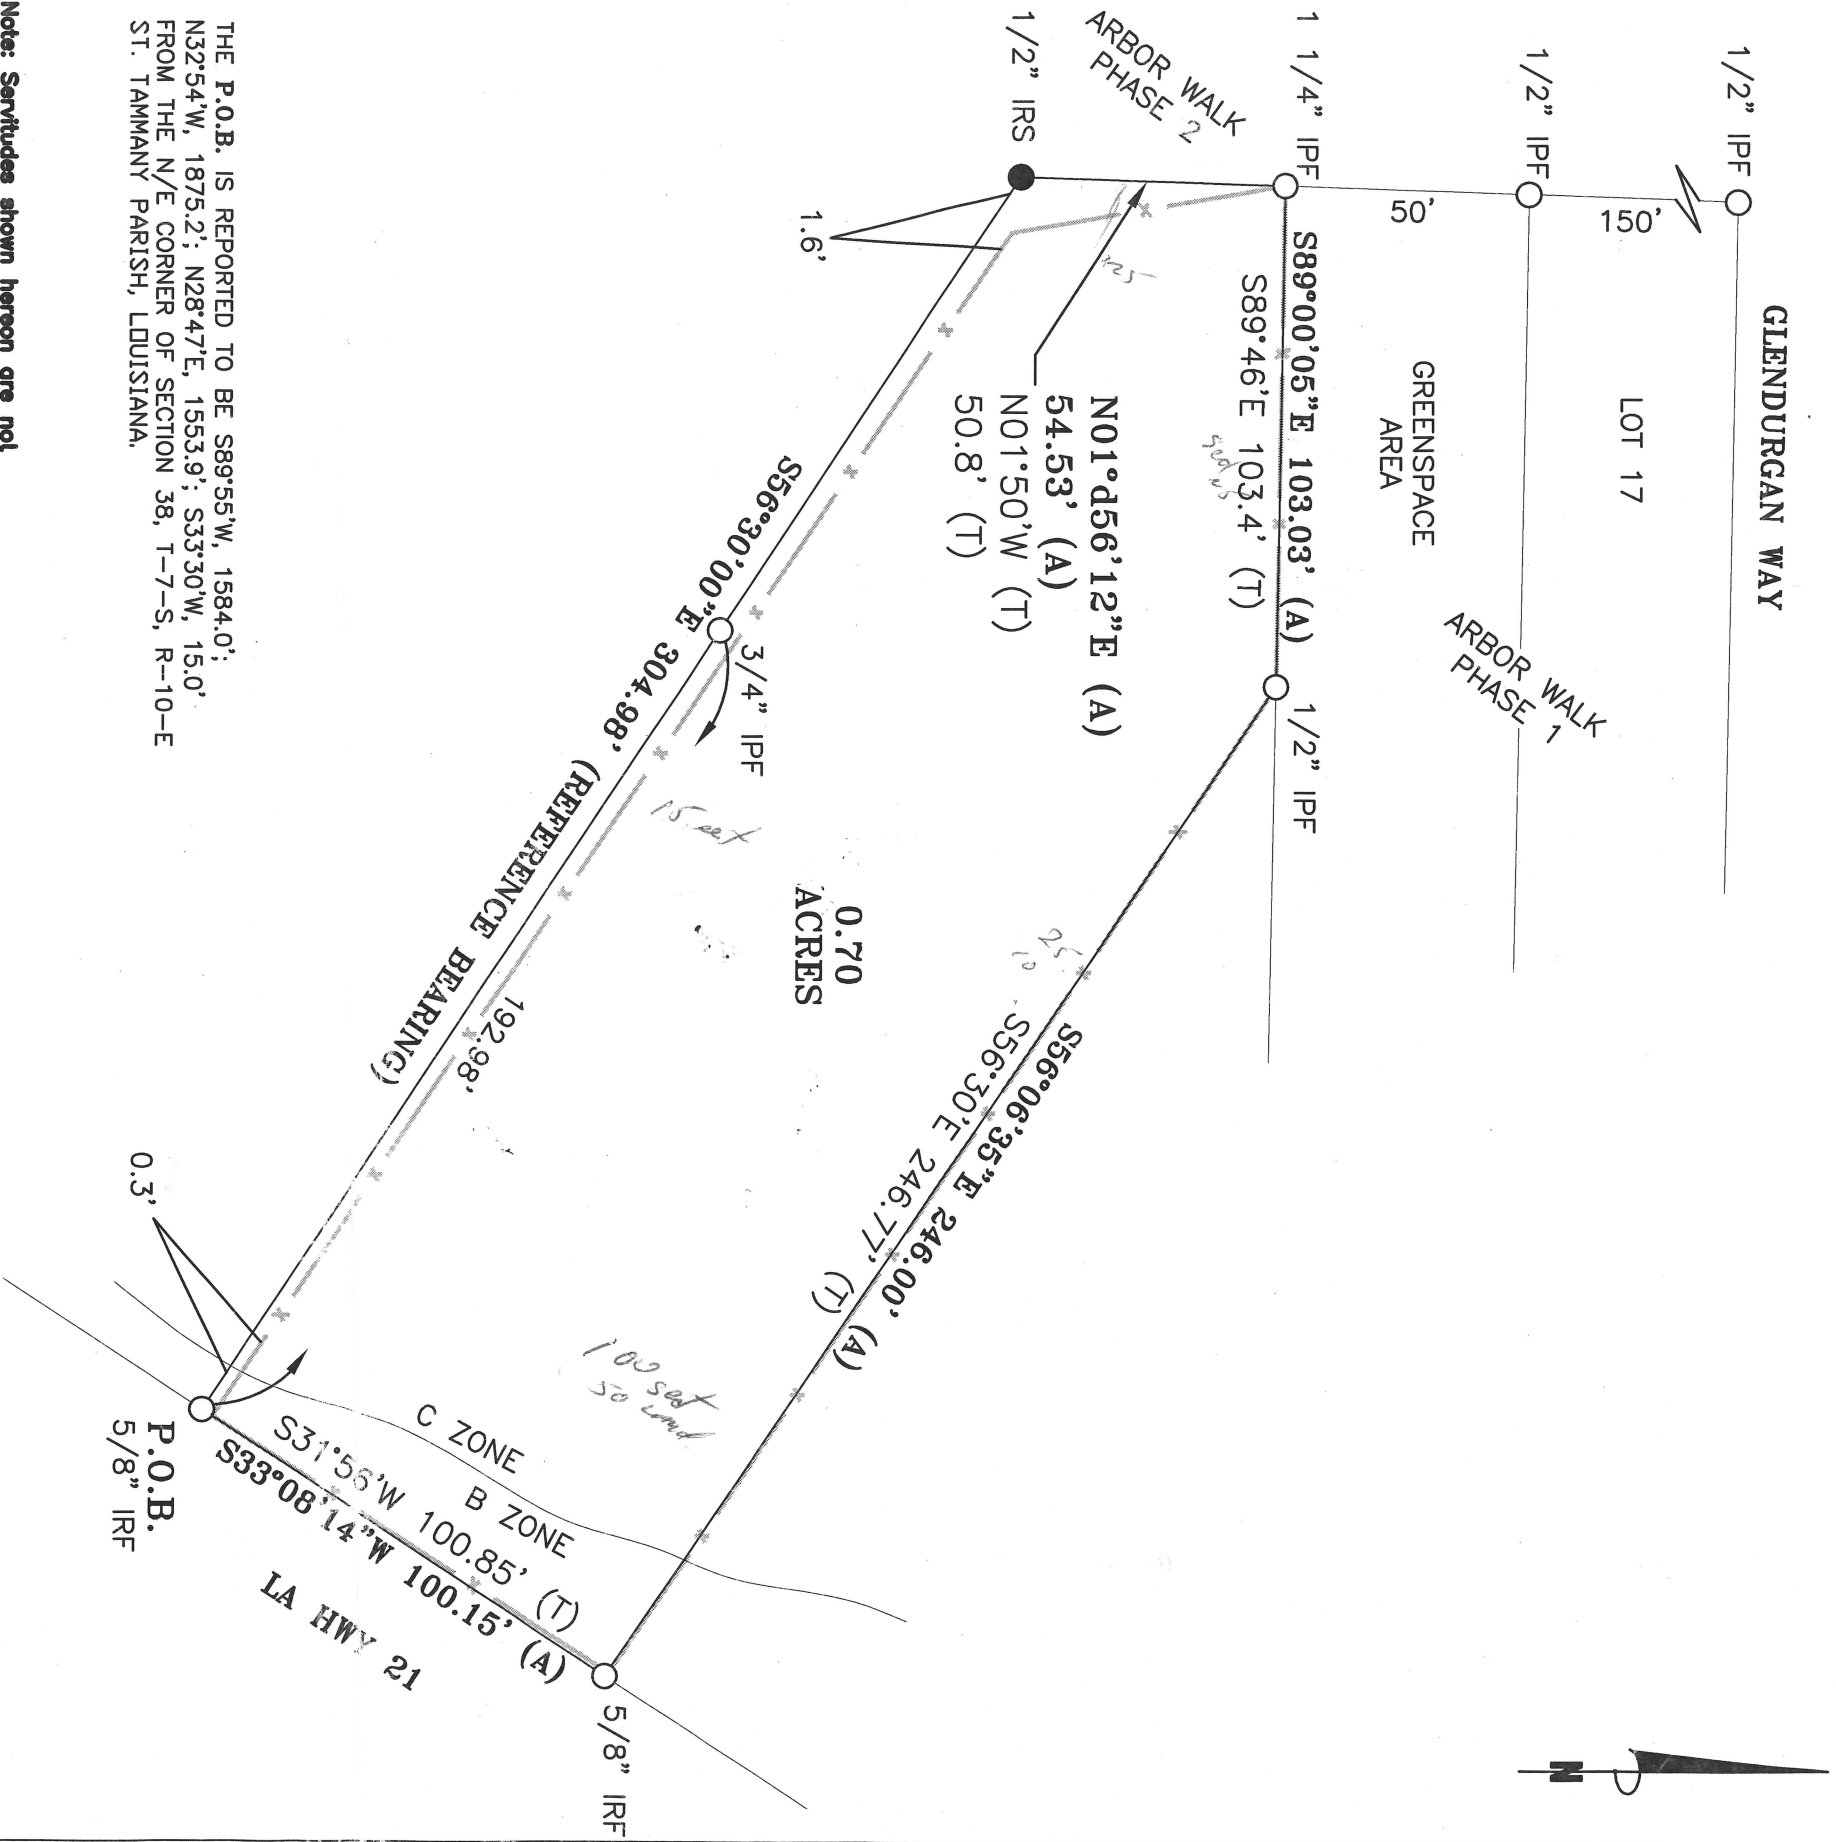

Note: Servitudes shown hereon are not necessarily exclusive. Servitudes of record as shown on title opinion or title policy will be added hereto upon request, as surveyor has not performed any title search or abstract.

Note: This is to certify that I have consulted the Federal Insurance Administration Flood Hazard Boundary Maps and found the property described is located in Flood Zone(s) "B & C" in accordance with Community Base Flood Elevation of N/A

Panel No. 225205 0220 C : Revised: 04/02/91

This is to certify that I have done an actual ground survey and found that no encroachments exist either way across any property lines except as shown.

NOTE: Setback lines shall be verified by owner or contractor prior to any construction, as an abstract has not been performed by the undersigned.

THIS IS TO CERTIFY THAT THIS SURVEY WAS DONE UNDER MY DIRECT SUPERVISION AND CONTROL; AND THAT THE SURVEY WAS DONE ON THE GROUND AND IS IN ACCORDANCE WITH THE "MINIMUM STANDARDS FOR PROPERTY BOUNDARY SURVEYS" AS ADOPTED BY THE STATE OF LOUISIANA, BOARD OF REGISTRATION FOR PROFESSIONAL ENGINEERS AND LAND SURVEYORS FOR A CLASS "C" SURVEY.

SURVEY MAP OF

0.70 ACRE PARCEL OF LAND IN
SECTION 41, T-7-S, R-10-E,

St. Tammany Parish, Louisiana
for

PAUL HODGINS

Survey No. 2006 1025
Date: 08/01/06

Drawn by: JBM
Revised:

Scale: 1" = 50'

This Survey is Certified
True and Correct By

JOHN E. BONNEAU & ASSOCIATES, INC.
Professional Land Surveyors
1011 N. CAUSEWAY BLVD.-SUITE 34 MANDEVILLE, LA. 70471 (985)626-0808
SUDELL (985)643-2508 MANDEVILLE (985)626-3546 NEW ORLEANS (504)456-2042
HAMMOND (985)345-7641 FAX NO. (985)626-0057 E-MAIL: JEBCO1@BELL SOUTH.NET

John E. Bonneau
Professional Land Surveyor
Registration No. 4423