
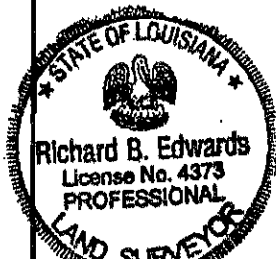


SQUARE 441
FIRST DISTRICT - NEW ORLEANS
ORLEANS PARISH, LA.

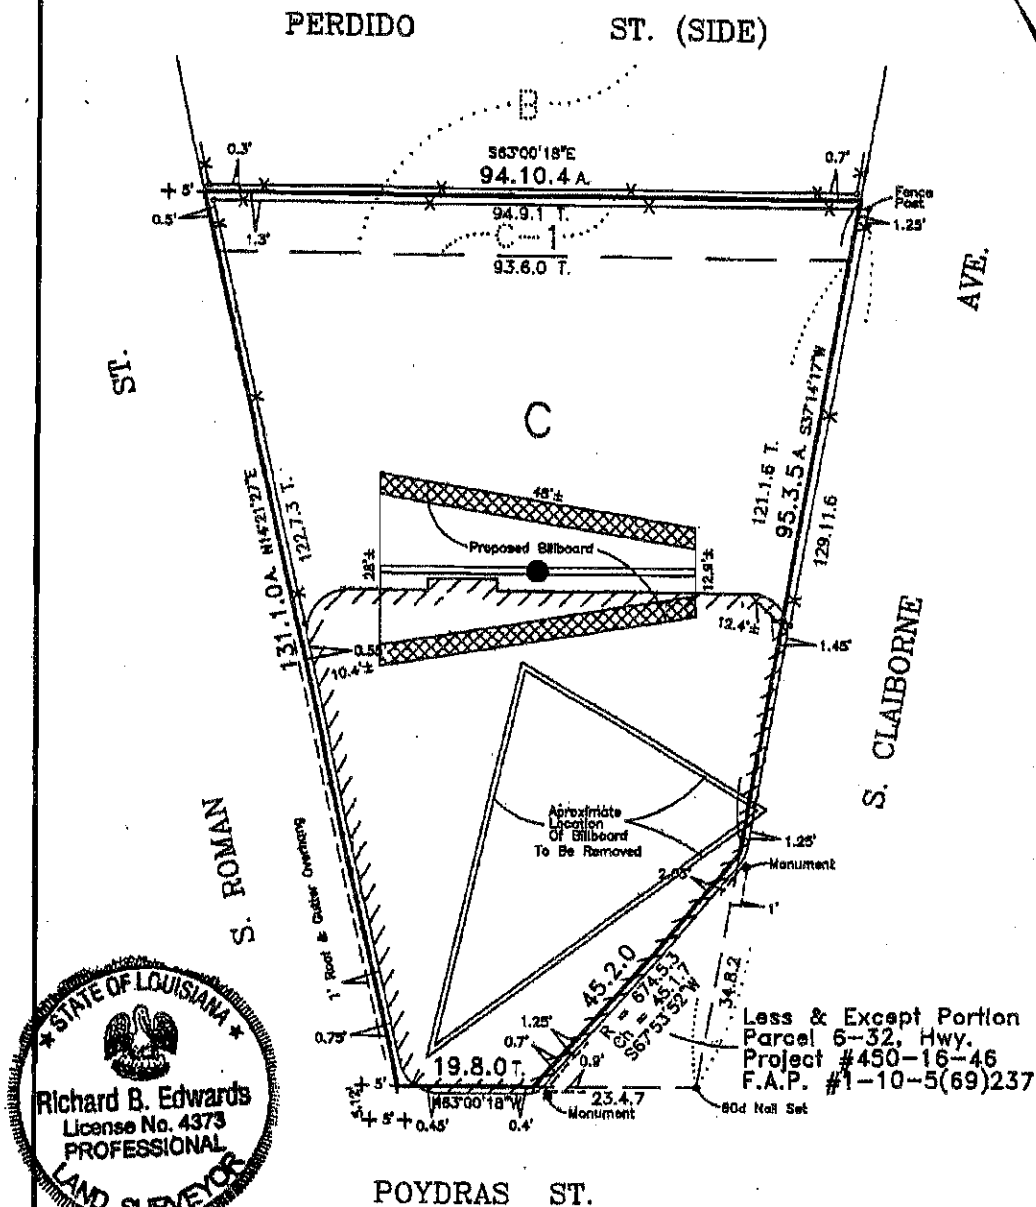

† Denotes Cross Out
Bearings As Per Survey Of Parcel 6-32 by
Dorinda Kuhn & Associates dated 12/2/1984

THE SERVICES AND RESTRICTIONS SHOWN ON THIS SURVEY ARE LIMITED TO THOSE SET FORTH IN THE DESCRIPTION FURNISHED US AND THERE IS NO REPRESENTATION THAT ALL APPLICABLE SERVICES AND RESTRICTIONS ARE SHOWN HEREON. THE SURVEYOR HAS MADE NO TITLE SEARCH OR PUBLIC RECORD SEARCH IN COMPILING THE DATA FOR THIS SURVEY. IMPROVEMENTS MAY NOT BE TO SCALE FOR CLARITY. THE DIMENSIONS SHOWN PREPARE OVER SCALE.

May 17, 2011
SURVEY CERTIFIED TO: ~~NEW ORLEANS~~ - New Orleans

I certify that this plot represents an actual ground survey made by me or under my direct supervision surveyed as per the written property description furnished us; in accordance with the Louisiana "Minimum standards for property boundary surveys" for a class C survey.

BY

[Signature]

MANDLE-EDWARDS SURVEYING, INC.
LAND SURVEYORS JEFFERSON, LA.

SCALE 1"=20'