



DATE  
12/19/2003

03343  
JOB NO.

JEWELI.GCD


A NEW RETAIL FACILITY  
FOR

**ARMENTOR JEWELERS**

CORNER OF WELDON ST. & DALE ST. NEW IBERIA, LA.

**A.O. architect, L.L.C.**

205 VALLEY VIEW DRIVE  
LAFAYETTE, LA. 70501  
337-237-3300

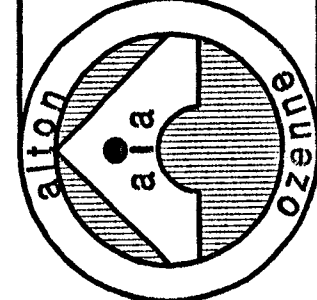


SHEET

A-1

1

15

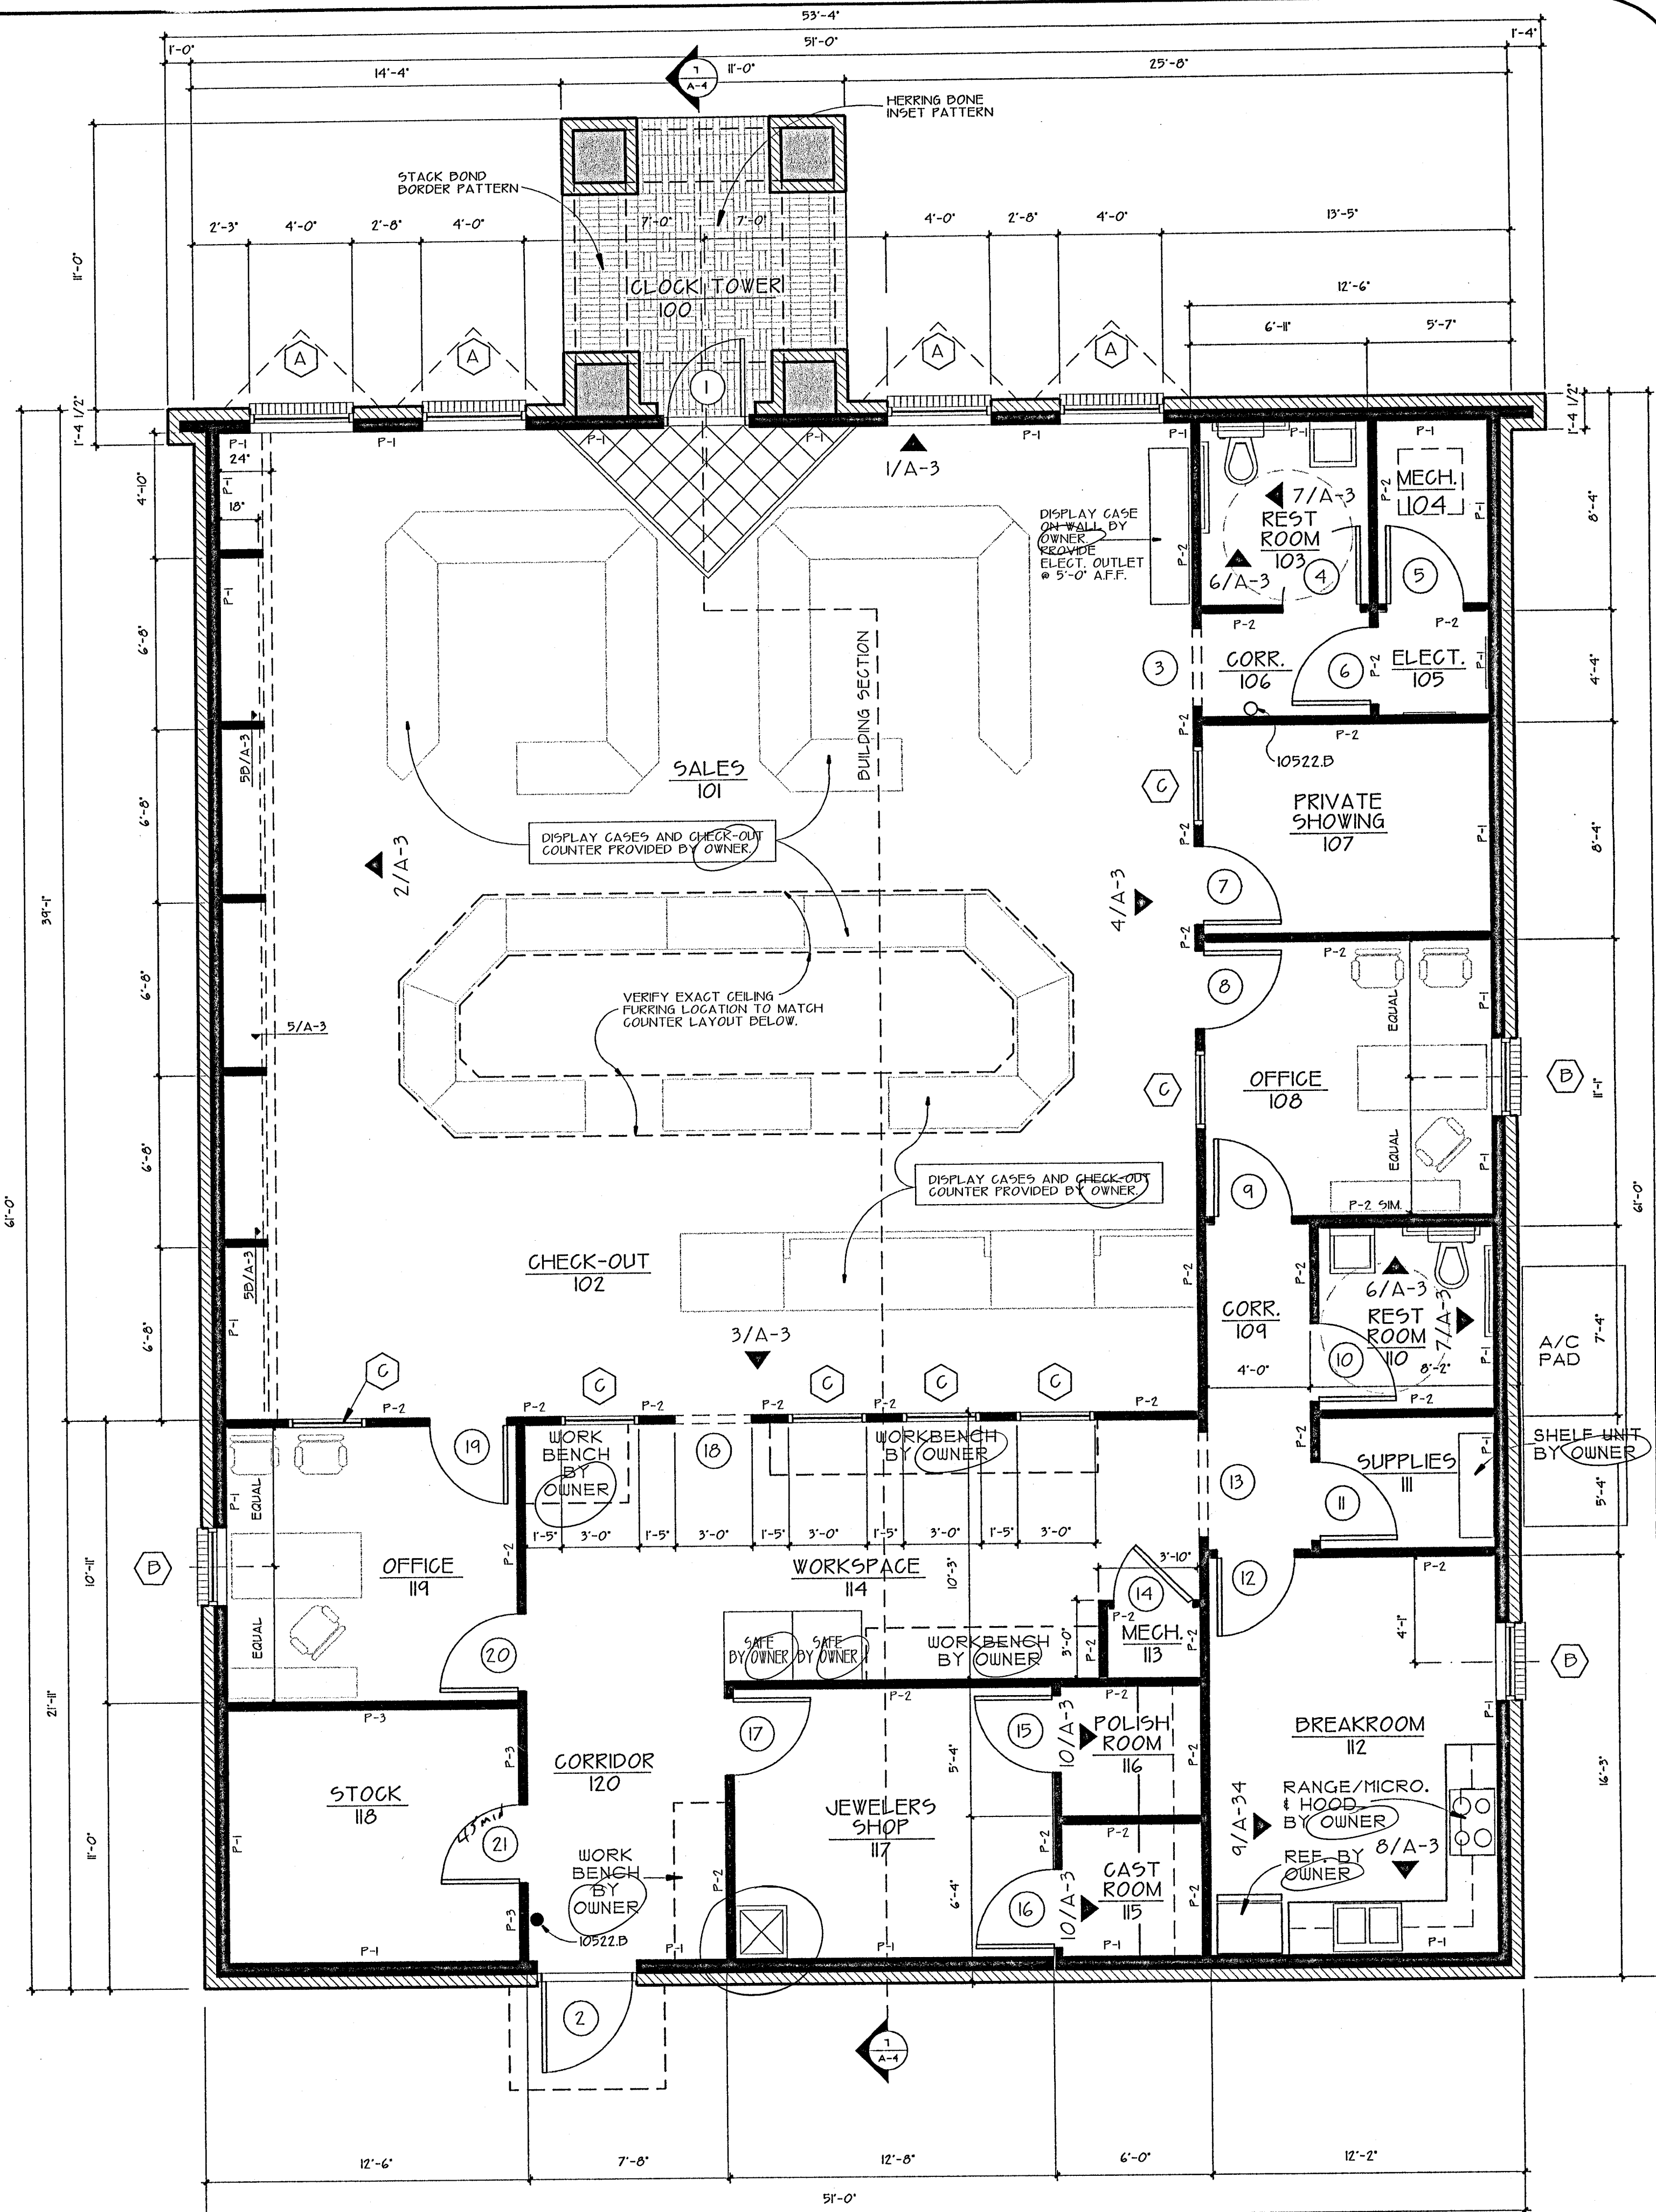

**1**  
A-1 **ARCHITECTURAL FLOOR PLAN**  
SCALE: 1/4" = 1'-0"