


GRUNER ROAD (SIDE)

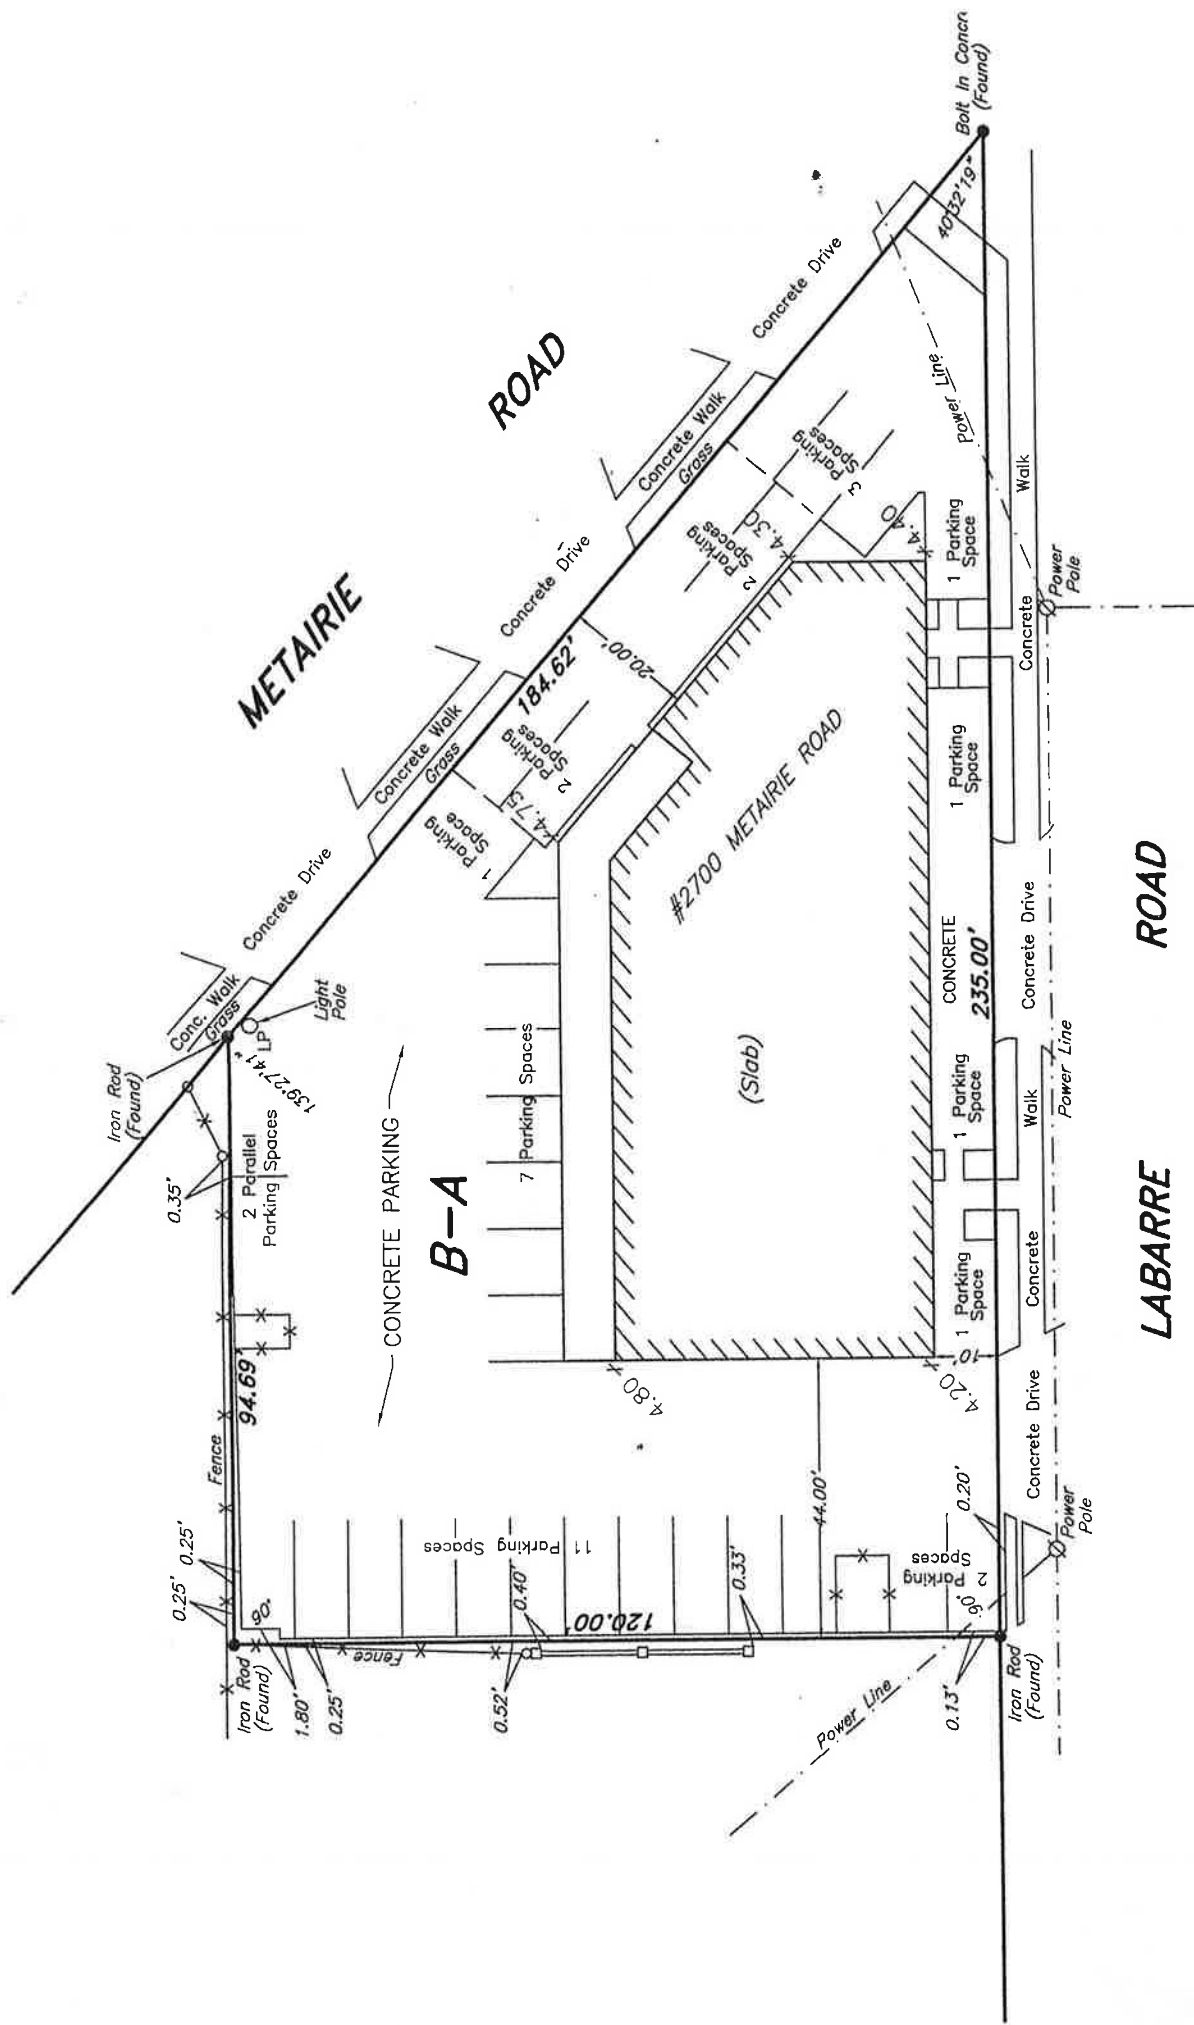

TOTAL NUMBER OF PARKING SPACES = 34

TES
TO THOSE FURNISHED US AND THERE IS




LOT